


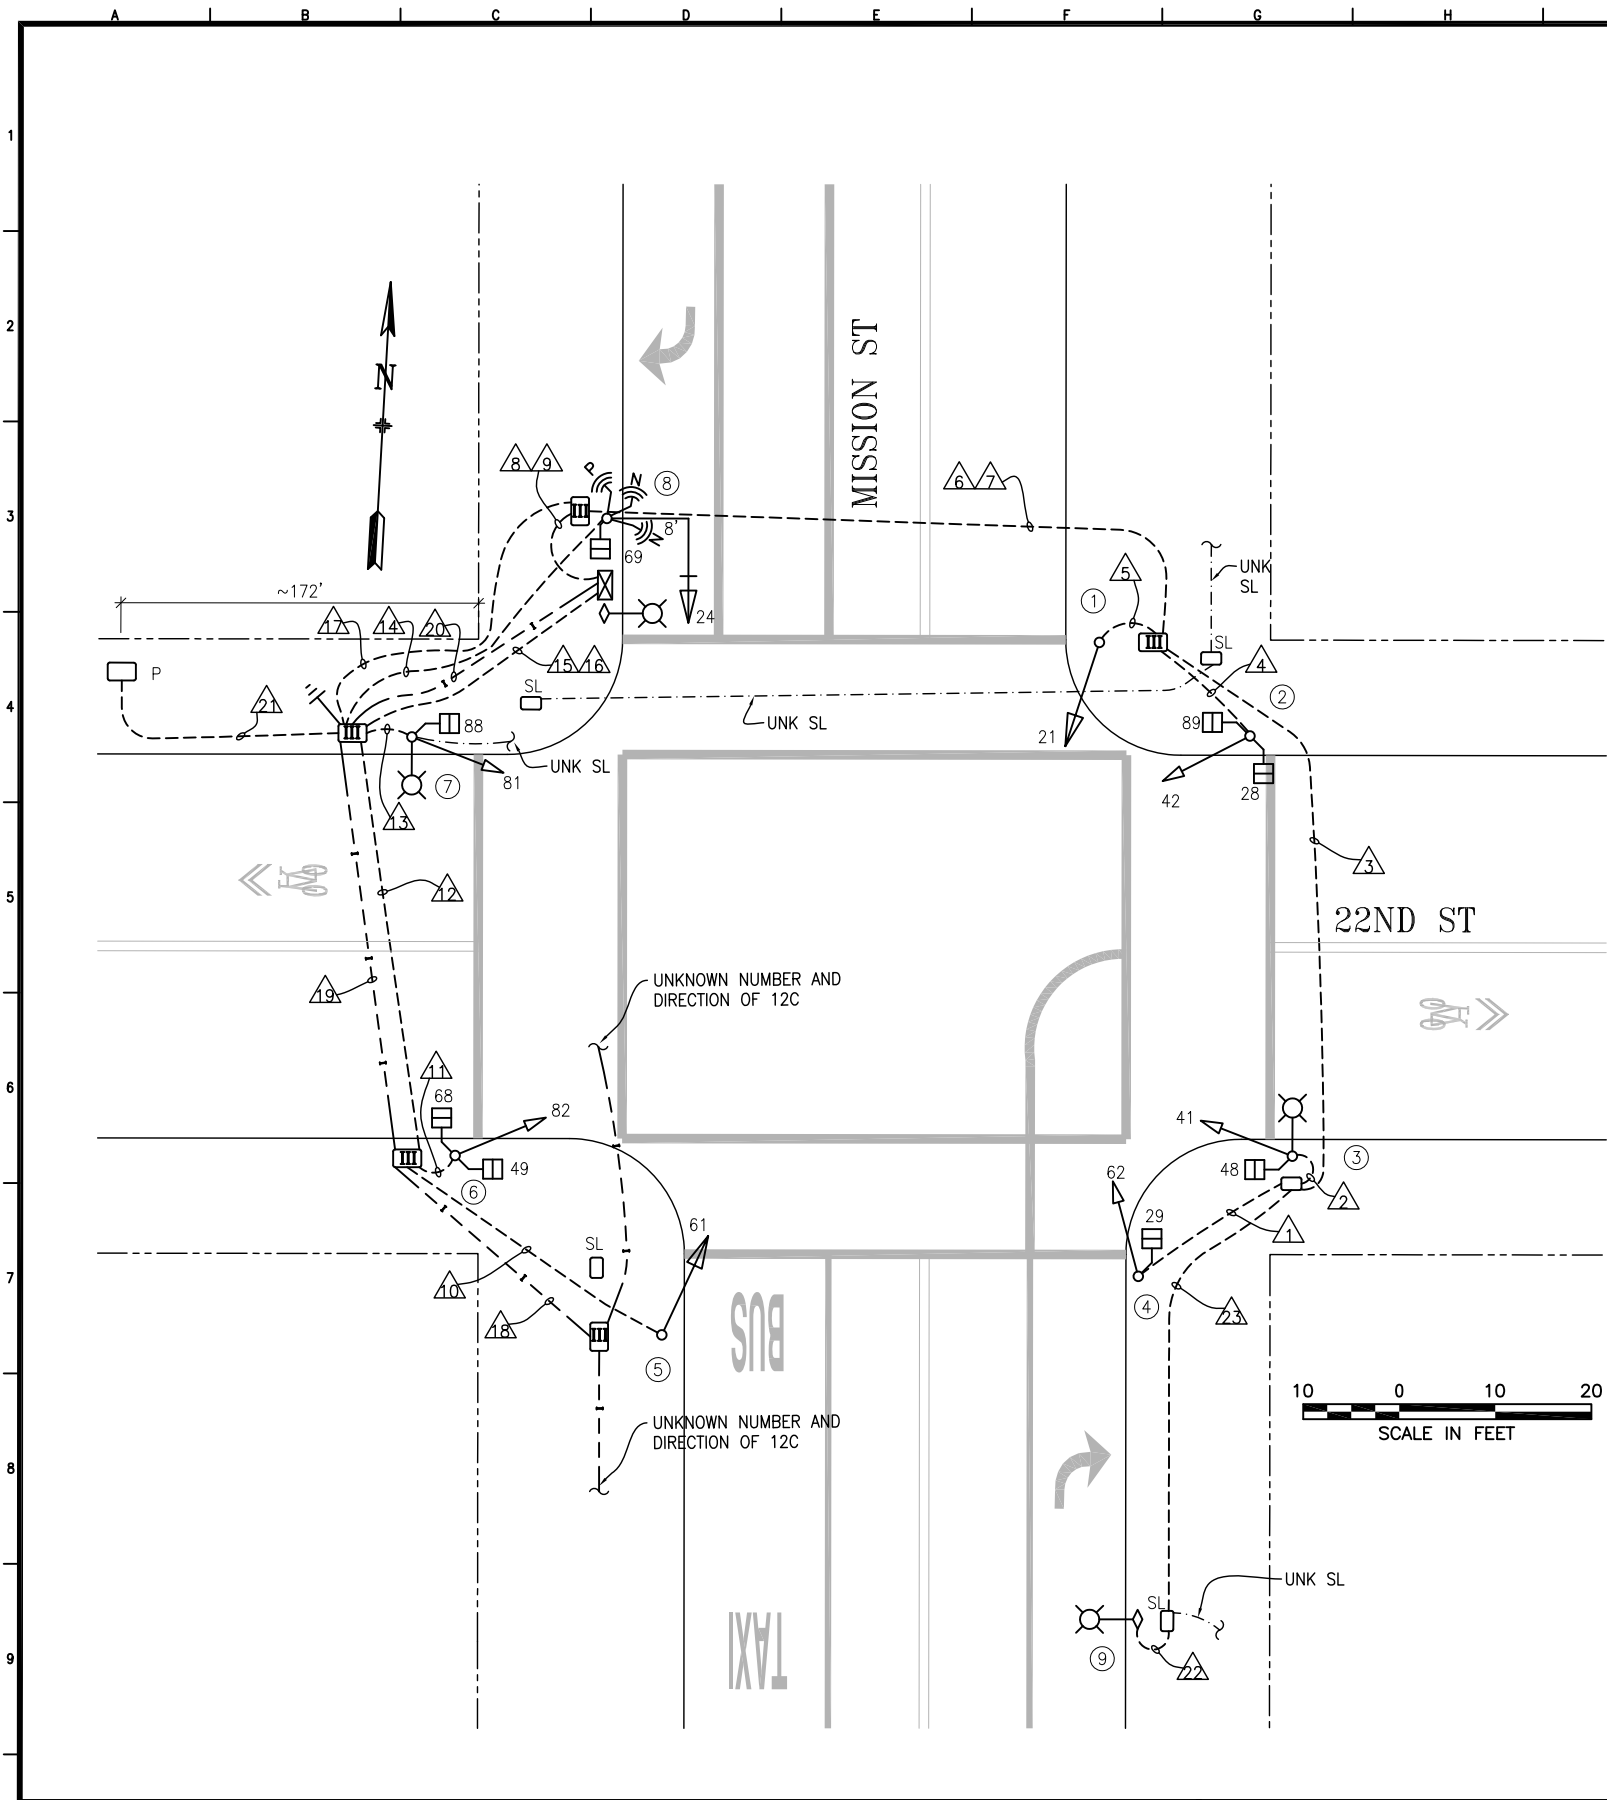

POLE AND EQUIPMENT SCHEDULE											
POLE No.	TYPE OF POLE	LUMINAIRE TYPE	VEHICLE SIGNAL					PEDESTRIAN SIGNAL			REMARKS
			No.	TYPE	MOUNTING	VISORS	LOUVERS/BP	No.	TYPE	MOUNTING	
①	1-A (10')		21	3S12"	TV-1-T	T					
②	1-A (10')		42	3S8"	TV-1	T		28 89	1S-C 1S-C	SP-1 SP-1	
③	STREETLIGHT		41	3S8"	SV-1-T	T		48	1S-C	SP-1	
④	1-A (10')		62	3S8"	TV-1	T		29	1S-C	SP-1	
⑤	1-A (10')		61	3S12"	TV-1-T	T					
⑥	1-A (10')		82	3S8"	TV-1	T		49 68	1S-C 1S-C	SP-1 SP-1	
⑦	STREETLIGHT		81	3S8"	SV-1-T	T		88	1S-C	SP-1	
⑧	16-1-70 W/ 8' MA		24	3S12"	MAS-SF	T	BP	69	1S-C	SP-1	NETWORK RADIO NETWORK RADIO TSP RADIO
⑨	MUNI POLE W/ DECORATIVE LUMINAIRE AND POLE SKIRT										TSP INFRARED RECEIVER (NOT IN USE)

MAS-SF = MAST ARM PLUMBIZER BETWEEN YELLOW AND GREEN BALL

8/10/23	UPDATE PER FIELD: UPDATE TSP/NETWORK EQUIP, MAS-SF & M-SF. 21/61 ARE 3S12"	D. YEUNG	G. DE LEON		
7/31/08	CONVERTED FROM CONTRACT 0944J(R) AS-BUILTS	D. YEUNG	G. DE LEON		
NO.	DATE	DESCRIPTION	BY	APPROVED	
TABLE OF REVISIONS					
CHECKOUT DRAWING THROUGH THE SID CUSTODIAN FOR THE LATEST REVISION					



SFMTA

DRAWN BY: D. YEUNG	DATE: MAR 2023
CHECKED BY: G. DE LEON	DATE: MAR 2023

SCALE AS SHOWN
SHEET OF SHEETS 1 OF 2

TRAFFIC SIGNAL INVENTORY DIAGRAM
22ND ST AND MISSION ST

CNN NO: 24111000
REV NO: 1

