


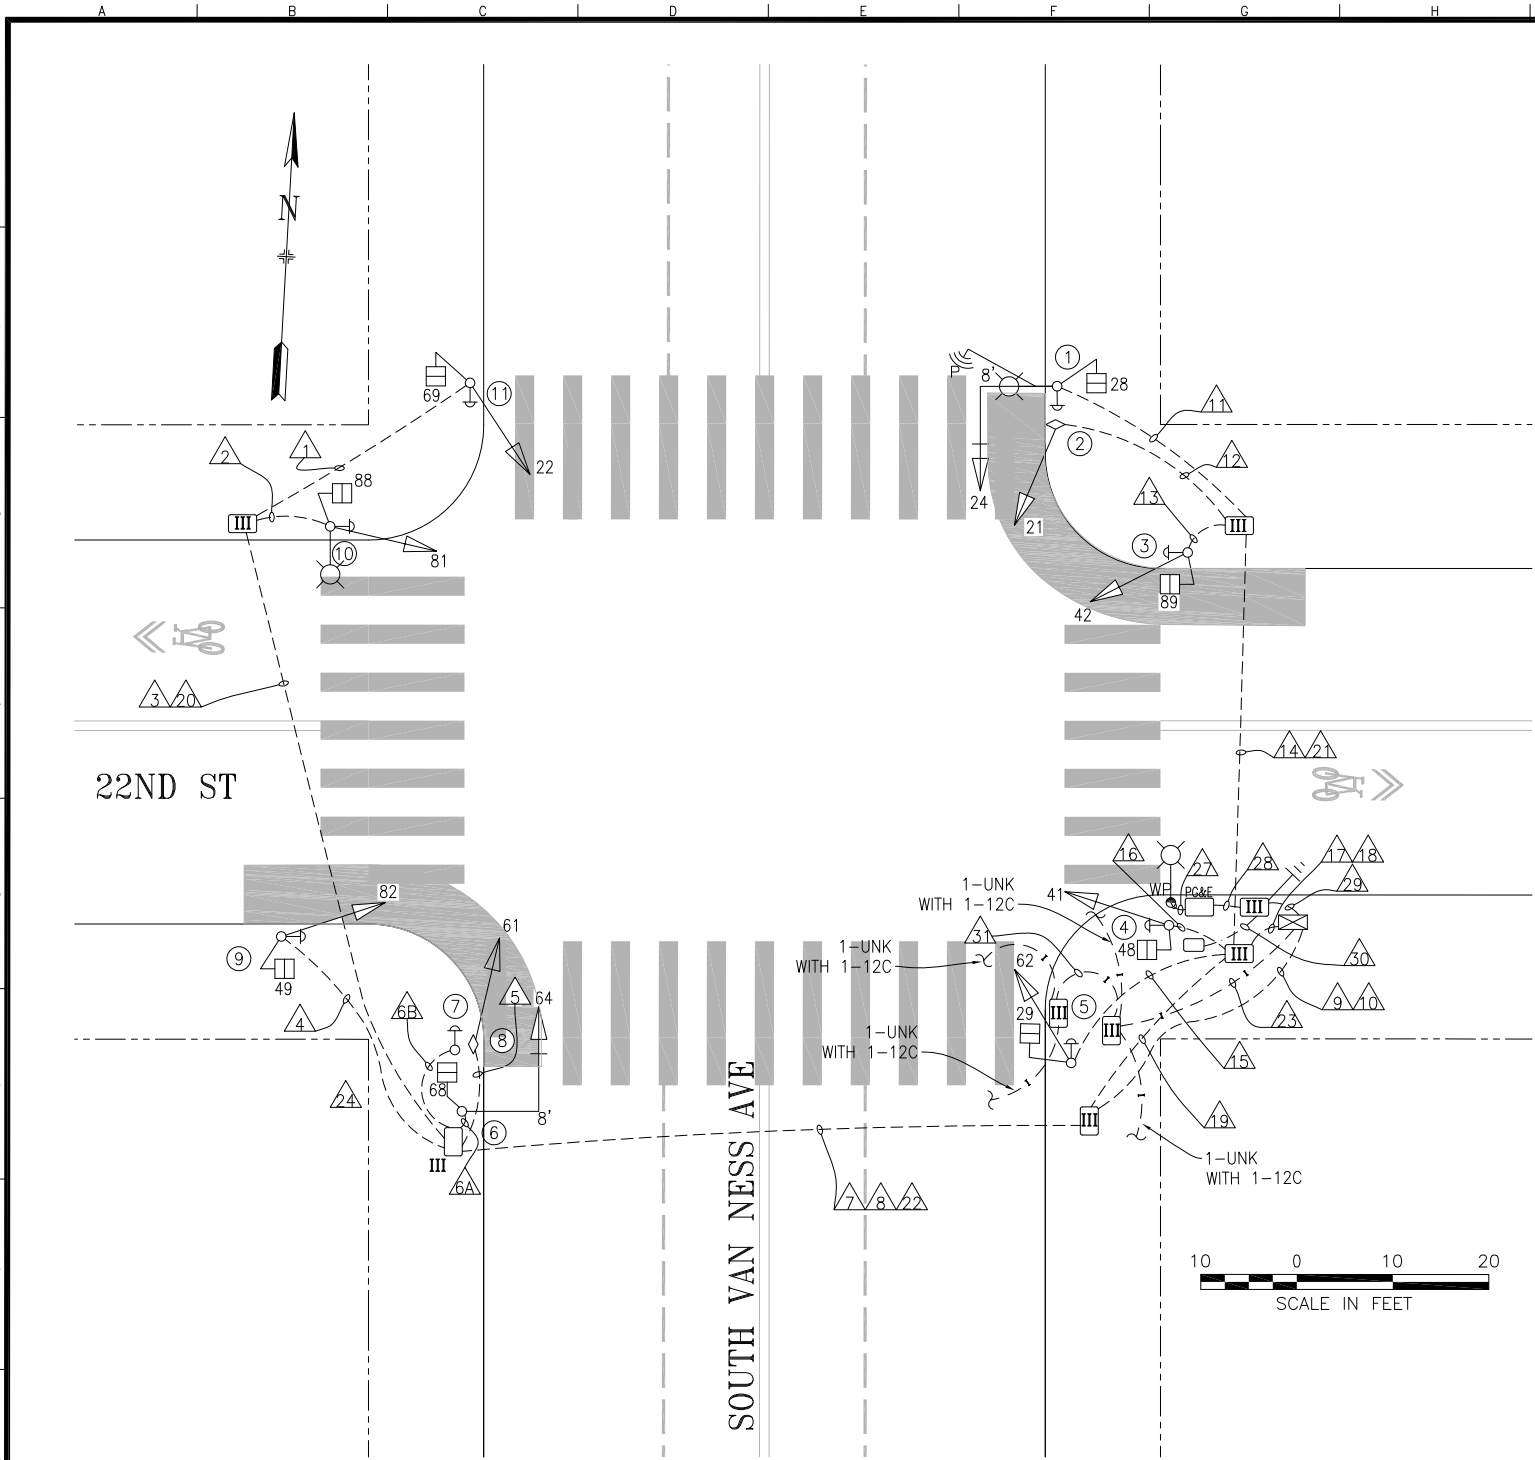

POLE AND EQUIPMENT SCHEDULE												
POLE No.	TYPE OF POLE	LUMINAIRE TYPE	VEHICLE SIGNAL				PEDESTRIAN SIGNAL				ITS DEVICE	REMARKS
			No.	TYPE	MOUNTING	VISORS	LOUVERS/BP	No.	TYPE	MOUNTING	BUTTON	
①	17-2-100 W/ 8' MAST ARM & 6' LUM ARM		24	3S12"	MAS ◊1	T	BACKPLATE	28	1S-COUNT	SP-1 (22")	APS-2W	PREEMPT RADIO
②	EX. MUNI POLE W/ 6' LA		21	3S12"	SV-1-T	T						EXTERNAL CONDUIT
③	1-A (10')		42	3S12"	TV-1-T	T		89	1S-COUNT	SP-1	APS-2W	
④	1-A (10')		41	3S12"	TV-1-T	T		48	1S-COUNT	SP-1	APS-2W	
⑤	1-A (10')		62	3S12"	TV-1-T	T		29	1S-COUNT	SP-1	APS-2W	
⑥	16-2-100 W/ 8' MAST ARM		64	3S12"	MAS ◊1	T	BACKPLATE	68	1S-COUNT	SP-1 (22")		
⑦	PPB POLE										APS-2W	
⑧	MUNI POLE		61	3S12"	SV-1-T	T						EXTERNAL CONDUIT
⑨	1-A (10')		82	3S12"	TV-1-T	T		49	1S-COUNT	SP-1	APS-2W	
⑩	CITY STANDARD STREETLIGHT W/ 6' LA		81	3S12"	SV-1-T	T		88	1S-COUNT	SP-1	APS-2W	
⑪	1-A (10')		22	3S12"	TV-1-T	T		69	1S-COUNT	SP-1 (22")	APS-2W	MOUNT 22 ON BUILDING SIDE

SHEET NOTES:
◊1 PLUMBIZER IS MOUNTED BETWEEN YELLOW AND GREEN SECTIONS

2	7/01/22	SRC 2022-067: ADDED PREEMPT RADIO	JLee	LVentura
1	7/21/21	BOX/CONDUIT UPDATES AT SE CORNER PER 2823J AS-BUILTS	DYeung	GdeLeon
0	1/10/19	SIGNAL UPGRADE ACTIVATED THROUGH 2823J	DYeung	GdeLeon
NO.	DATE	DESCRIPTION	BY	APPROVED
TABLE OF REVISIONS CHECKOUT DRAWING THROUGH THE SID CUSTODIAN FOR THE LATEST REVISION				



SFMTA

DRAWN BY: DYeung CHECKED BY: GdeLeon	DATE: 9/2021 DATE: 9/2021	SCALE AS SHOWN	TRAFFIC SIGNAL INVENTORY DIAGRAM	CNN NO: 24081000
		SHEET OF SHEETS 1 OF 2		REV NO:
			22ND STREET AND SOUTH VAN NESS AVENUE	2

