



Signals activated through CT 46 on 10/15/1996

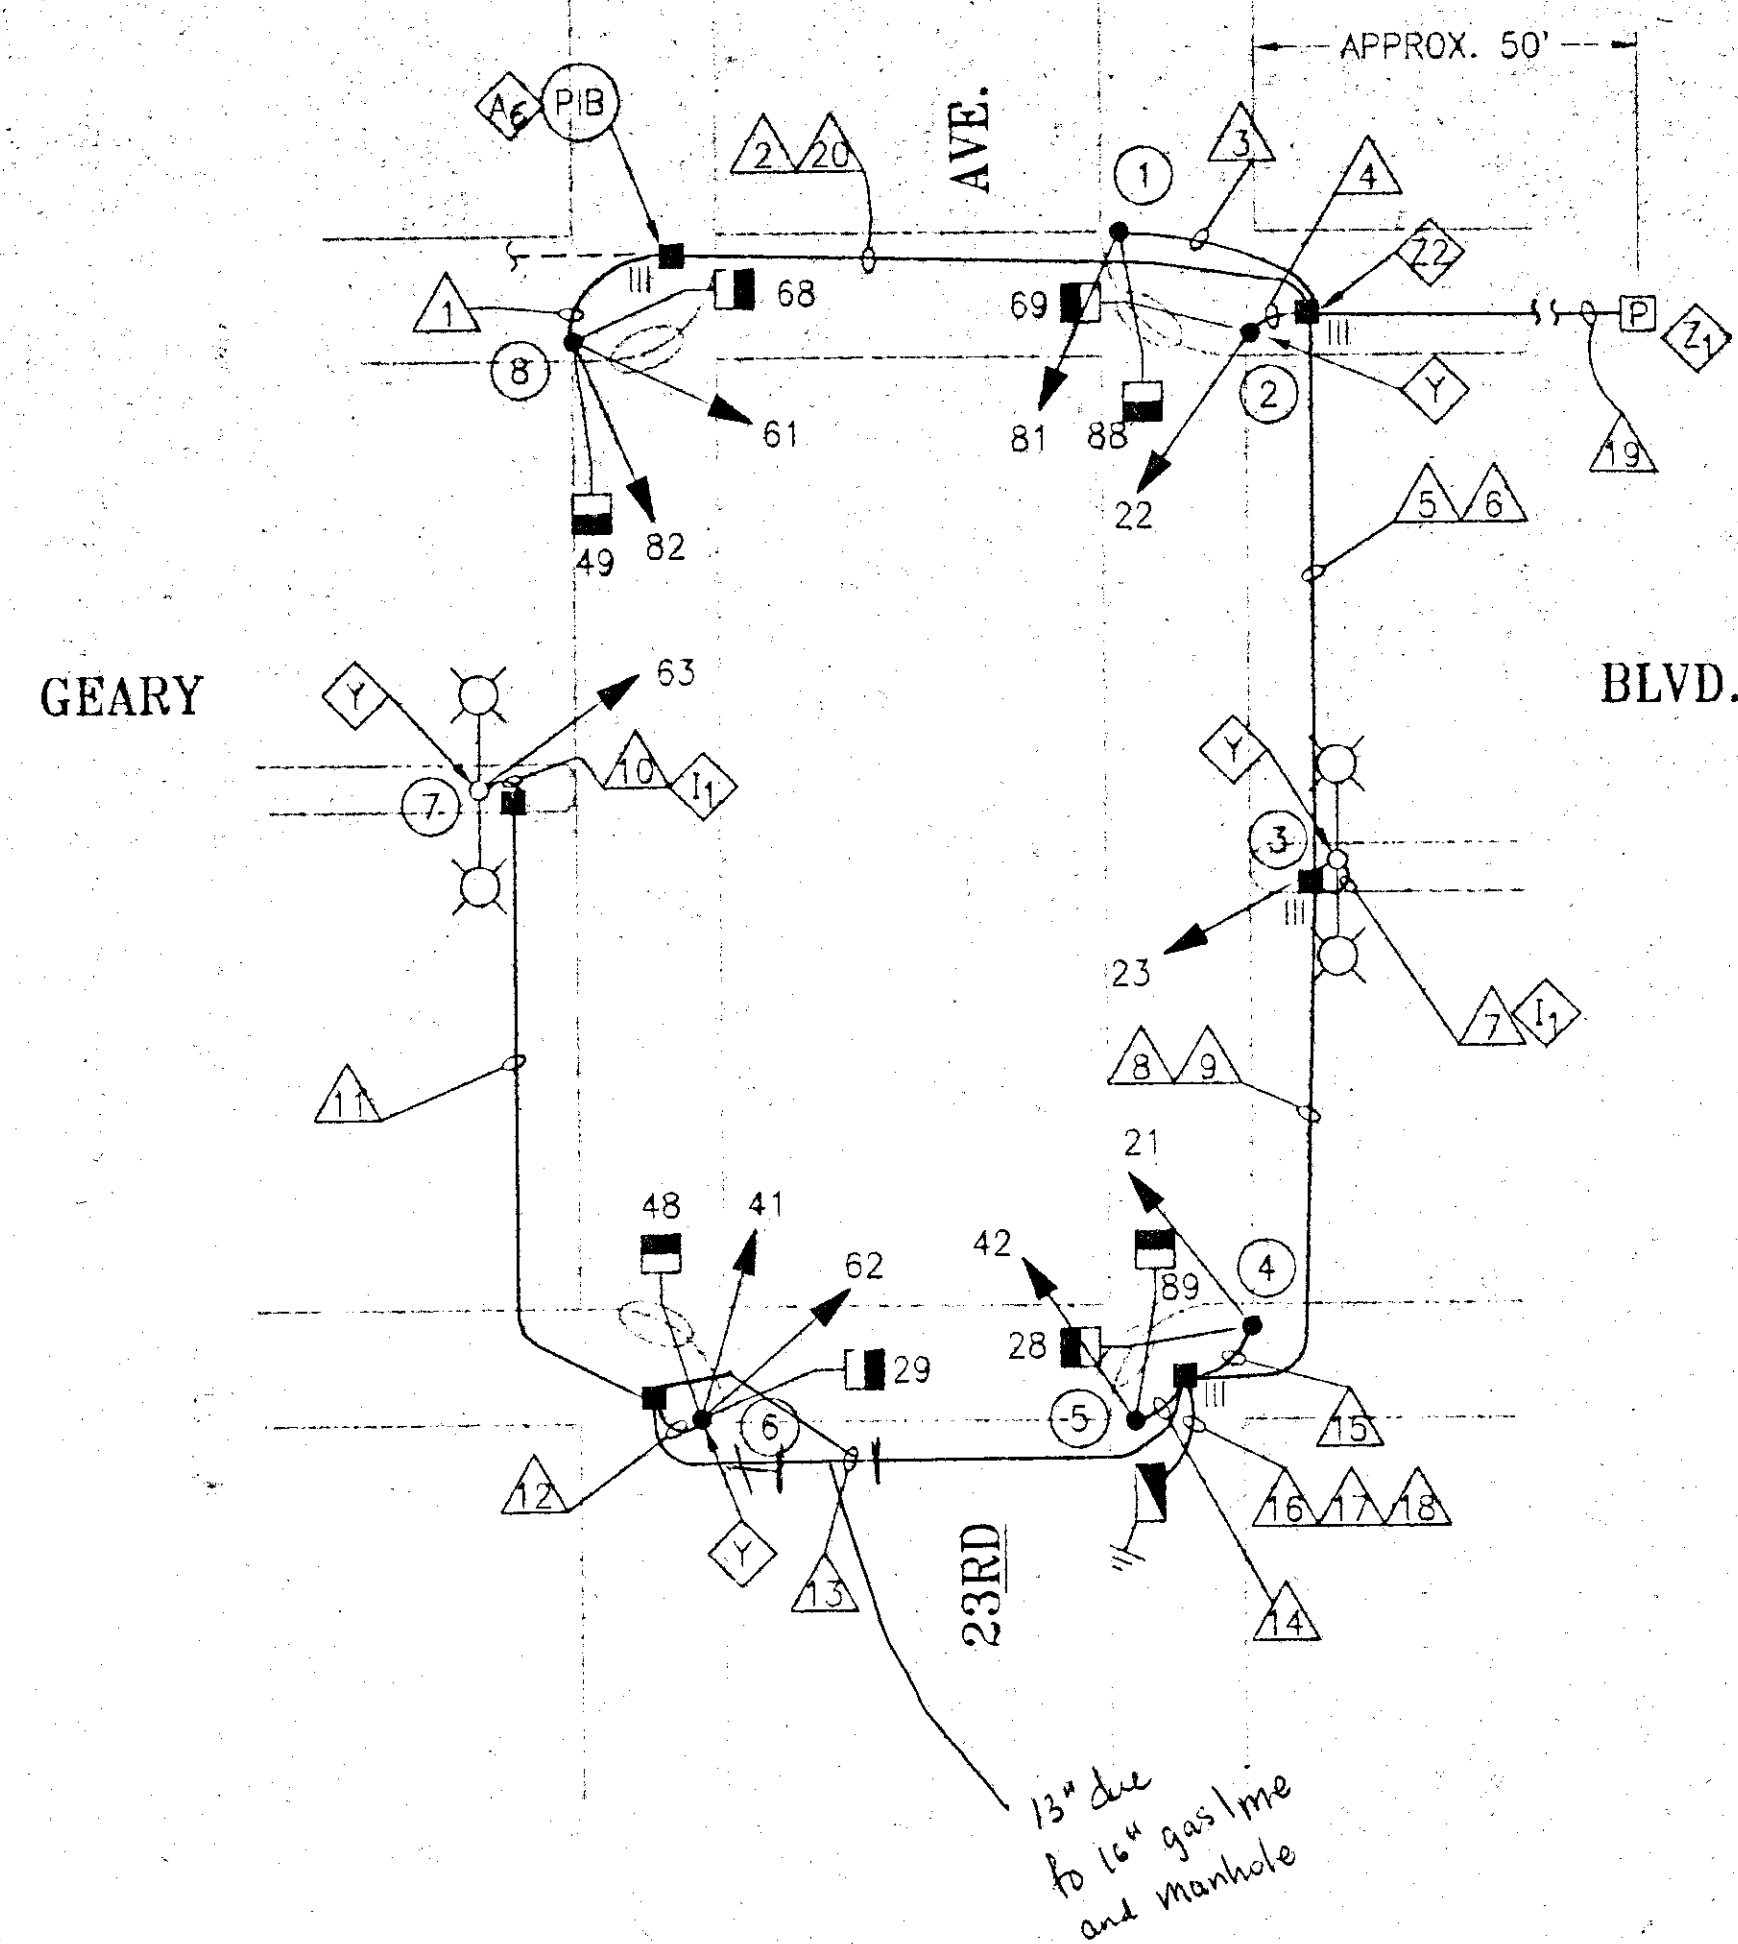

PHASE DIAGRAM

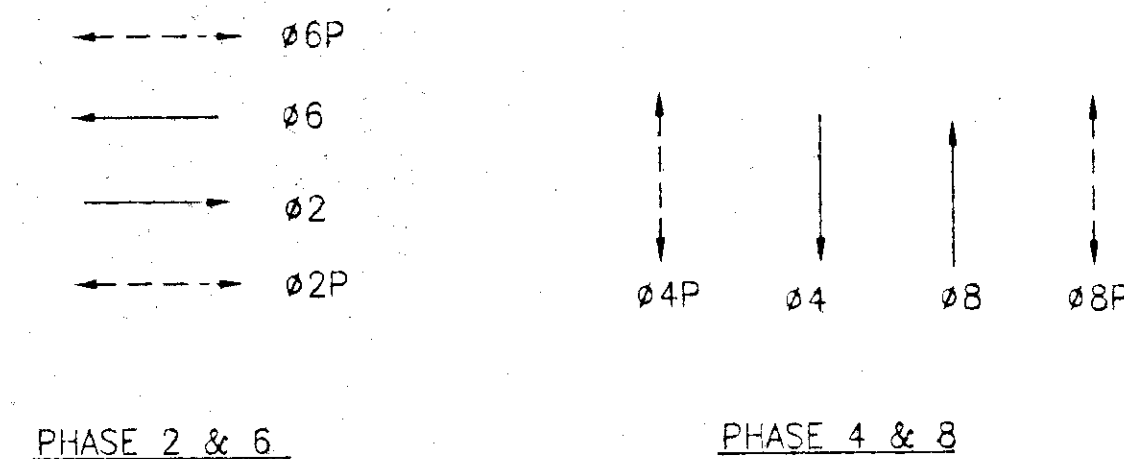

PHASE SEQUENCE

G	Y	R
R		G
RH		WM
WM	FRH	RH

GEARY BLVD
23RD AVE
PED XING GEARY BLVD
PED XING 23RD AVE

SHEET NOTE

- FOR CONDUITS, WIRING, POLES AND EQUIPMENT SCHEDULE, SEE DWG E-10.

DETAIL NOTES

- EX CONDUITS TO REMAIN.
- F/I NEW TRAFFIC SIGNALS TO EX STREET LIGHT POLE. CHIP EX FOUNDATION AS REQUIRED TO RUN NEW CONDUIT EXTERNAL TO THE POLE. SEE DETAIL 1-4.
- "LEFT TURN YIELD ON GREEN BALL" SIGN TO BE INSTALLED BY CITY FORCES.
- P.G. & E. SERVICE HANDHOLE.
- PROVIDE 40A IN-LINE FUSE & FUSE HOLDER IN PULL BOX.

PLANS ARE TO BE RETURNED WITH CORRECTIONS MADE AND CERTIFIED TO IN RED INK AND DATED BY THE INSPECTOR IN CHARGE UPON COMPLETION OF THE WORK BEFORE FINAL PAYMENT CAN BE MADE.

SIGNED: *[Signature]* 11/15/95 INSPECTOR

KING C. ELECTRIC, INC.
4218 BALBOA STREET
SAN FRANCISCO, CA 94121



NO. DATE DESCRIPTION BY APP. CHECK WITH TRACING TO SEE IF YOU HAVE LATEST REVISION		REFERENCE INFORMATION & FILE NO. OF SURVEYS		BUREAU OF ENGINEERING DEPARTMENT OF PUBLIC WORKS CITY AND COUNTY OF SAN FRANCISCO		DESIGNED: DS DATE: 11/13/95 DRAWN: JS/RT DATE: 11/13/95 CHECKED: <i>[Signature]</i> DATE: 11/15/95	APPROVED: <i>[Signature]</i> DATE: 11/15/95 SECTION MANAGER ADVISION MANAGER CITY ENGINEER	SCALE: 1" = 20'-0" SHEET OF SHEETS	VARIOUS LOCATIONS TRAFFIC SIGNAL IMPROVEMENTS CONTRACT 46 23RD AVE AND GEARY BLVD	SPECIFICATION NO. 1114N DRAWING NO. E-9 FILE NO. 63,406 REV. NO.
---	--	---	--	--	--	--	---	---------------------------------------	---	---

[illegible][illegible]

1. POLE SCHEDULE AS PER CALTRANS STANDARD SPECIFICATIONS EXCEPT THAT USING POLE CLAMP (U BOLT TYPE), IN LIEU OF POLE PLATES FOR MOUNTING DETAILS.

1. F/I NEW TRAFFIC SIGNALS TO EX STREET LIGHT POLE.
CHIP EX FOUNDATION AS REQUIRED TO RUN NEW CONDUIT
EXTERNAL TO THE POLE. SEE DETAIL 



Y "LEFT TURN YIELD ON GREEN BALL" SIGN TO BE INSTALLED
BY CITY FORCES.

SIGNED: Samuel C. Man 9/30/97
INSPECTOR

KING C. ELECTRIC, INC
4218 BALBOA STREET
SAN FRANCISCO, CA 94121



18

				REFERENCE INFORMATION & FILE No. OF SURVEYS		 <div style="text-align: center;"> BUREAU OF ENGINEERING DEPARTMENT OF PUBLIC WORKS CITY AND COUNTY OF SAN FRANCISCO </div>		DESIGNED: DATE: 11/13/95 DS		APPROVED 11/15/95 SECTION MANAGER DATE:		SCALE: NONE		SPECIFICATION NO. 1114N DRAWING NO. E-10	
								DRAWN: DATE: 11/13/95 EF/RT		11/24/95 DIVISION MANAGER DATE:		SHEET OF SHEETS		FILE NO. 63,407	
NO. DATE DESCRIPTION BY APP.						CHECKED: DATE: 11/95 HLR		11/23/95 CITY ENGINEER DATE:				SCHEDULE FOR 23RD AVE AND GEARY BLVD		REV. NO.	
TABLE OF REVISIONS CHECK WITH TRACING TO SEE IF YOU HAVE LATEST REVISION															