


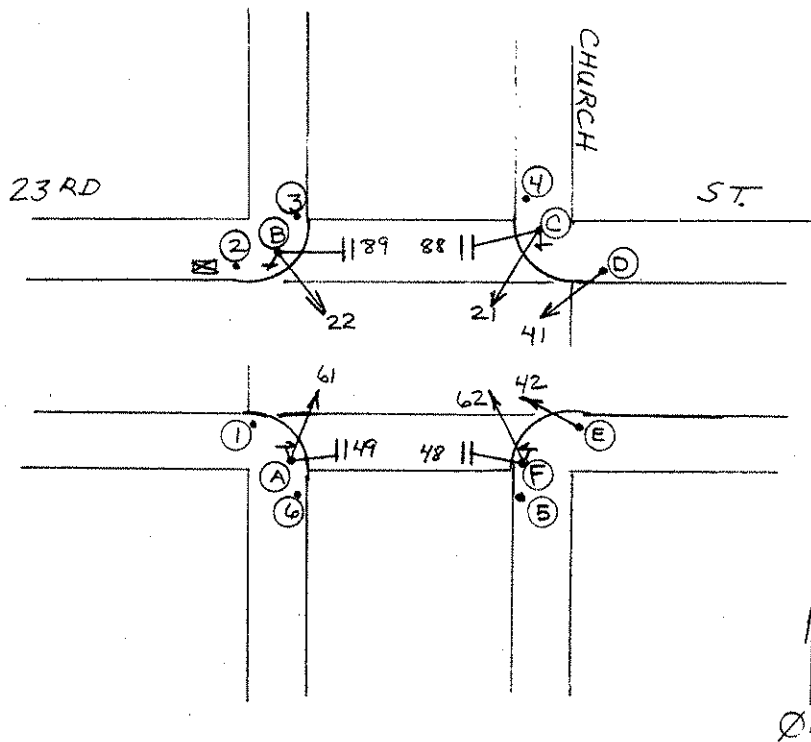

4-7-94

POLE	FUNC.	MAT'L	SIGNAL NO.	MAKE	NO. OF SECT.	SIZE	VISOR	B.P. OR LOUVERS	MOUN'T	PED SIGNAL NO.	LEGEND	MESSAGE		MAKE	MOUN'T
												ELEMENT	COLOR		
A	S	S	21	TCT	3	8"	FC8"	—	S	48	I	IS-I	W/OR	ICC	S
B	M	S	22	TCT	3	8"	FC8"	—	S	49	I	IS-I	W/OR	ICC	S
C	M	S	41	TCT	3	8"	FC8"	—	T	88	I	IS-I	W/OR	ICC	S
D	S	S	42	TCT	3	8"	FC8"	—	S	89	I	IS-I	W/OR	ICC	S
E	U	W	61	TCT	3	8"	FC8"	—	T						
F	U	W	62	TCT	3	8"	FC8"	—	S						
1	U	W													
2	U	W													
3	U	C													
4	U	C													
5	M	S													
6	M	S													

CONTROLLER CABINET SIZE : ORDINARY BASE CABINET: —

COMMENTS: CONTRACT 21