


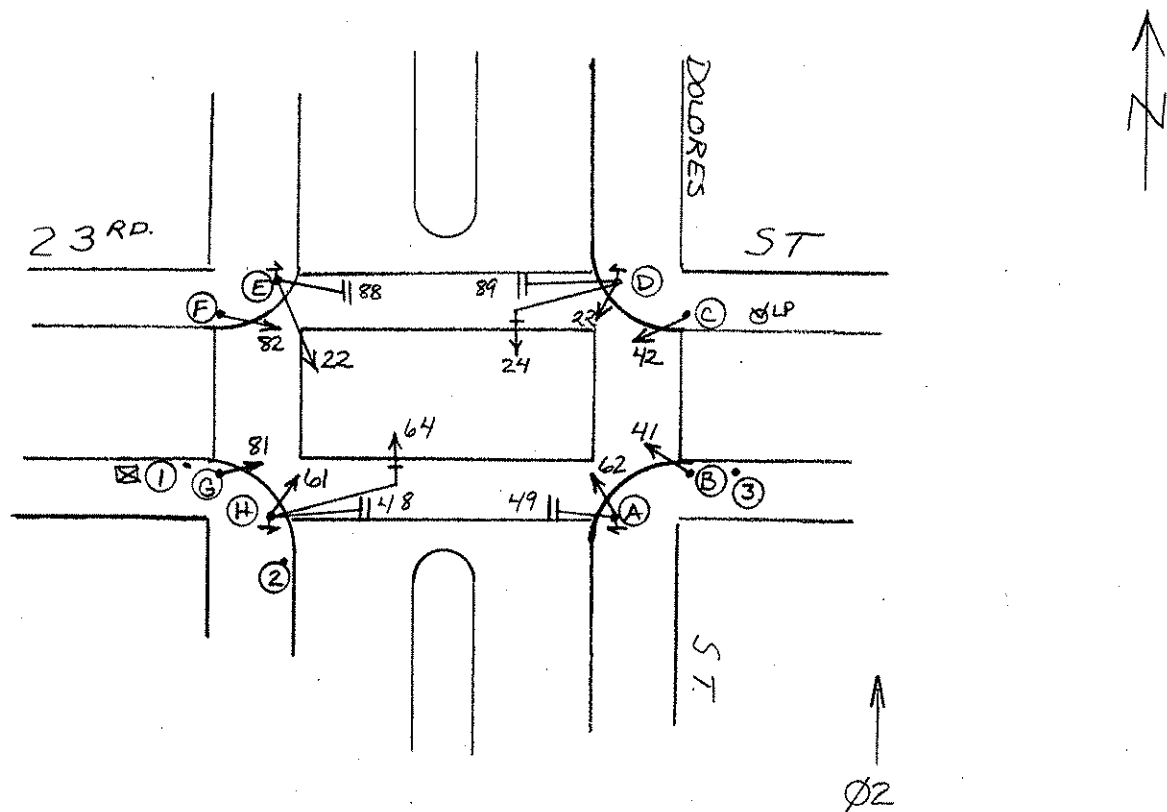

3-3-94

POLE	FUNC.	MAT'L	SIGNAL NO.	MAKE	NO. OF SECT.	SIZE	VISOR	B.P. OR LOUVERS	MOUN'T	PED SIGNAL NO.	LEGEND	MESSAGE		MAKE	MOUN'T
												ELEMENT	COLOR		
A	S	S	21	TCT	3	8"	FC 8"	-	S	48	I	15-1	W/OR	ICC	S
B	S	S	22	TCT	3	8"	FC 8"	-	T	49	I	15-1	W/OR	ICC	S
C	S	S	24	TCT	3	12"	FC 12"	BP	MAS	88	I	15-1	W/OR	ICC	S
D	L	S	41	TCT	3	12"	FC 12"	-	T	89	I	15-1	W/OR	ICC	S
E	S	S	42	TCT	3	12"	FC 12"	-	T						
F	L	S	61	TCT	3	8"	FC 8"	-	S						
G	S	S	62	TCT	3	8"	FC 8"	-	T						
H	S	S	64	TCT	3	12"	FC 12"	BP	MAS						
			81	TCT	3	12"	FC 12"	-	T						
			82	TCT	3	12"	FC 12"	-	S						
1	u	w													
2	u	w													
3	u	w													

CONTROLLER CABINET SIZE : ORDINARY BASE CABINET : -

COMMENTS : CONTRACT 21