



7-27-90 B.P. Louvers Moun't NO. OF SECT. SIGNAL MESSAGE POLE FUNC MATE SIZE No. **MAKE** VISOR LEGEND ELEMENT MAKE MOUN'T A B 82 EA FC 8" No 49 W/OW ED $\frac{2}{2}$ GRP W/OR 3 61 EA FC 8" No 88 15-1 100 WOR C 3 EA 81 NO FC 84 89 GRO WIOW S WOR ED EA D 2. <u>2</u> 7 8" 32 FC 8" NO S 48 W/OW GRD W/De ED 3 8" EA 42 FC 8" No \overline{z} EA FC 8" 2 No 41 EA FC 8" No 62 811 EA FC 8" NO W W W

CONTROLLER CABINET SIZE : DRDINARY BASE CABINET: YES

COMMENTS: Replaced Ped Signal *88 with ICC

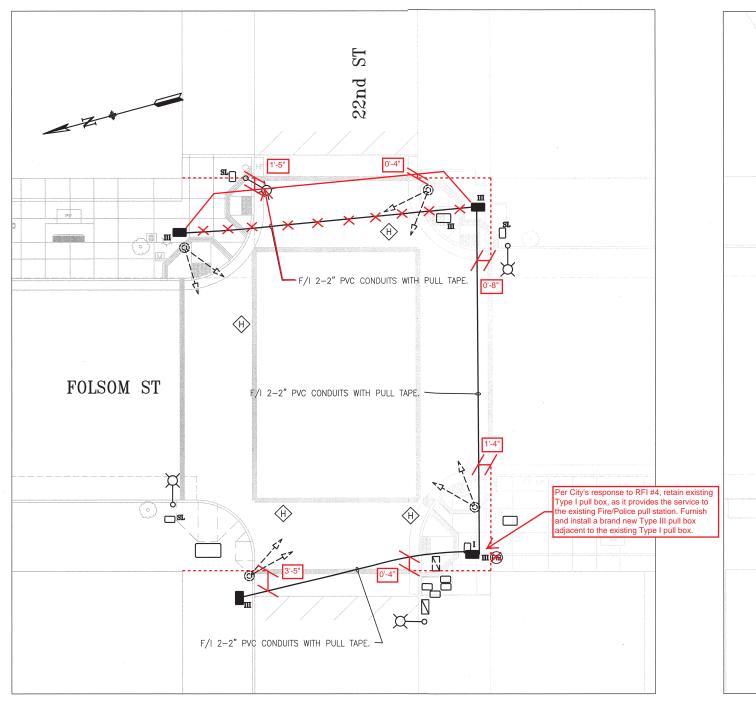

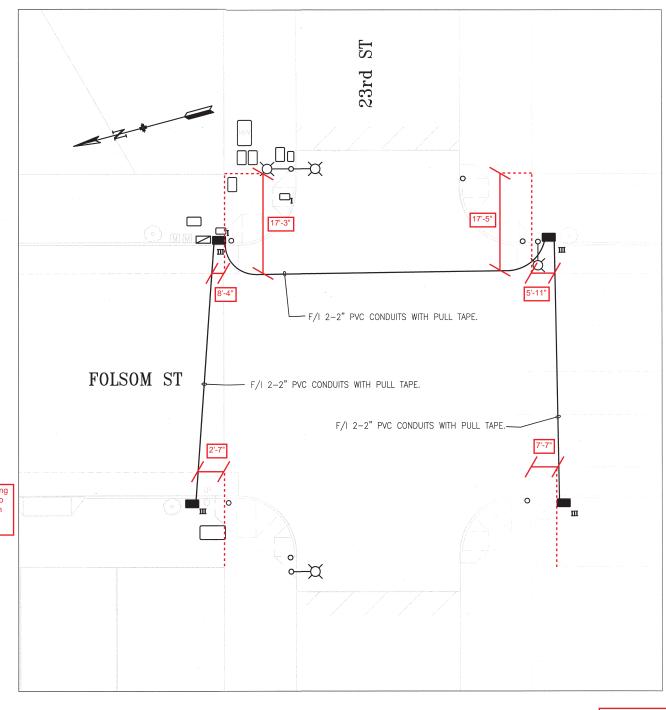

20 0 20 40 HORIZONTAL SCALE IN FEET AS-BUILT
DATE: 9/30/13
BY: MIKE WONG
PHOENIX ELECTRIC
1350 VAN DYKE AVENUE
SAN FRANCISCO, CA 94124

BASE BID

NO. DATE DESCRIPTION BY APP.

TABLE OF REVISIONS
CHECK WITH TRACING TO SEE IF YOU HAVE LATEST REVISION



BUREAU OF ENGINEERING

DEPARTMENT OF PUBLIC WORKS
CITY AND COUNTY OF SAN FRANCISCO

PROFESS/ON	
STEN TINE	
No. E15417	
★ Exp. 6/2011 ★	
OF CALIFORNIT	
1/19/12	4

	DESIGNED	DATE	APPROVED
A	KK 🌮	7/12	1100 07/19/10
	DRAWN	DATE	SECTION MANAGER DATE
$\ $	KK .	7/12	DEPUTY BUREAU MANAGER DATE
۱	CHECKED	DATE	Pall Mo- stala
in	SL slee	7/12	BUREAU MANAGER DATE

7	SCALE	
E	1"=20'	
Ē	SHEET OF SHEETS	
	54 of 67	ı

	FOLSOM STREETSCAPE IMPROVEMENTS PROJECT
22ND	FOLSOM STREET STREET AND 23RD STREET INTERSECTI TRAFFIC SIGNAL WORK

	DRAWING NO.
	E-2.0
	FILE NO.
TIONS	91599
TIONS	REV. NO.
	Ó