


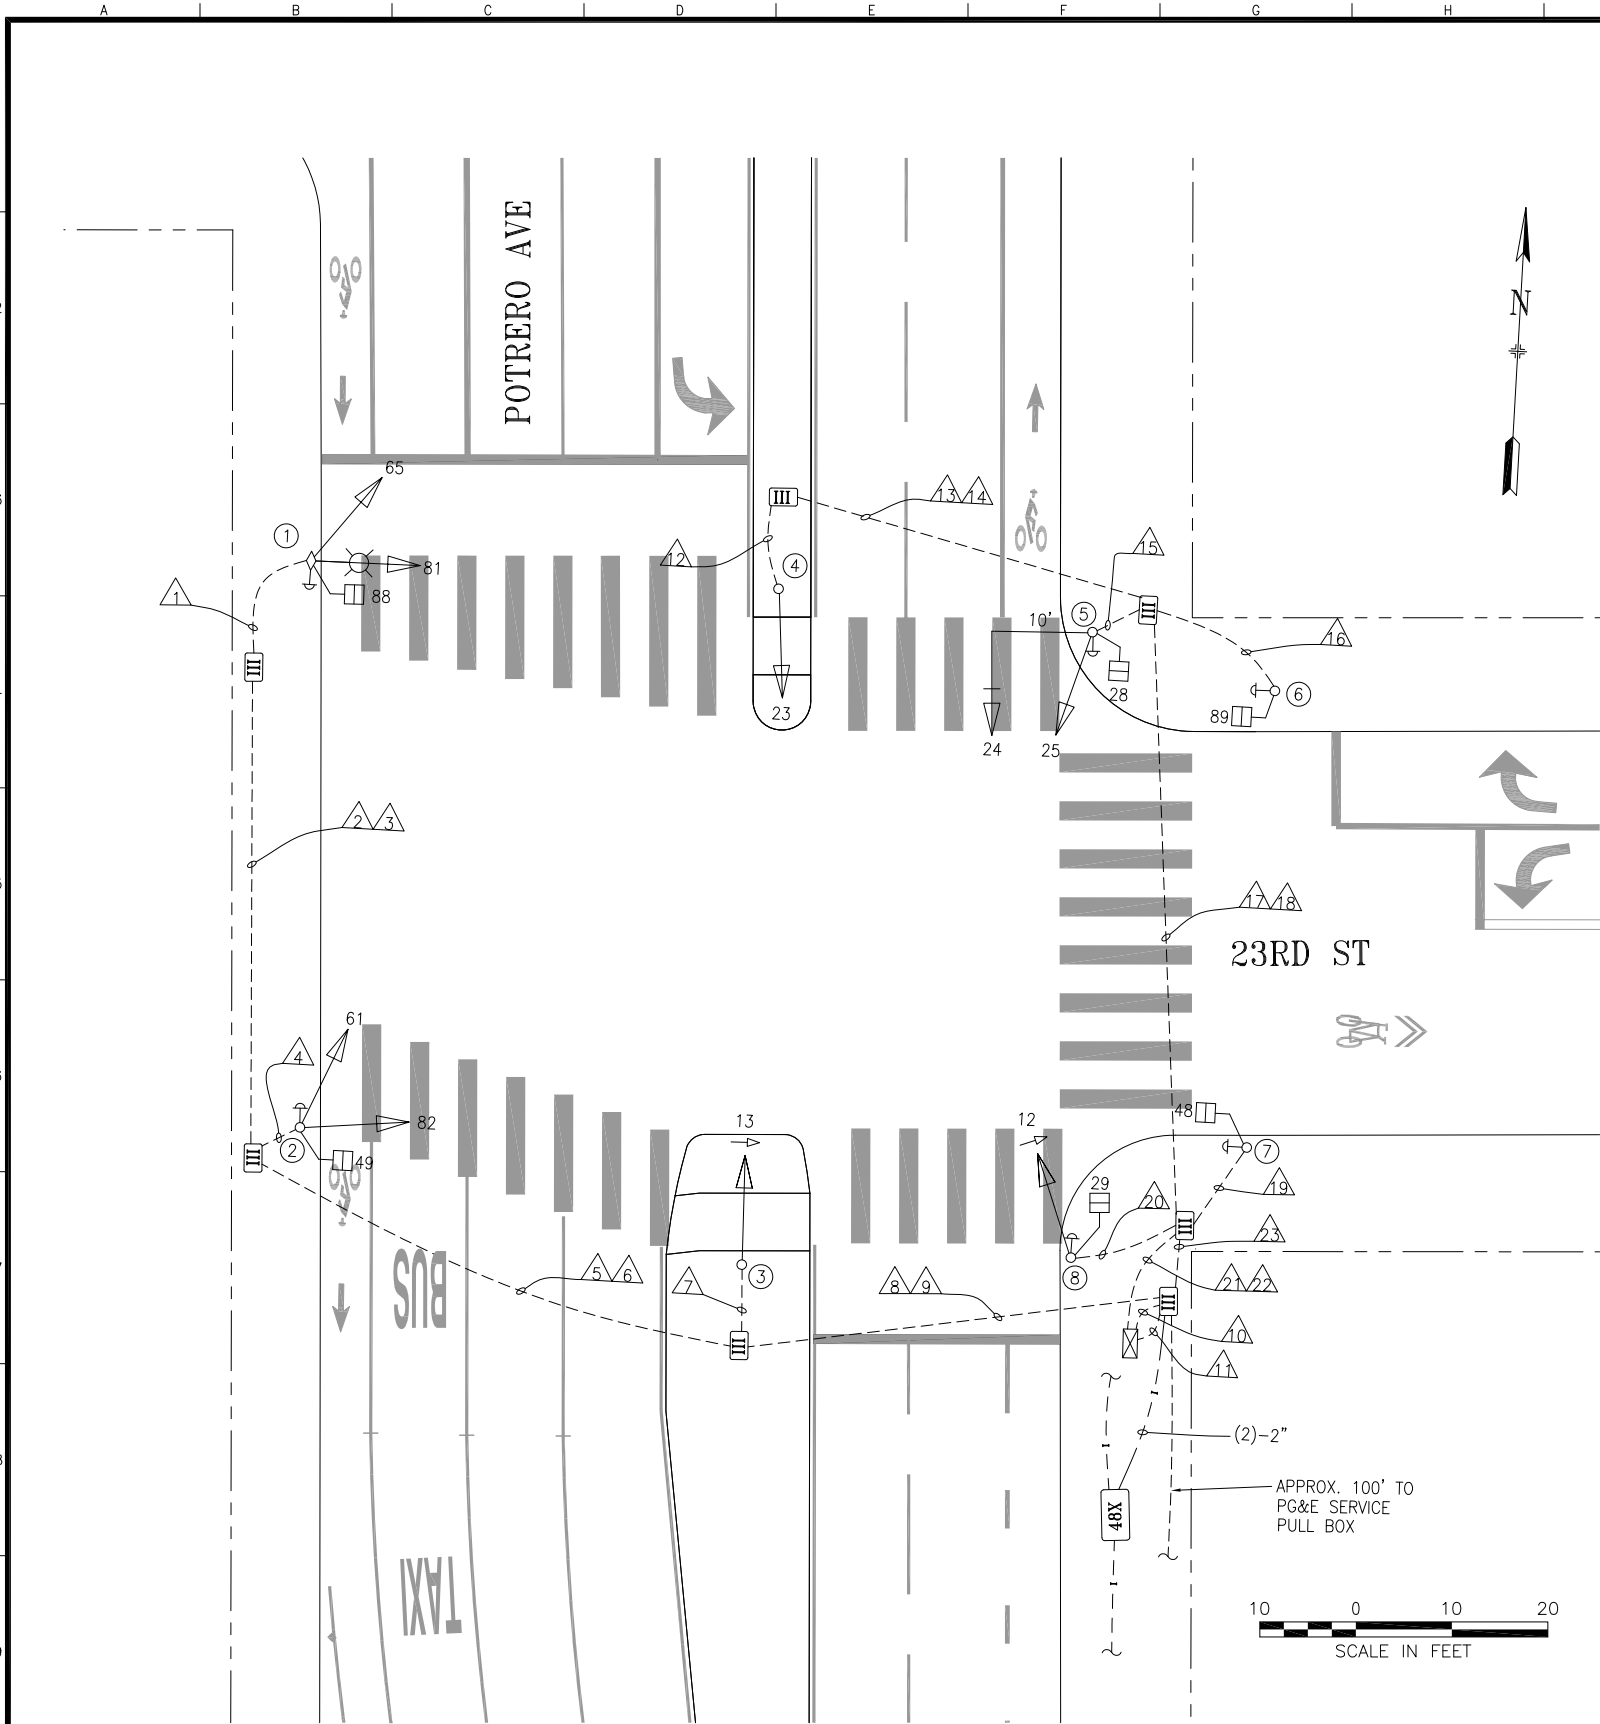

POLE & EQUIPMENT SCHEDULE										
POLE No.	TYPE OF POLE	VEHICLE SIGNAL					PEDESTRIAN SIGNAL			REMARKS
		No.	TYPE	MOUNTING	VISORS	LOUVERS/BP	No.	TYPE	MOUNTING	
①	MUNI TROLLEY POLE & SL	65 81	3S12" 3S12"	SV-2-TA	T T		88	1S-COUNT	SP-1	APS-2W TSP
②	1-A (10')	61 82	3S12" 3S12"	TV-2-T W/ EXTENDER & COUPLER	T T		49	1S-COUNT	SP-1	APS-2W
③	1-A (10')	13	4S12" GLA	TV-1-T	T					
④	1-A (10')	23	3S12"	TV-1-T	T					
⑤	16-1-100 W/ 10' MAST ARM	24 25	3S12" 3S12"	MAS SV-1-T	T T	BP	28	1S-COUNT	SP-1	APS-2W TSP SFgo CCTV
⑥	1-A (7')						89	1S-COUNT	TP-1	APS-2W
⑦	1-A (7')						48	1S-COUNT	TP-1	APS-2W
⑧	1-A (10')	12	4S12"GLA	TV-1-T	T		29	1S-COUNT	SP-1	APS-2W

0	10/05/17	UPGRADED BY 2127J; CONVERTED FROM AS-BUILTS	Hfu	Ventura	
NO.	DATE	DESCRIPTION	BY	APP.	
TABLE OF REVISIONS					
CHECK WITH TRACING TO SEE IF YOU HAVE LATEST REVISION					

REFERENCE INFORMATION & FILE NO. OF SURVEYS



SAN FRANCISCO MUNICIPAL TRANSPORTATION AGENCY
CITY AND COUNTY OF SAN FRANCISCO

DRAWN:	DATE:
H.YU	07/2019
CHECKED:	DATE:
L.VENTURA	09/2020

SCALE:
AS SHOWN
SHEET OF SHEETS
1 OF 2

TRAFFIC SIGNAL INVENTORY DIAGRAM
23RD STREET AND POTRERO AVENUE

CNN NO.
23963000
REV NO.
0

A vertical number line with tick marks labeled 1 through 9.

[illegible]