


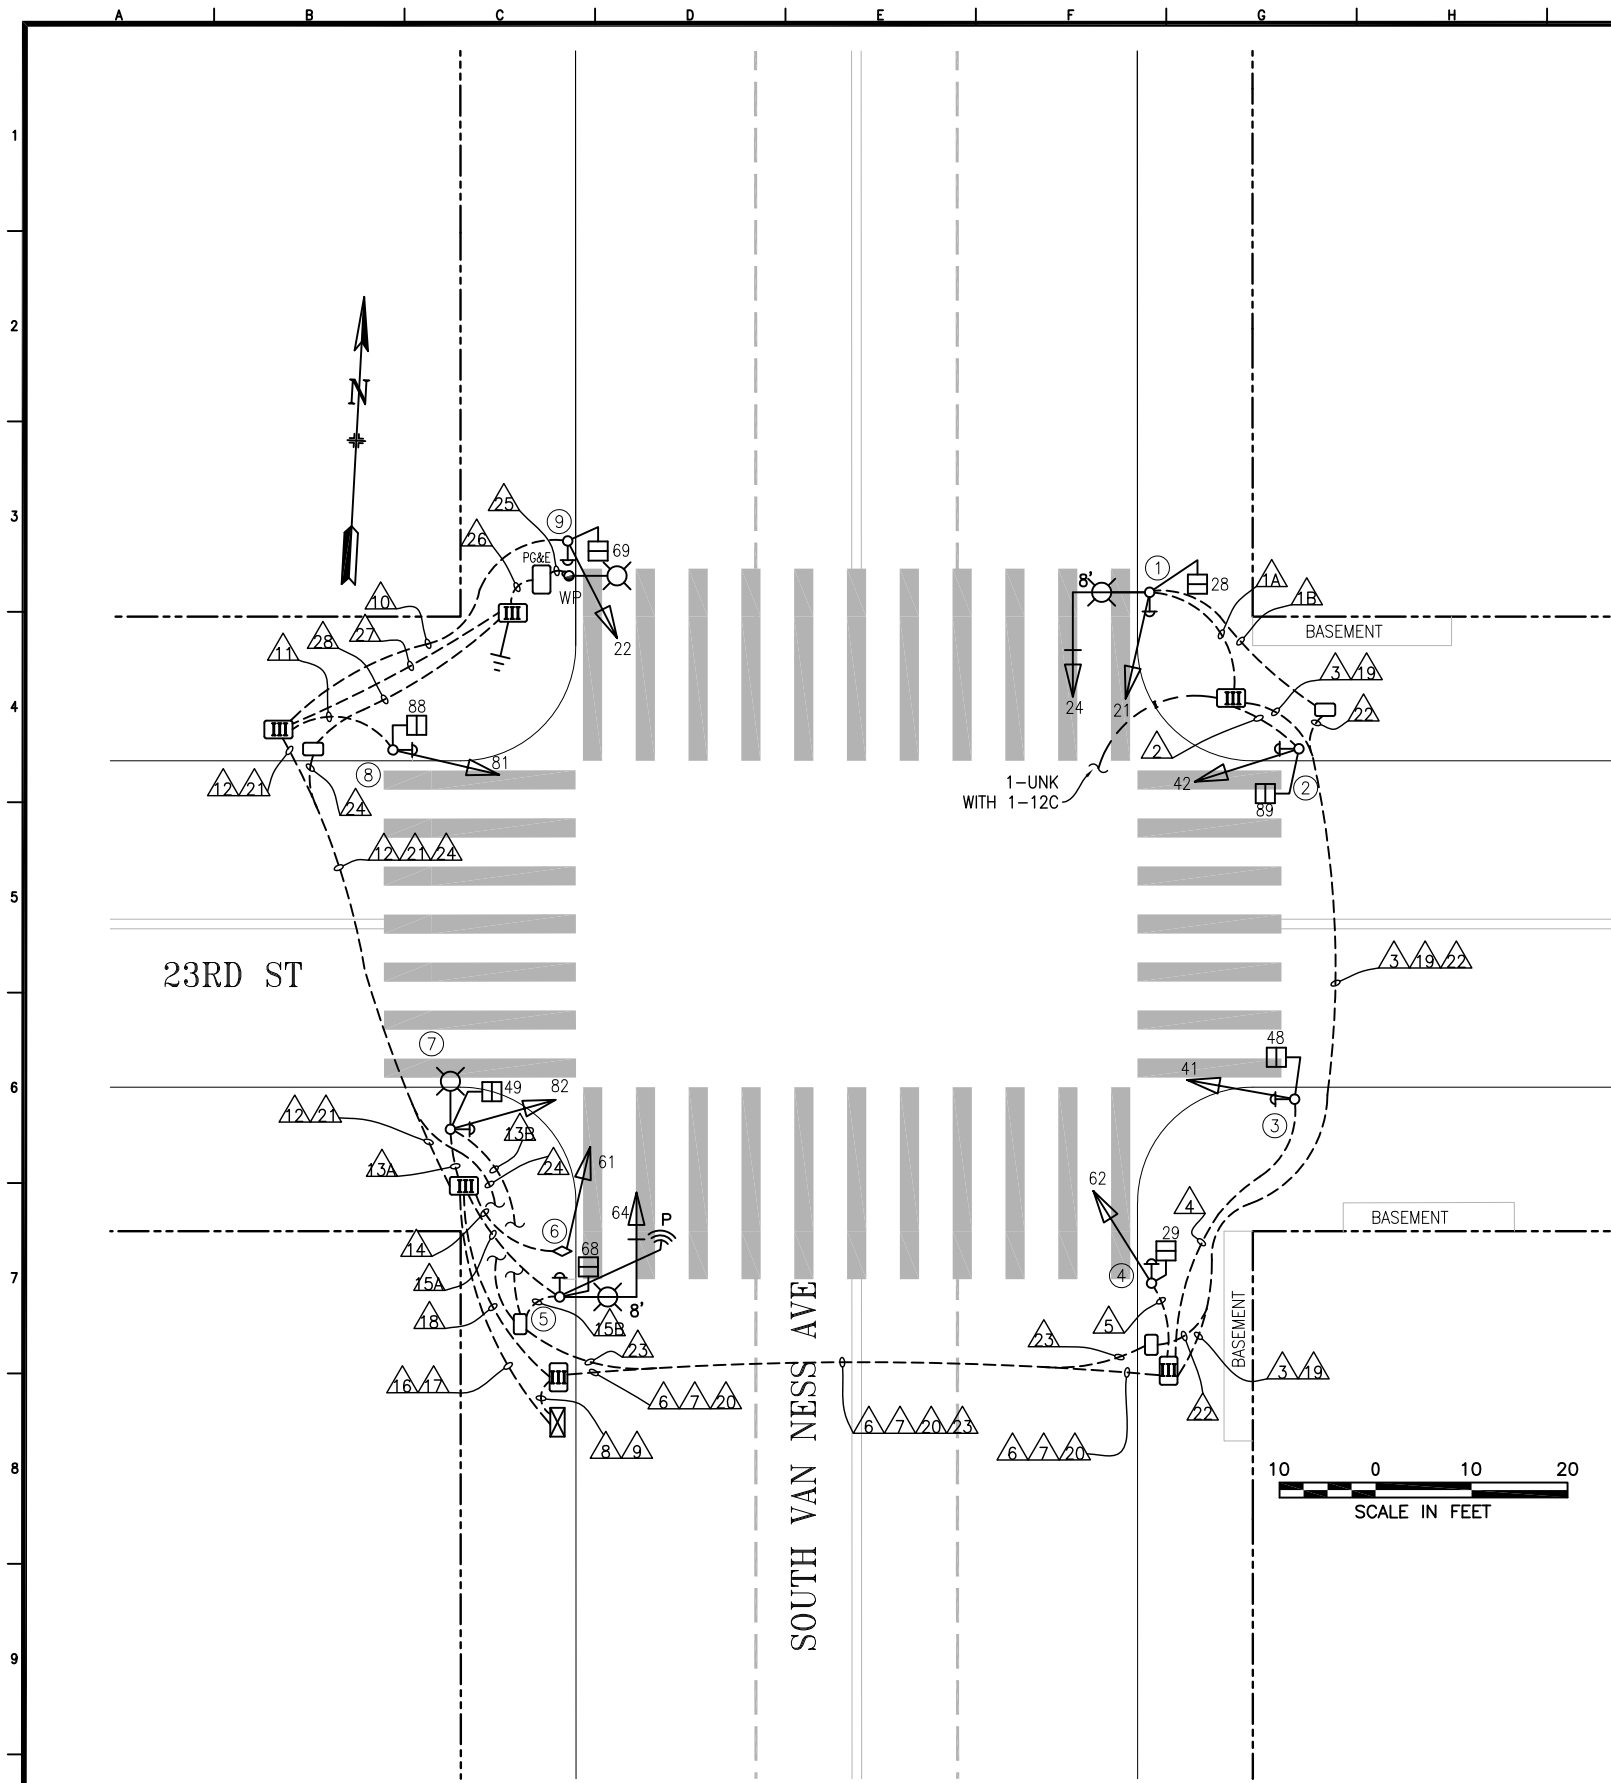

| POLE AND EQUIPMENT SCHEDULE |                                              |                |                |                |                                                                                                   |        |            |                   |          |            |        |               |                           |
|-----------------------------|----------------------------------------------|----------------|----------------|----------------|---------------------------------------------------------------------------------------------------|--------|------------|-------------------|----------|------------|--------|---------------|---------------------------|
| POLE No.                    | TYPE OF POLE                                 | LUMINAIRE TYPE | VEHICLE SIGNAL |                |                                                                                                   |        |            | PEDESTRIAN SIGNAL |          |            |        | ITS DEVICE    | REMARKS                   |
|                             |                                              |                | No.            | TYPE           | MOUNTING                                                                                          | VISORS | LOUVERS/BP | No.               | TYPE     | MOUNTING   | BUTTON |               |                           |
| ①                           | 17-2-100 WITH 8' MAST ARM & 6' LUMINAIRE ARM |                | 21<br>24       | 3S12"<br>3S12" | SV-1-T<br>MAS  | T<br>T | BACKPLATE  | 28                | 1S-COUNT | SP-1       | APS-2W |               |                           |
| ②                           | 1-A (10')                                    |                | 42             | 3S12"          | TV-1-T                                                                                            | T      |            | 89                | 1S-COUNT | SP-1       | APS-2W |               |                           |
| ③                           | 1-A (10')                                    |                | 41             | 3S12"          | TV-1-T                                                                                            | T      |            | 48                | 1S-COUNT | SP-1       | APS-2W |               |                           |
| ④                           | 1-A (13')                                    |                | 62             | 3S12"          | TV-1-T                                                                                            | T      |            | 29                | 1S-COUNT | SP-1 (22") | APS-2W |               |                           |
| ⑤                           | 17-2-100 WITH 8' MAST ARM & 6' LUMINAIRE ARM |                | 64             | 3S12"          | MAS            | T      | BACKPLATE  | 68                | 1S-COUNT | SP-1 (22") | APS-2W | PREEMPT RADIO |                           |
| ⑥                           | EX. MUNI POLE                                |                | 61             | 3S12"          | SV-1-T                                                                                            | T      |            |                   |          |            |        |               | EXTERNAL CONDUIT          |
| ⑦                           | CITY STANDARD STREET LIGHT W/ 6' LA          |                | 82             | 3S12"          | SV-1-T                                                                                            | T      |            | 49                | 1S-COUNT | SP-1       | APS-2W |               |                           |
| ⑧                           | 1-A (10')                                    |                | 81             | 3S12"          | TV-1-T (24")                                                                                      | T      |            | 88                | 1S-COUNT | SP-1 (22") | APS-2W |               |                           |
| ⑨                           | 1-A (10')                                    |                | 22             | 3S12"          | TV-1-T                                                                                            | T      |            | 69                | 1S-COUNT | SP-1 (22") | APS-2W |               | MOUNT 22 ON BUILDING SIDE |

NOTES:

① PLUMBIZER MOUNTED BETWEEN YELLOW AND GREEN SECTIONS

| NO. | DATE     | DESCRIPTION                                   | BY     | APPROVED |
|-----|----------|-----------------------------------------------|--------|----------|
| 3   | 7/01/22  | SRC 2022-067: ADDED PREEMPT RADIO             | JLee   | LVentura |
| 2   | 7/21/21  | ADD 12C NOTE AT NE CORNER PER 2823J AS-BUILTS | DYeung | GdeLeon  |
| 1   | 8/9/19   | LENGTHEN NIPPLE FOR SIGNAL 81 PER FIELD CHECK | DYeung | GdeLeon  |
| 0   | 12/18/18 | SIGNAL UPGRADE ACTIVATED THROUGH 2823J        | DYeung | GdeLeon  |

TABLE OF REVISIONS  
CHECKOUT DRAWING THROUGH THE SID CUSTODIAN FOR THE LATEST REVISION



SFMTA

|             |        |
|-------------|--------|
| DRAWN BY:   | DATE:  |
| DYeung      | 9/2021 |
| CHECKED BY: | DATE:  |
| GDeLeon     | 9/2021 |

|                 |
|-----------------|
| SCALE           |
| AS SHOWN        |
| SHEET OF SHEETS |
| 1 OF 2          |

|                                       |
|---------------------------------------|
| TRAFFIC SIGNAL INVENTORY DIAGRAM      |
| 23RD STREET AND SOUTH VAN NESS AVENUE |

|          |
|----------|
| CNN NO:  |
| 24075000 |
| REV NO:  |
| 3        |

