


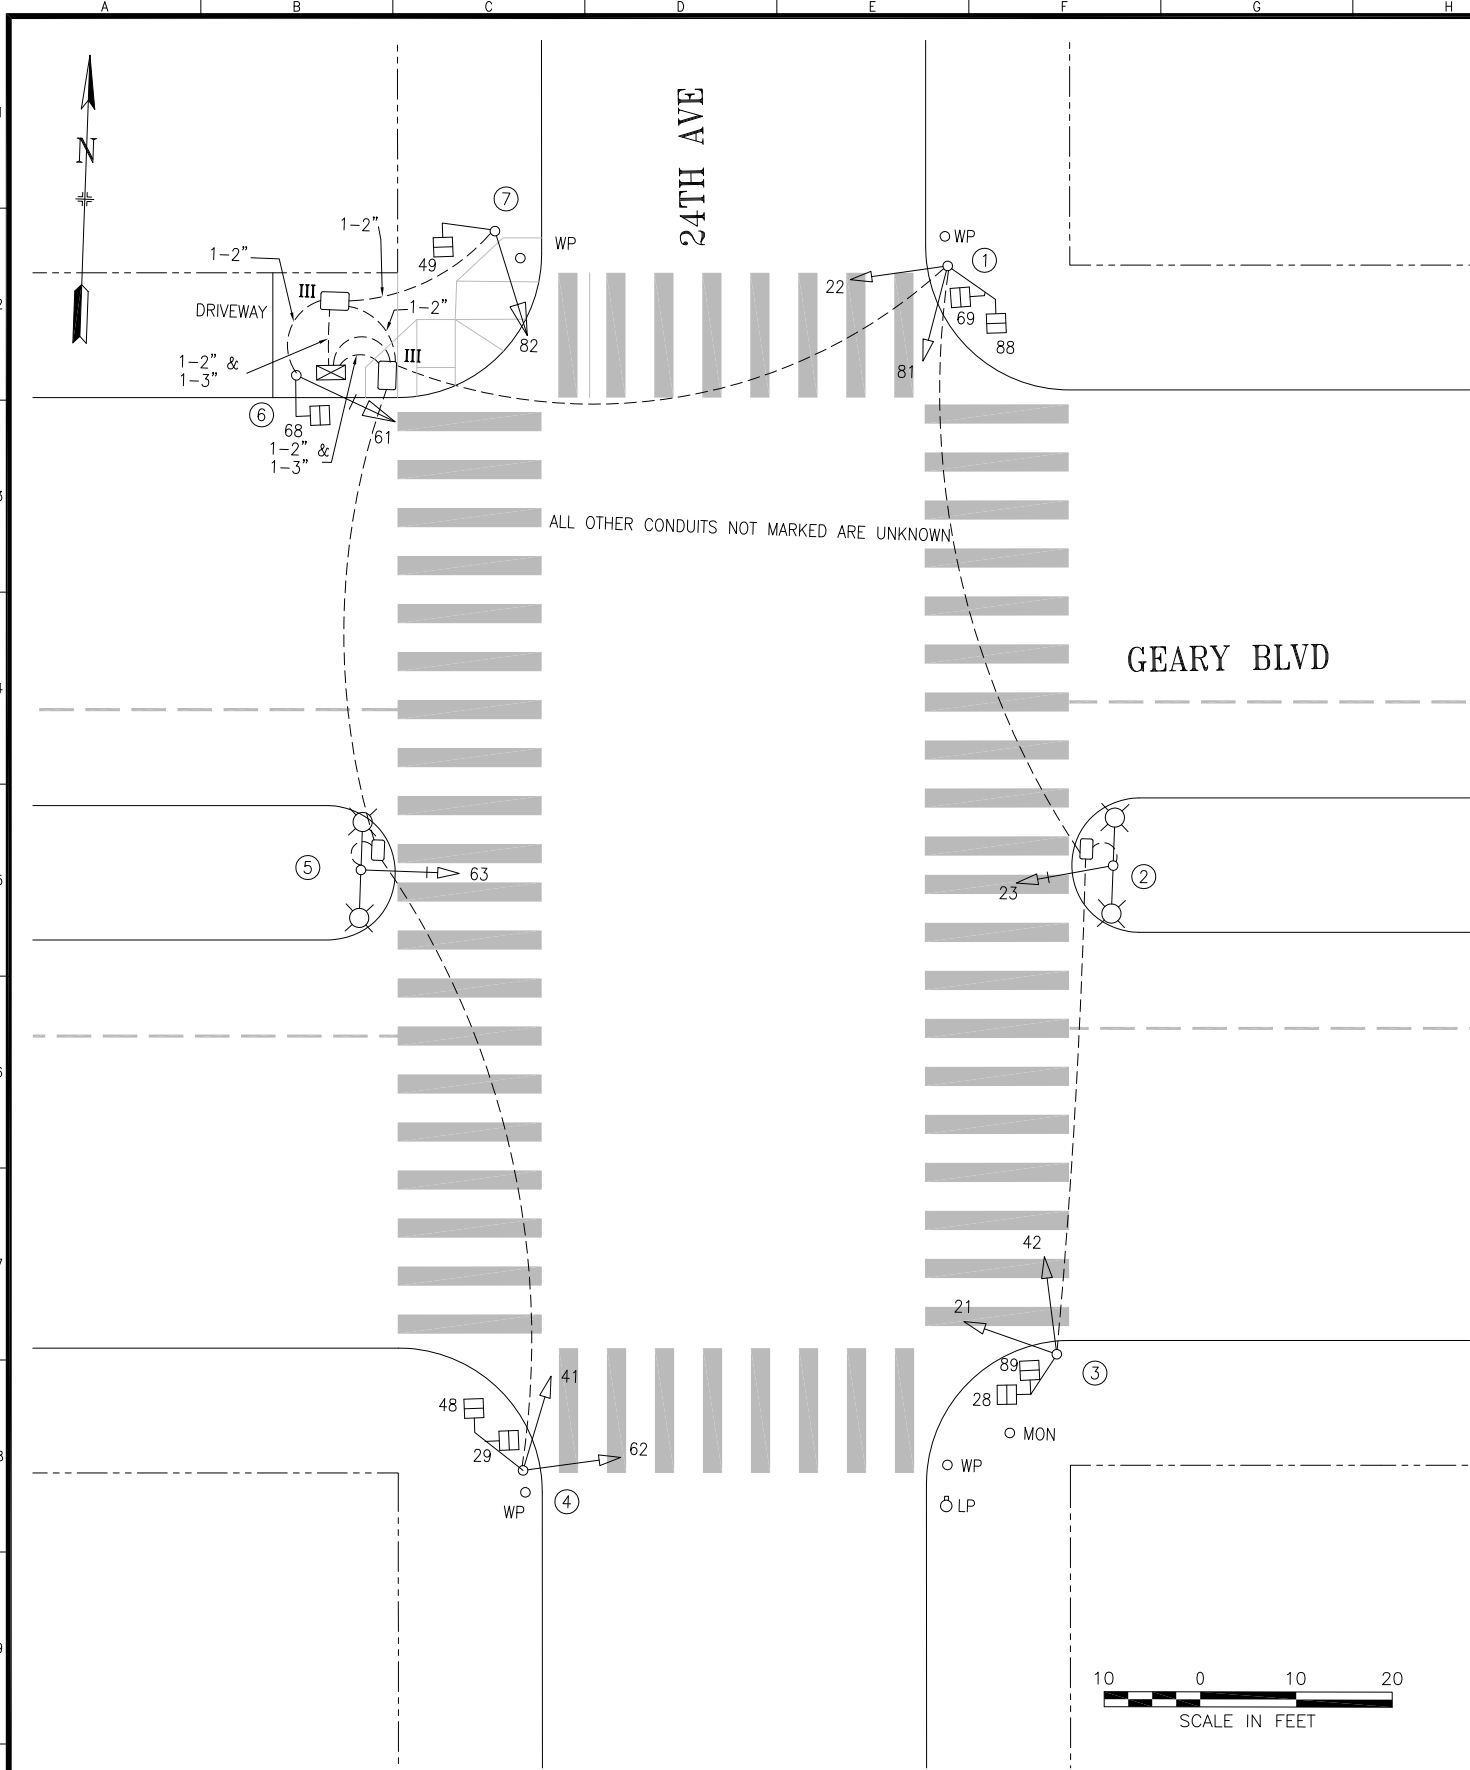

POLE AND EQUIPMENT SCHEDULE										
POLE No.	TYPE OF POLE	VEHICLE SIGNAL					PEDESTRIAN SIGNAL			REMARKS
		No.	TYPE	MOUNTING	VISORS	LOUVERS	No.	TYPE	MOUNTING	
①	MARBELITE POLE (10')	81 22	3S8" 3S8"	TV-2-T-SFA	T T		69 88	1S-COUNT 1S-COUNT	SP-1 SP-1	
②	MARBELITE SL W/ DUAL 6' LUMINARE ARMS	23	3S8"	SV-1	T					BACKPLATE
③	MARBELITE POLE (10')	21 42	3S8" 3S8"	TV-2-T-SFA	T T		28 89	1S-COUNT 1S-COUNT	SP-1 SP-1	
④	MARBELITE POLE (10')	41 62	3S8" 3S8"	TV-2-T-SF	T T		29 48	1S-COUNT 1S-COUNT	SP-1 SP-1	
⑤	MARBELITE SL W/ DUAL 6' LUMINARE ARMS	63	3S8"	SV-1	T					TSP EQUIPMENT BACKPLATE
⑥	1-A (10')	61	3S12"	TV-1-T	T		68	1S-COUNT	SP-1	BACKPLATE
⑦	1-A (10')	82	3S12"	TV-1-T	T		49	1S-COUNT	SP-1	

0	2/13/17	RELOC HEADS AT NW CORNER TO NEW 1-As - SRC 2016-297	DY	GD	
NO.	DATE	DESCRIPTION	BY	APP.	

TABLE OF REVISIONS
CHECK WITH TRACING TO SEE IF YOU HAVE LATEST REVISION

REFERENCE INFORMATION
& FILE NO. OF SURVEYS



SAN FRANCISCO MUNICIPAL TRANSPORTATION AGENCY
CITY AND COUNTY OF SAN FRANCISCO

DRAWN:	DATE:
DYeung	04/26/17
CHECKED:	DATE:
GDeLeon	04/26/17

SCALE:

AS SHOWN

SHEET OF SHEETS

1 OF 1

TRAFFIC SIGNAL INVENTORY DIAGRAM

24TH AVENUE AND GEARY BOULEVARD

CNN NO.

27542000

REV NO.

0