


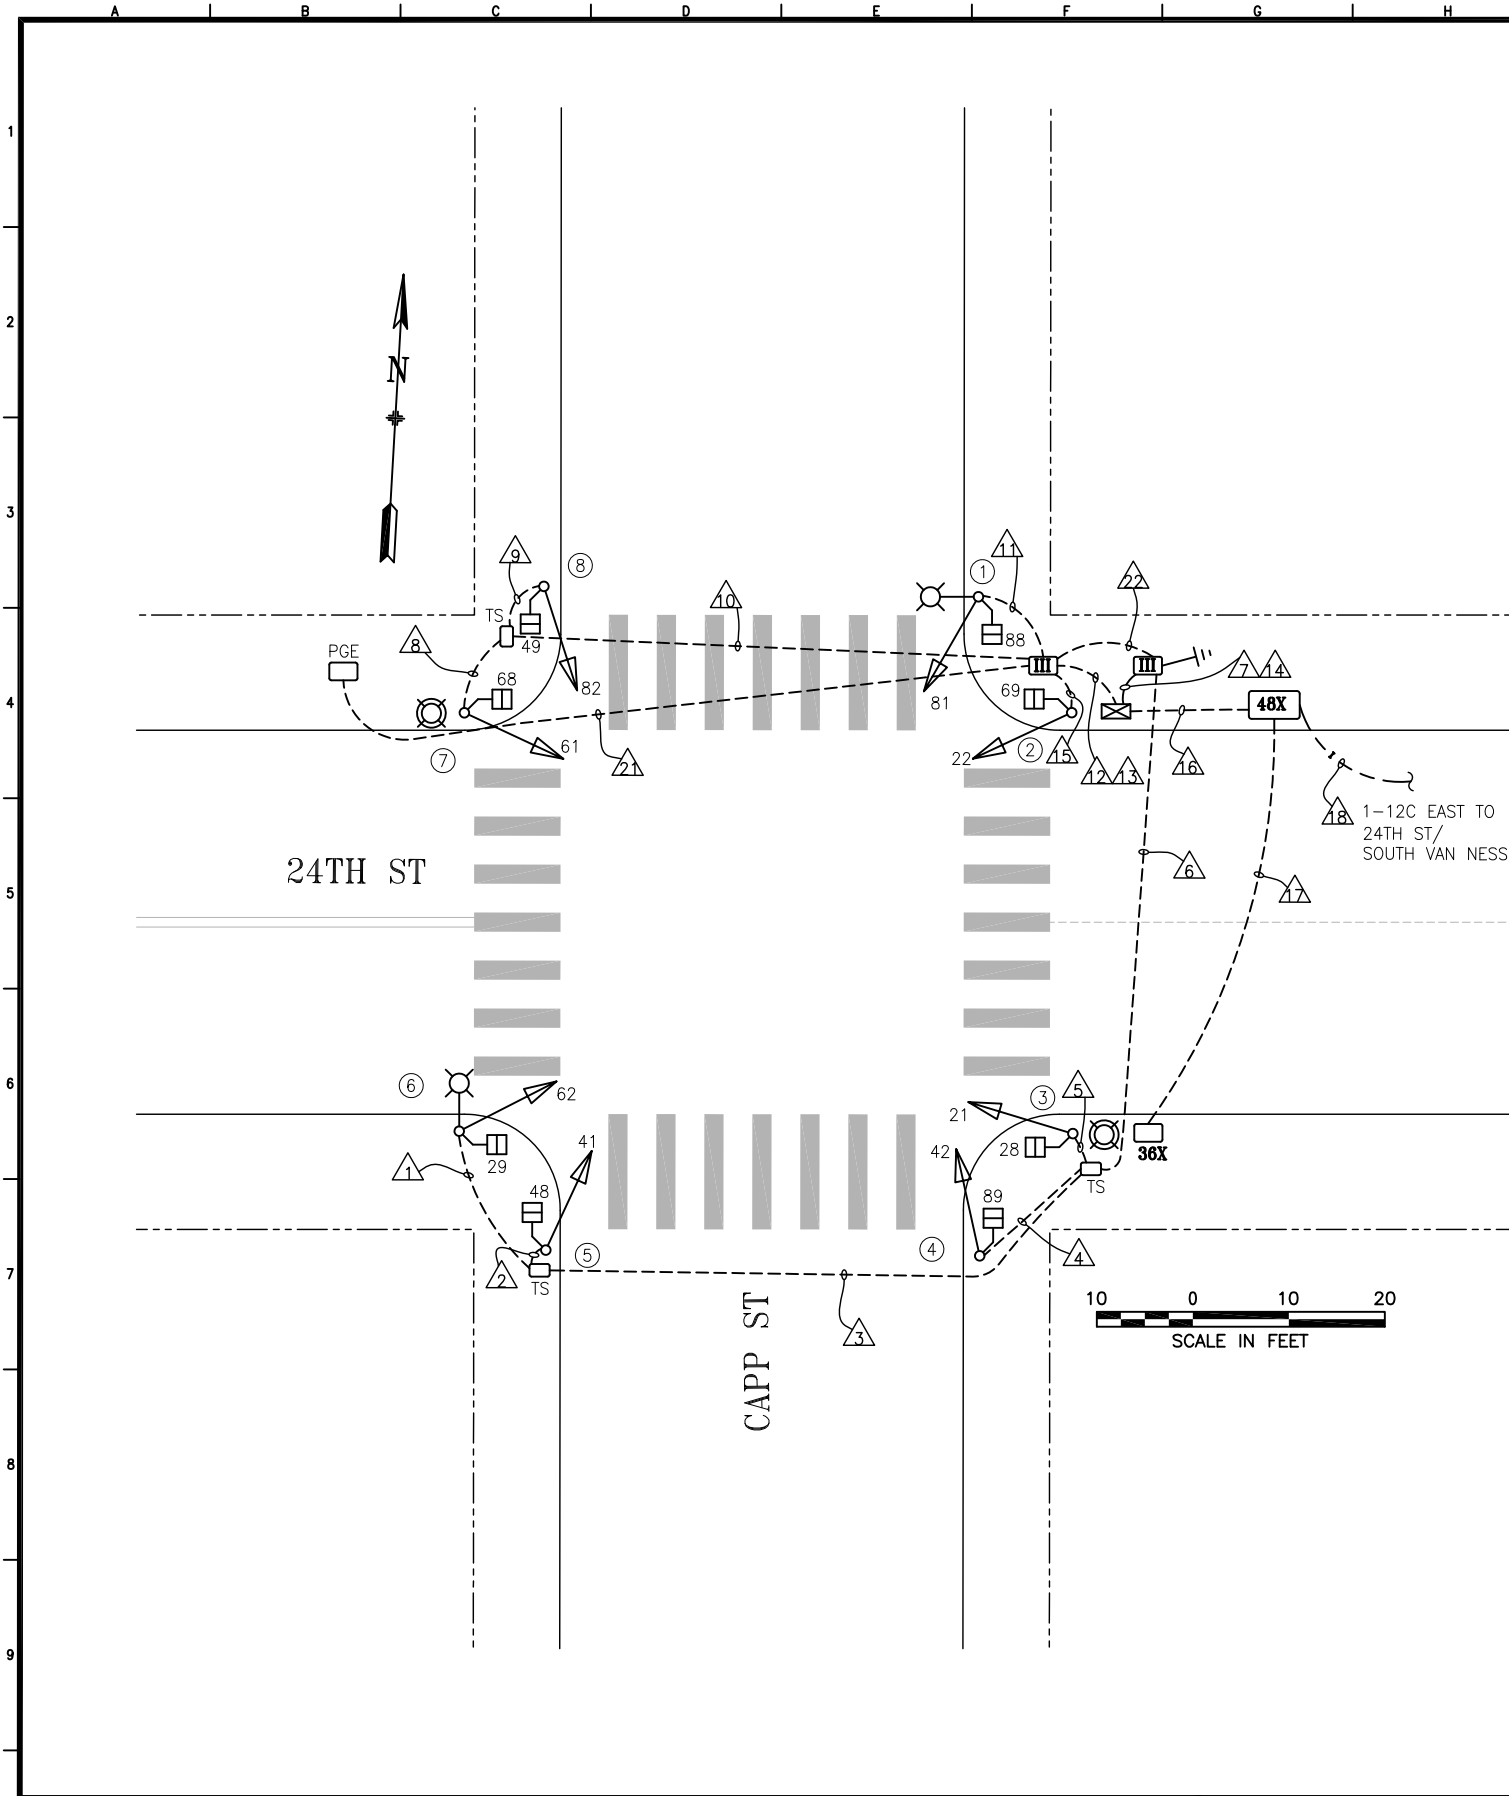

POLE AND EQUIPMENT SCHEDULE										
POLE No.	TYPE OF POLE	VEHICLE SIGNAL					PEDESTRIAN SIGNAL			REMARKS
		No.	TYPE	MOUNTING	VISORS	LOUVERS/BP	No.	TYPE	MOUNTING	
①	STREETLIGHT	81	3S12"	SV-1-T	T		88	1S-COUNT	SP-1	
②	1-A (10')	22	3S12"	TV-1-T	T		69	1S-COUNT	SP-1	
③	1-A (10')	21	3S12"	TV-1-T	T		28	1S-COUNT	SP-1	
④	1-A (10')	42	3S12"	TV-1-T	T		89	1S-COUNT	SP-1	
⑤	1-A (10')	41	3S12"	TV-1-T	T		48	1S-COUNT	SP-1	
⑥	STREETLIGHT	62	3S12"	SV-1-T	T		29	1S-COUNT	SP-1	
⑦	1-A (10')	61	3S12"	TV-1-T	T		68	1S-COUNT	SP-1	
⑧	1-A (10')	82	3S12"	TV-1-T	T		49	1S-COUNT	SP-1	

Δ	6/9/23	SRC 2023-043; UPGRADE ALL SIGNALS EXCEPT 81 FROM 8 TO 12-INCH	D. YEUNG	G. DE LEON	
Δ	2/9/23	PER FIELD - UPDATE 81 TO 12-INCH	D. YEUNG	G. DE LEON	
Δ	9/5/02	CONVERTED FROM CONTRACT 0309J AS-BUILT	D. YEUNG	G. DE LEON	
NO.	DATE	DESCRIPTION	BY	APPROVED	
TABLE OF REVISIONS					
CHECKOUT DRAWING THROUGH THE SID CUSTODIAN FOR THE LATEST REVISION					



SFMTA

DRAWN BY: D. YEUNG	DATE: FEB 2023
CHECKED BY: G. DE LEON	DATE: FEB 2023

SCALE AS SHOWN
SHEET OF SHEETS 1 OF 2

TRAFFIC SIGNAL INVENTORY DIAGRAM
24TH ST AND CAPP ST

CNN NO: 24070000
REV NO: 2

[illegible]