


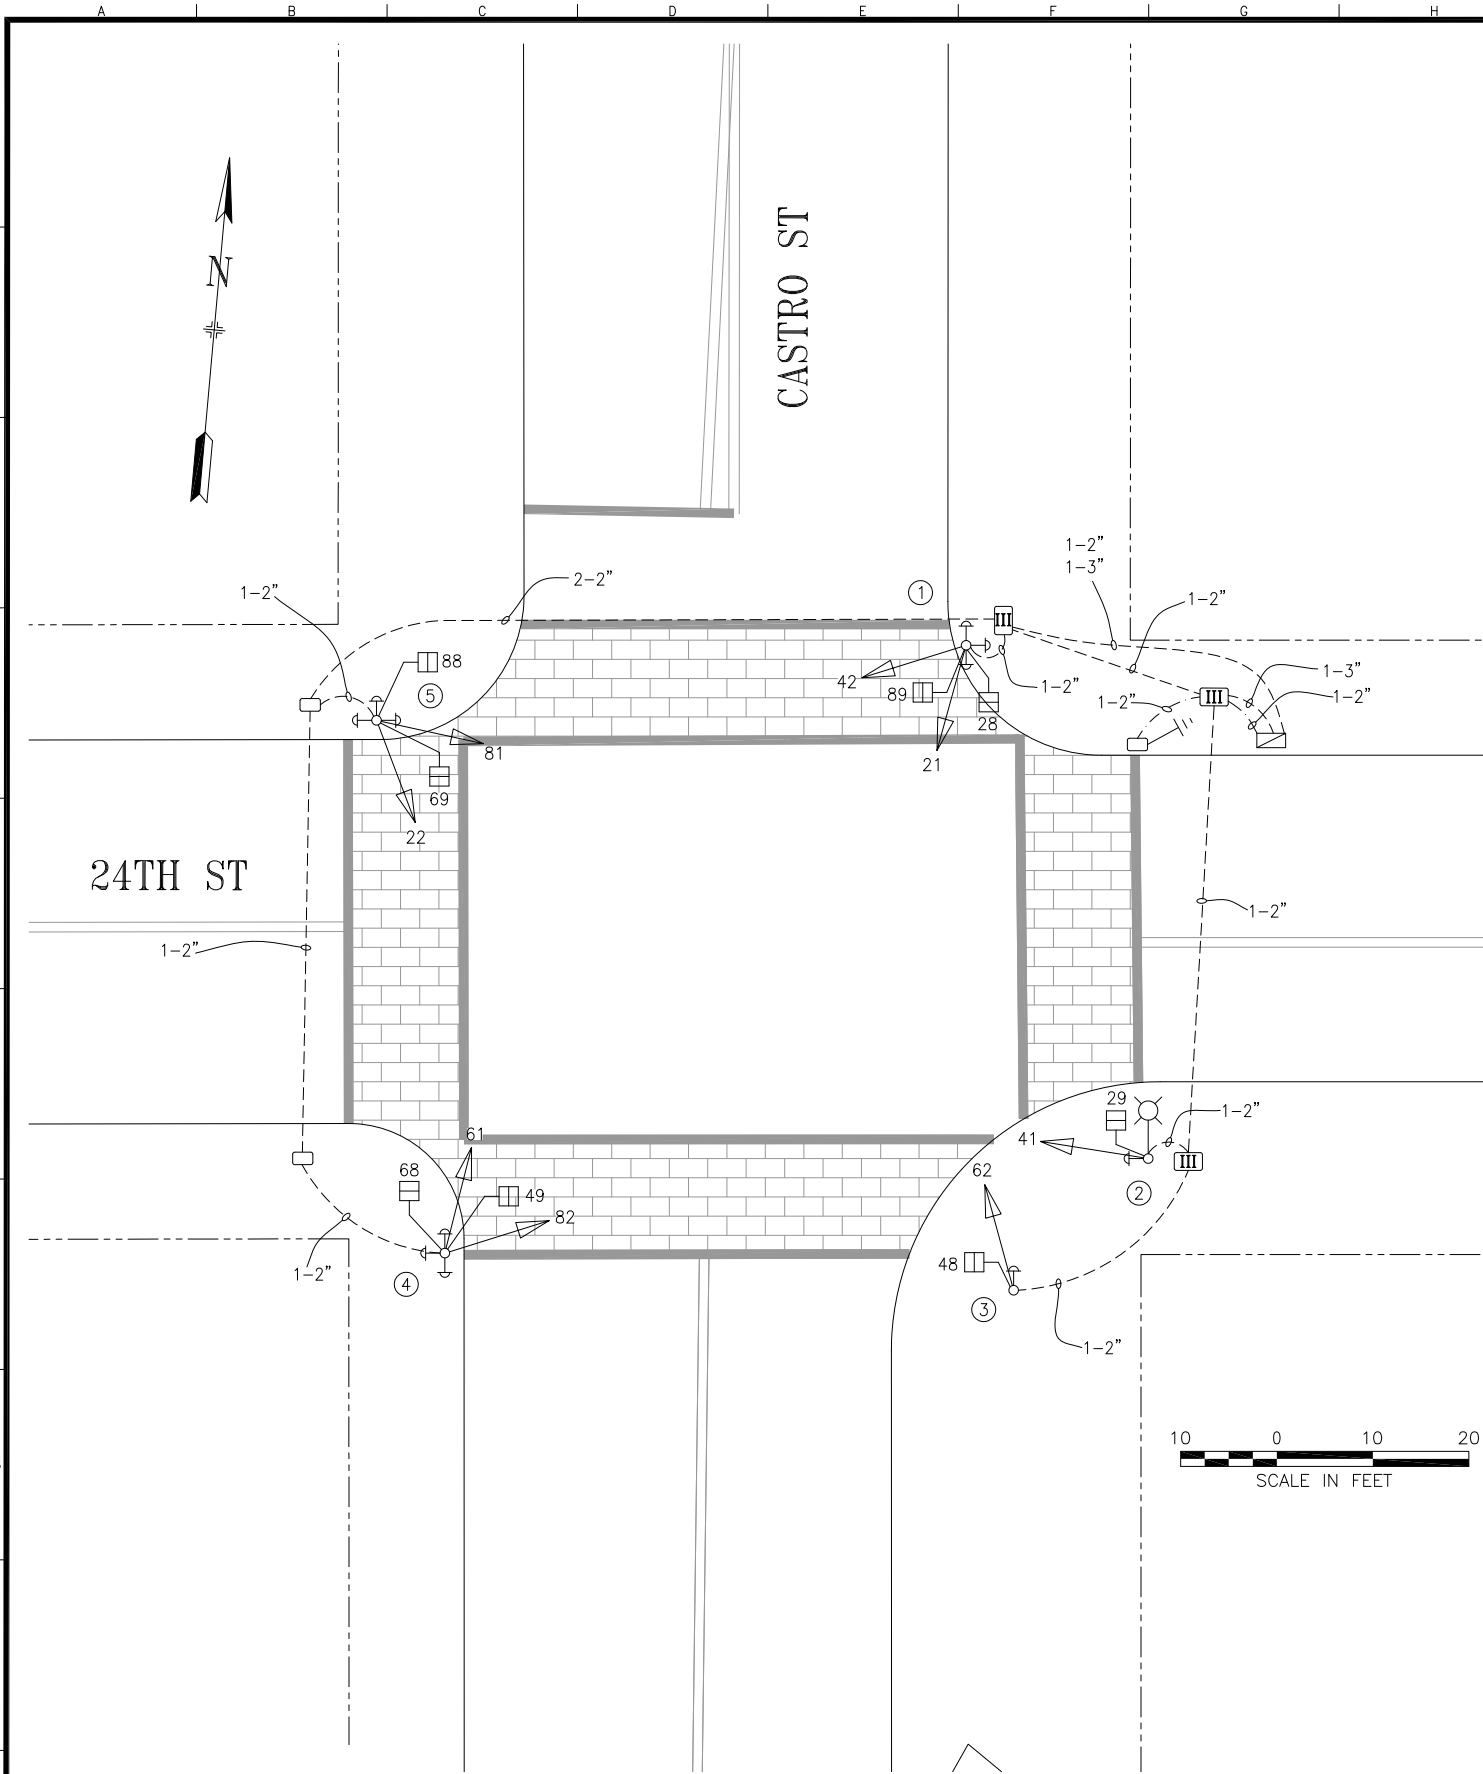

POLE AND EQUIPMENT SCHEDULE										
POLE No.	TYPE OF POLE	VEHICLE SIGNAL					PEDESTRIAN SIGNAL			REMARKS
		No.	TYPE	MOUNTING	VISORS	LOUVERS	No.	TYPE	MOUNTING	
①	PEDESTAL BASE	21 42	3S12" 3S12"	TV-2-T-SFA	T T		28 89	1S-COUNT 1S-COUNT	SP-1-SF (12") SP-1 (22")	APS-3W X 3
②	STEEL STREETLIGHT	41	3S12"	SV-1-T	T		29	1S-COUNT	SP-1	APS-3W
③	1-A (10')	62	3S12"	TV-1-T	T		48	1S-COUNT	SP-1	APS-3W
④	PEDESTAL BASE	61 82	3S12" 3S12"	TV-2-T-SFA	T T		49 68	1S-COUNT 1S-COUNT	SP-2-CUSTOM	APS-3W X 3
⑤	PEDESTAL BASE	22 81	3S12" 3S12"	TV-2-T-SFA	T T		69 88	1S-COUNT 1S-COUNT	SP-1-SF (12") SP-1 (22")	APS-3W X 3

2	6/07/22	ADD APS (SRC 2021-201) UPDATE SIGNALS, MOUNTINGS, POLES PER FIELD	E.LUU	G.DELEON
1	8/06/14	12" SIGNALS FOR 41 AND 62 INSTALLED BY SIGNAL SHOP	S.SHARIATI	G.DELEON
0	8/03/06	PCS ACTIVATED THROUGH 0872J; SID CONVERTED FROM 0872J CP	S.SHARIATI	G.DELEON
NO.	DATE	DESCRIPTION	BY	APPROVED
TABLE OF REVISIONS CHECKOUT DRAWING THROUGH THE SID CUSTODIAN FOR THE LATEST REVISION				



SFMTA

DRAWN BY: S.SHARIATI		DATE: 09/14		SCALE AS SHOWN	TRAFFIC SIGNAL INVENTORY DIAGRAM	CNN NO: 25744000		
CHECKED BY: G.DELEON		DATE: 09/14				REV NO: 2		
SHEET OF SHEETS 1 OF 1					24TH STREET AND CASTRO STREET			