


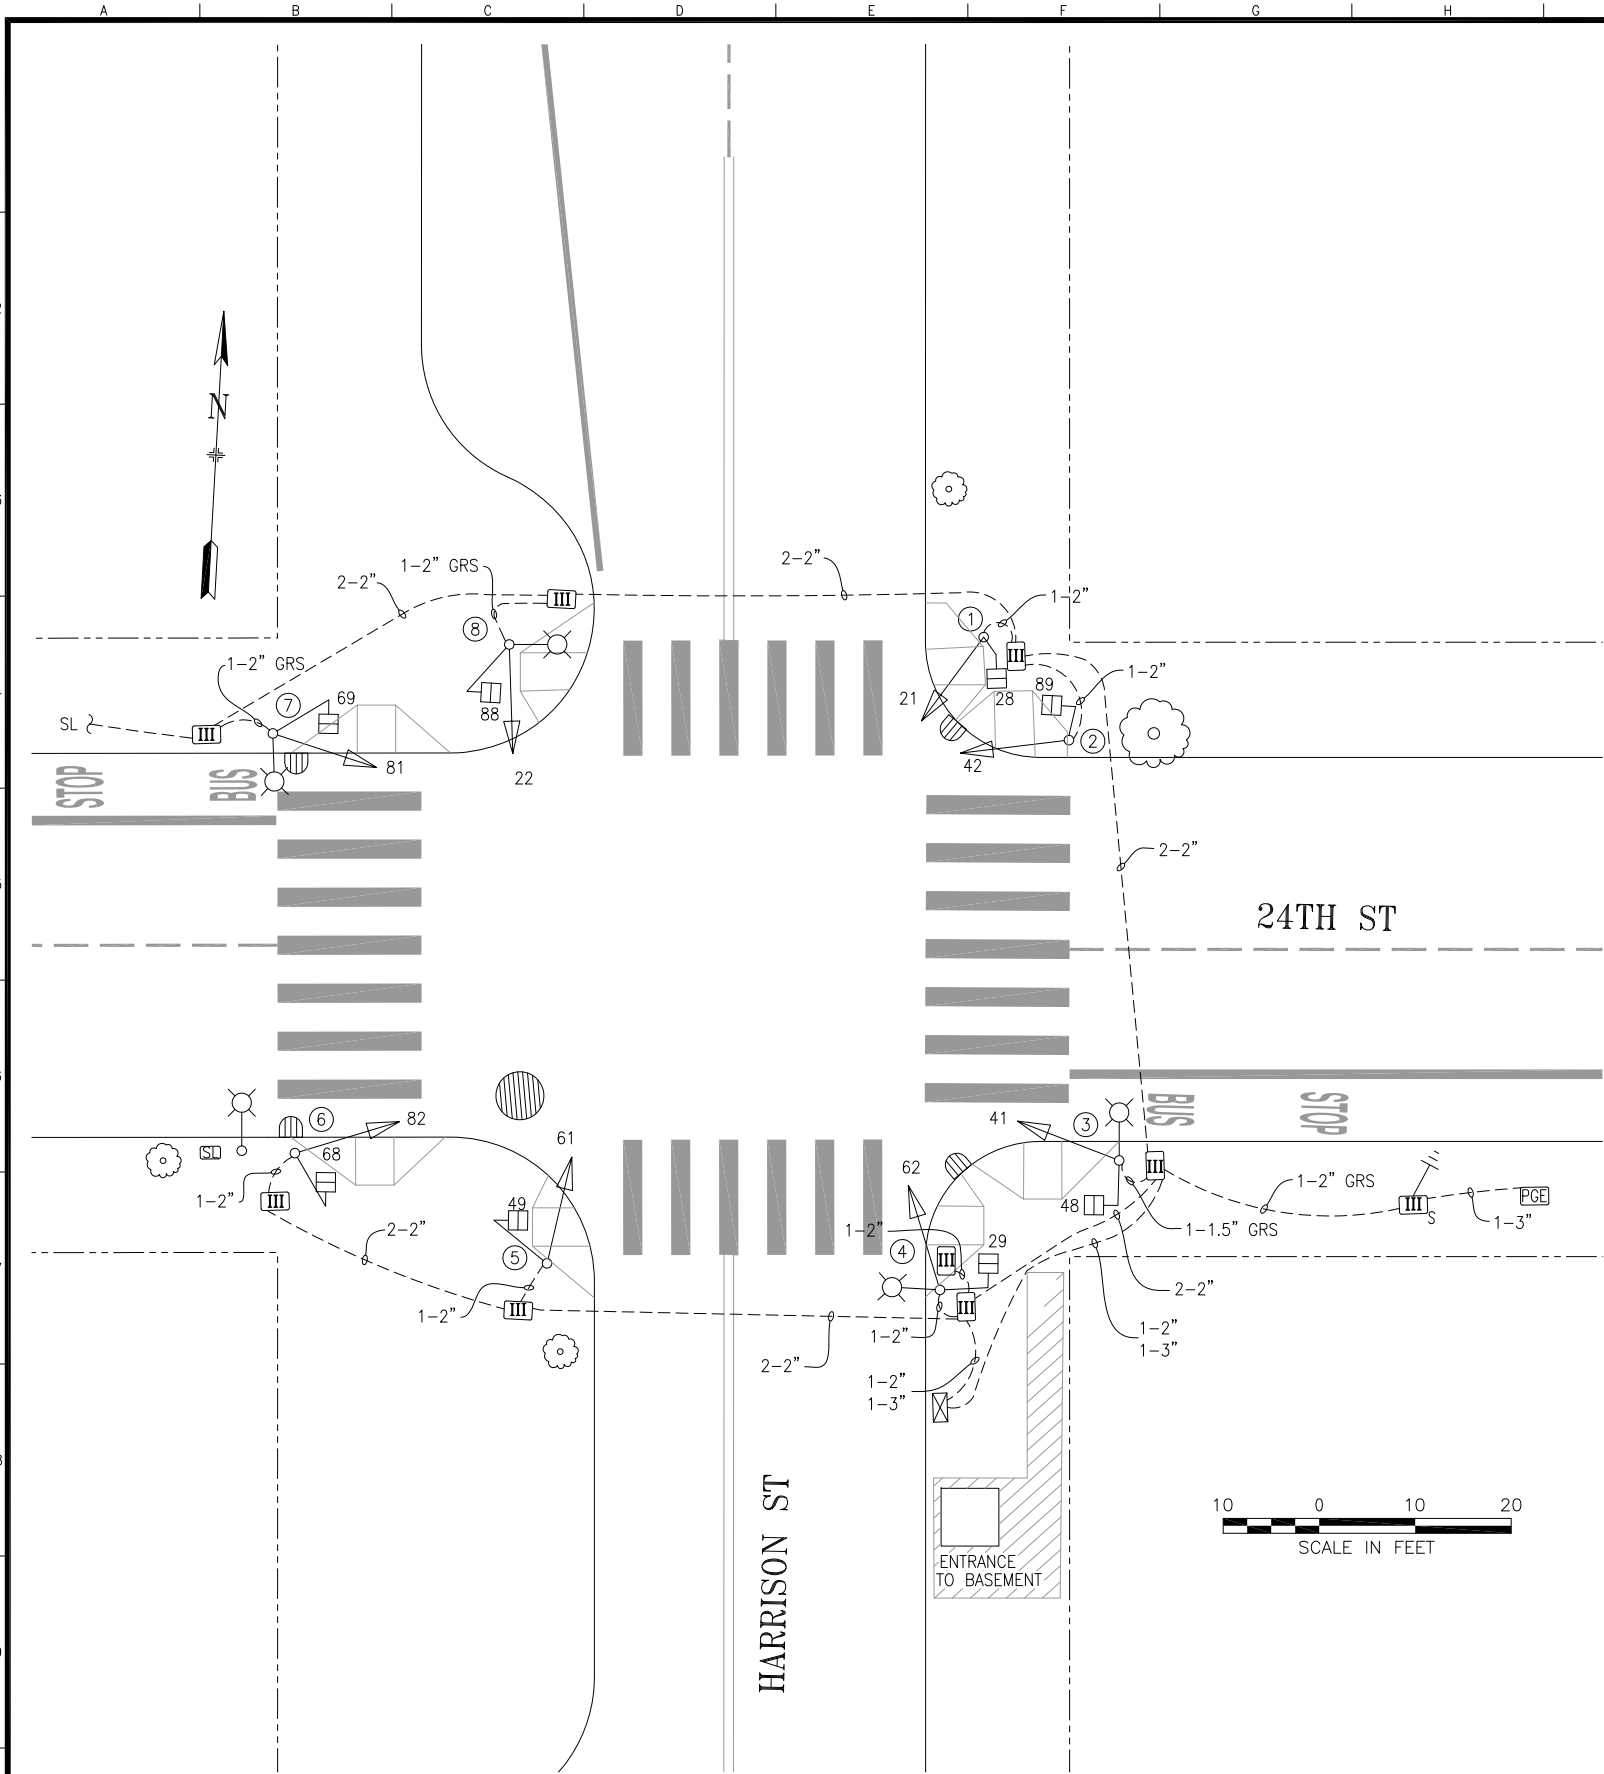

POLE AND EQUIPMENT SCHEDULE											
POLE No.	TYPE OF POLE	LUMINAIRE VOLTAGE/WATTAGE	VEHICLE SIGNAL					PEDESTRIAN SIGNAL			REMARKS
			No.	TYPE	MOUNTING	VISORS	LOUVERS	No.	TYPE	MOUNTING	
①	1-A (10')		21	3S12"	TV-1-T	T		28	1S-COUNT	SP-1	
②	1-A (10')		42	3S12"	TV-1-T	T		89	1S-COUNT	SP-1	
③	CITY STANDARD STREETLIGHT		41	3S12"	SV-1-T	T		48	1S-COUNT	SP-1	
④	CITY STANDARD STREETLIGHT	150W HPS	62	3S12"	SV-1-T	T		29	1S-COUNT	SP-1	
⑤	1-A (10')		61	3S12"	TV-1-T	T		49	1S-COUNT	SP-1-SF (22")	
⑥	1-A (10')		82	3S12"	TV-1-T	T		68	1S-COUNT	SP-1	
⑦	CITY STANDARD STREETLIGHT	150W HPS	81	3S12"	SV-1-T	T		69	1S-COUNT	SP-1	
⑧	CITY STANDARD STREETLIGHT	150W HPS	22	3S12"	SV-1-T	T		88	1S-COUNT	SP-1-SF (22")	

0	02/23/17	SIGNAL UPGRADED THROUGH 2595J	D.YEUNG	G.DELEON	
NO.	DATE	DESCRIPTION	BY	APP.	
TABLE OF REVISIONS					
CHECK WITH TRACING TO SEE IF YOU HAVE LATEST REVISION					

REFERENCE INFORMATION
& FILE NO. OF SURVEYS



SAN FRANCISCO MUNICIPAL TRANSPORTATION AGENCY
CITY AND COUNTY OF SAN FRANCISCO

DRAWN: DATE:
A.SCALES 5/26/2017
CHECKED: DATE:
G.DELEON 6/2/2017

SCALE:

AS SHOWN

SHEET OF SHEETS

1 OF 1

TRAFFIC SIGNAL INVENTORY DIAGRAM

24TH STREET AND HARRISON STREET

CNN NO.

23978000

REV NO.

0