




POLE AND EQUIPMENT SCHEDULE										
POLE No.	TYPE OF POLE	VEHICLE SIGNAL					PEDESTRIAN SIGNAL			REMARKS
		No.	TYPE	MOUNTING	VISORS	LOUVERS/BP	No.	TYPE	MOUNTING	
①	16-1-70 W/ 8' MAST ARM	24	3S12"	MAS	T	BP				TSP RADIO NETWORK RADIO
②	1-A (13')	21	3S12"	TV-1-T	T					APS-3W
③	CITY STANDARD SL WITH 6' LUMINAIRE ARM	42	3S12"	SV-1-T (MOUNTED ON EAST SIDE)	T		28 89	1S-COUNT 1S-COUNT	SP-1 SP-1	PTZ CAMERA APS-3W
④	16-1-70 W/ 15' MAST ARM	44	3S12"	MAS-SF	T	BP				
⑤	PPB POLE									APS-3W
⑥	1-A (10')	41 62	3S12" 3S12"	TV-2-T-SFA	T T		29 48	1S-COUNT 1S-COUNT	SP-1 (22") SP-1	APS-3W
⑦	16-1-70 W/ 8' MAST ARM	64	3S12"	MAS-SF	T	BP				NETWORK RADIO
⑧	1-A (10')	61	3S12"	TV-1-T	T		68	1S-COUNT	SP-1	APS-3W
⑨	1-A (10')	82	3S12"	TV-1-T	T		49	1S-COUNT	SP-1	APS-3W
⑩	16-1-70 W/ 15' MAST ARM	84 81	3S12" 3S12"	MAS-SF SV-1	T T	BP				
⑪	PPB POLE									APS-3W
⑫	1-A (10')	22	3S12"	TV-1-T	T		69 88	1S-COUNT 1S-COUNT	SP-1 (22") SP-1	APS-3W

- NOTES:
- MAS-SF HAS THE TENON MOUNTED BETWEEN YELLOW AND GREEN BALL
 - THIS INTERSECTION HAS CAMERAS (OPERATED BY OTHERS) MOUNTED ON SIGNAL POLES

	10/20/23	SRC 2023-223: UPGRADE 41, 61, 62 & 82 TO 12-INCH	D. Yeung	G. de Leon
	8/10/23	UPDATE PER FIELD: CLARIFY TSP/NETWORK EQUIPMENT & APS TYPE	D. Yeung	G. de Leon
	3/21/22	UPDATE PER FIELD: NOTE PTZ CAMERA, TSP EQUIPMENT, MINOR MOUNTING UPDATES. NO APS ON POLE 4	D. Yeung	G. de Leon
	2/27/19	REMOVED 358" SIGNAL 81 FROM POLE #12 & INSTALLED 3512" SIGNAL 81 ON POLE #10, AND CONVERTED SIGNAL 22 FROM 358" TO 3512"	EO	MV
NO.	DATE	DESCRIPTION	BY	APPROVED
TABLE OF REVISIONS CHECKOUT DRAWING THROUGH THE SID CUSTODIAN FOR THE LATEST REVISION				

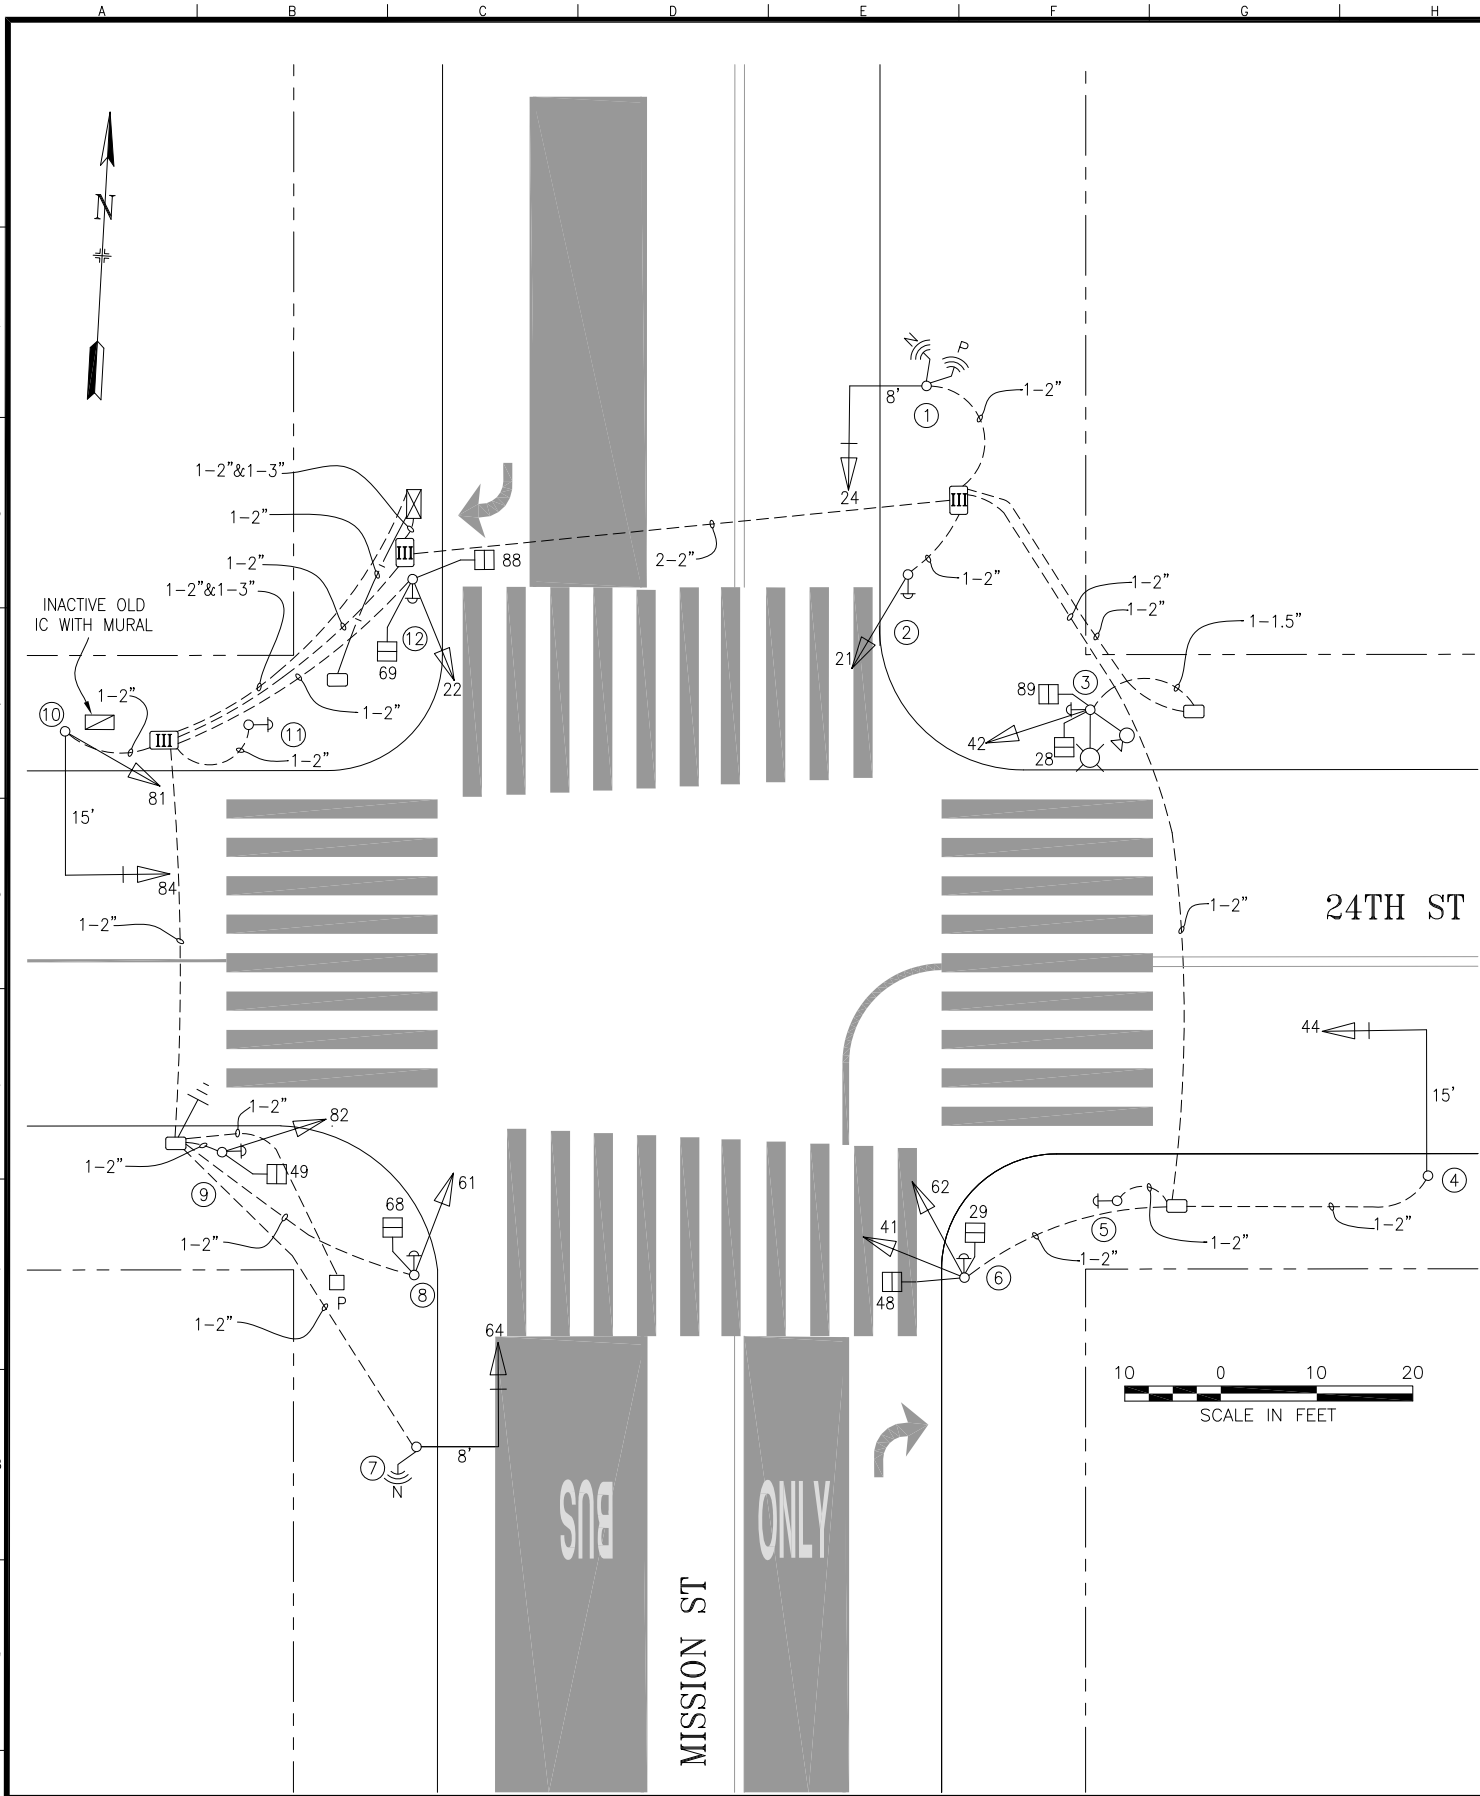

SFMTA

DRAWN BY:	DATE:
JT	04/16
CHECKED BY:	DATE:
MV	04/16

SCALE
AS SHOWN
SHEET OF SHEETS
1 OF 1

TRAFFIC SIGNAL INVENTORY DIAGRAM
24TH ST AND MISSION ST

CNN NO:
24088000
REV NO:
5