


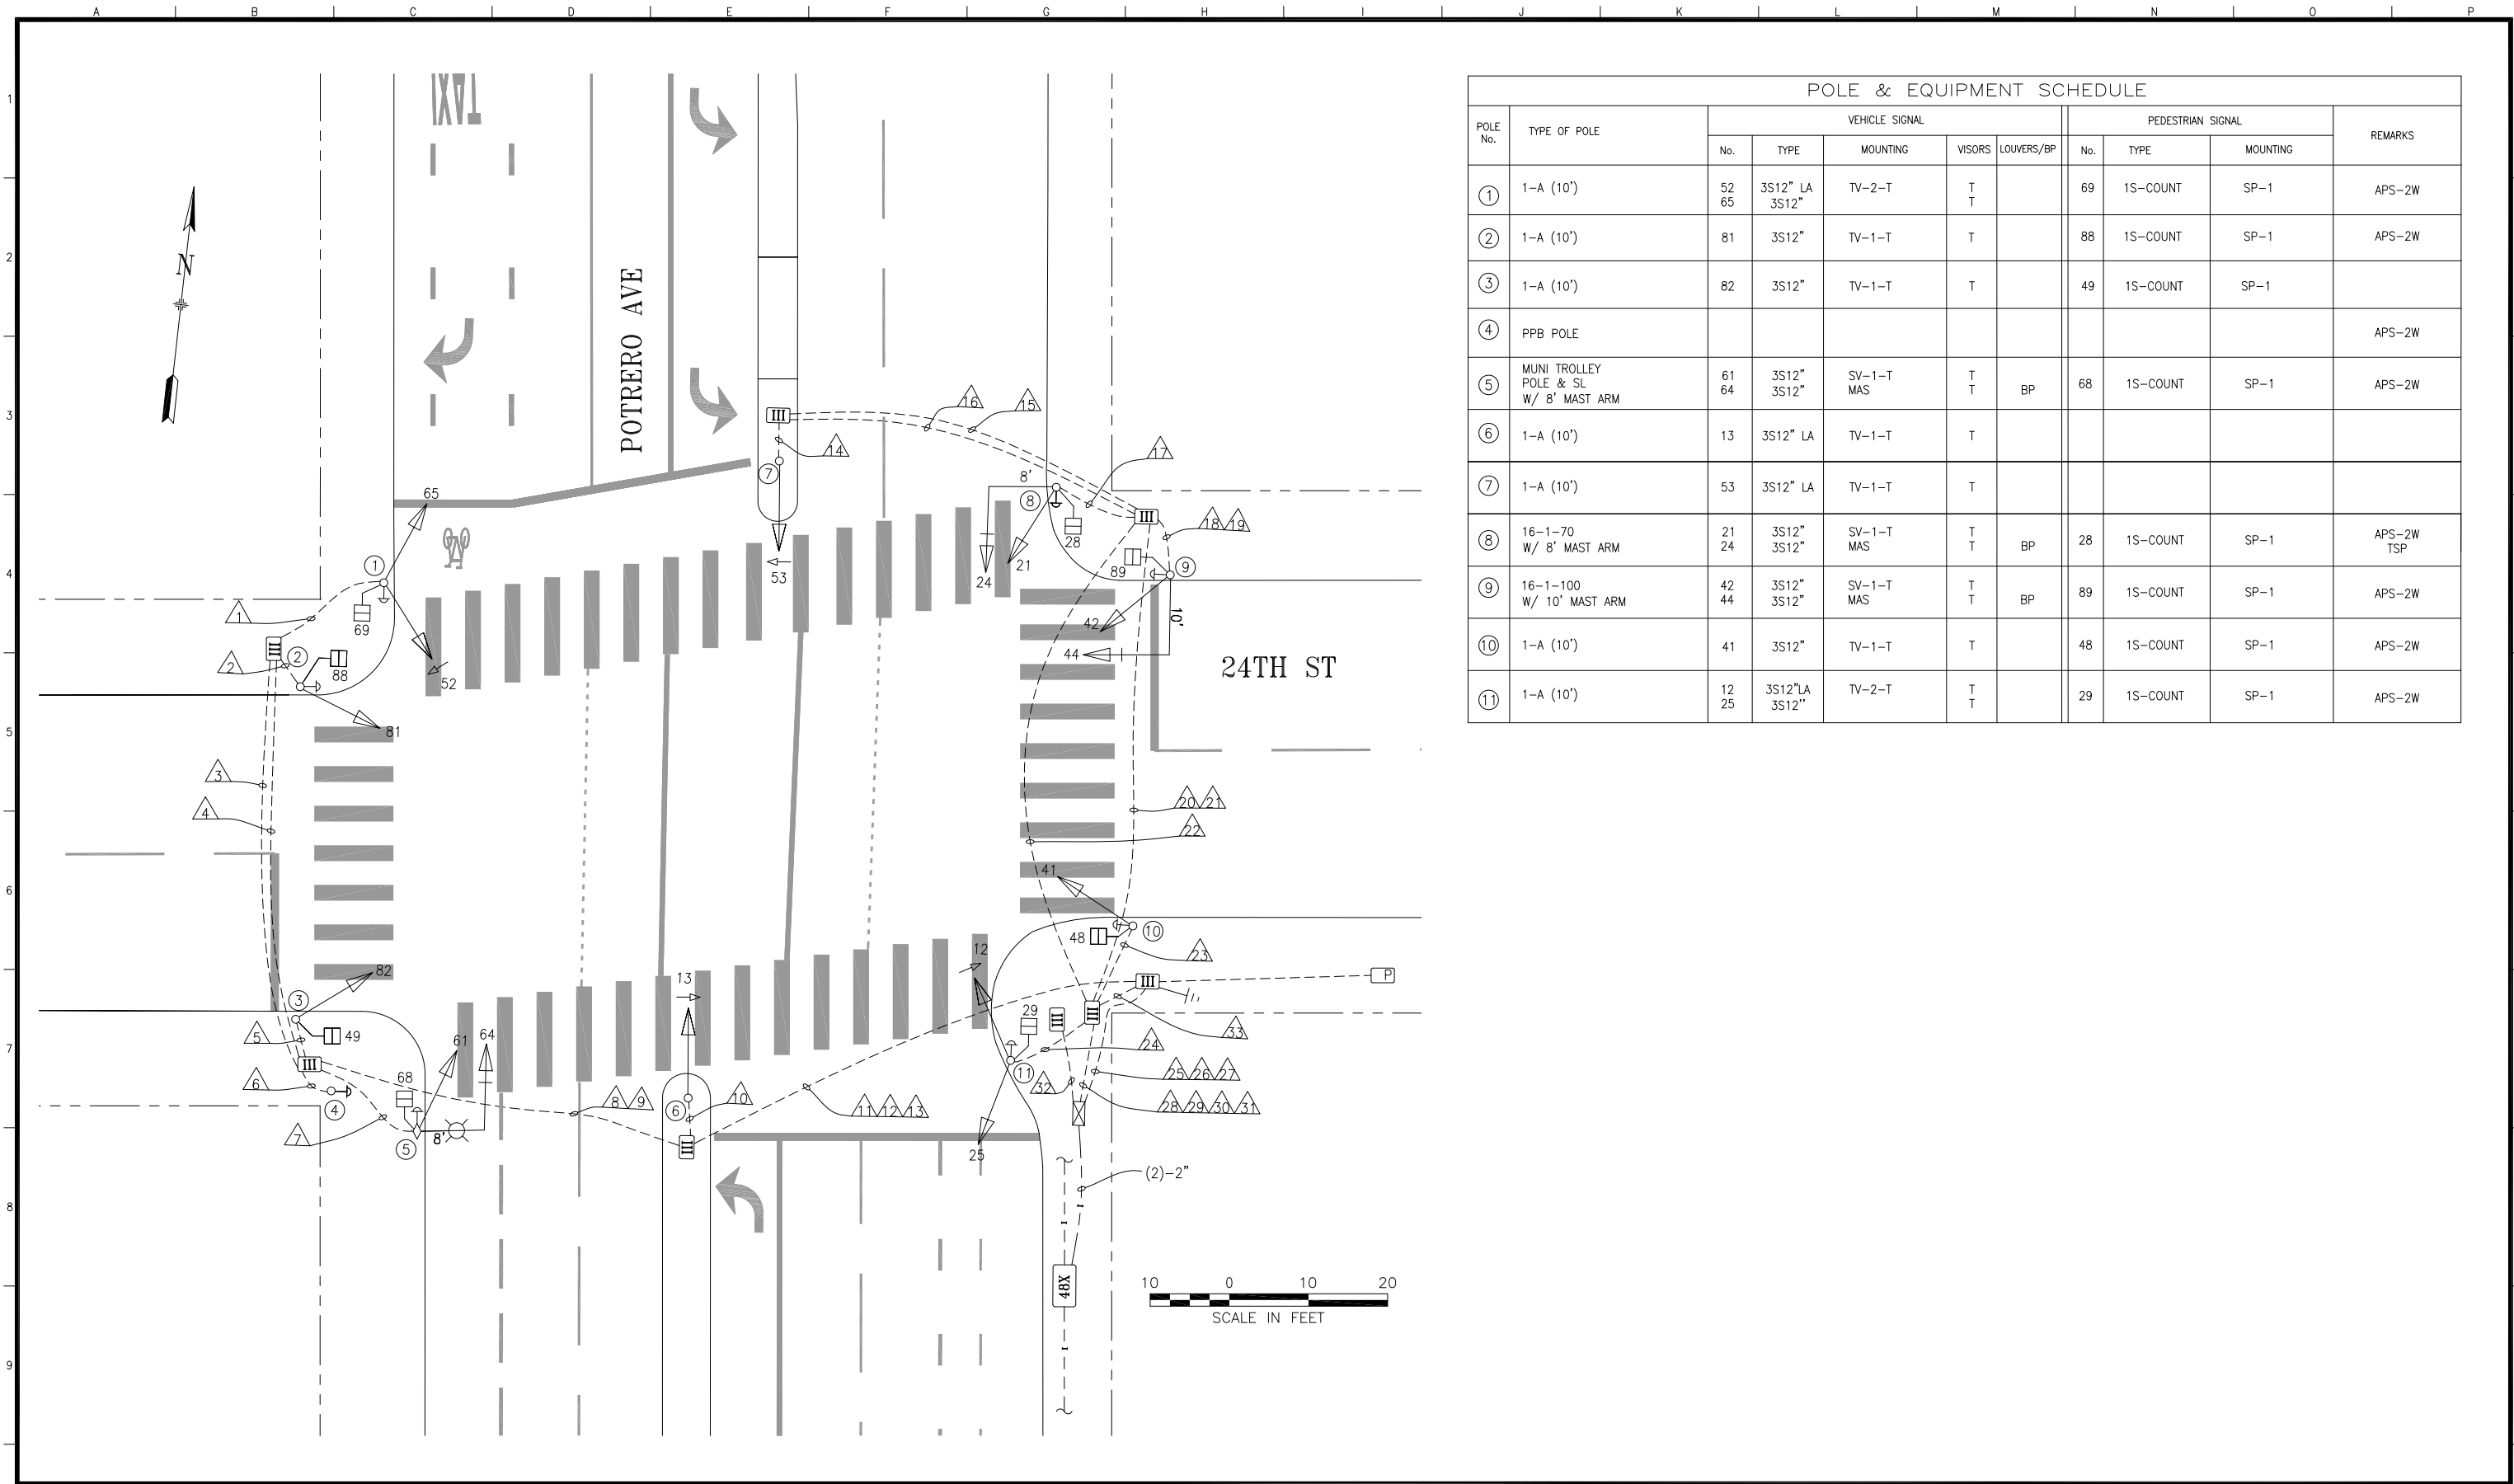

POLE & EQUIPMENT SCHEDULE										
POLE No.	TYPE OF POLE	VEHICLE SIGNAL					PEDESTRIAN SIGNAL			REMARKS
		No.	TYPE	MOUNTING	VISORS	LOUVERS/BP	No.	TYPE	MOUNTING	
①	1-A (10')	52 65	3S12" LA 3S12"	TV-2-T	T T		69	1S-COUNT	SP-1	APS-2W
②	1-A (10')	81	3S12"	TV-1-T	T		88	1S-COUNT	SP-1	APS-2W
③	1-A (10')	82	3S12"	TV-1-T	T		49	1S-COUNT	SP-1	
④	PPB POLE									APS-2W
⑤	MUNI TROLLEY POLE & SL W/ 8' MAST ARM	61 64	3S12" LA 3S12"	SV-1-T MAS	T T	BP	68	1S-COUNT	SP-1	APS-2W
⑥	1-A (10')	13	3S12" LA	TV-1-T	T					
⑦	1-A (10')	53	3S12" LA	TV-1-T	T					
⑧	16-1-70 W/ 8' MAST ARM	21 24	3S12" LA 3S12"	SV-1-T MAS	T T	BP	28	1S-COUNT	SP-1	APS-2W TSP
⑨	16-1-100 W/ 10' MAST ARM	42 44	3S12" LA 3S12"	SV-1-T MAS	T T	BP	89	1S-COUNT	SP-1	APS-2W
⑩	1-A (10')	41	3S12"	TV-1-T	T		48	1S-COUNT	SP-1	APS-2W
⑪	1-A (10')	12 25	3S12" LA 3S12"	TV-2-T	T T		29	1S-COUNT	SP-1	APS-2W

0	10/26/17	UPGRADED BY 2127J; CONVERTED FROM AS-BUILTS	Hfu	Vventura	
NO.	DATE	DESCRIPTION	BY	APP.	
TABLE OF REVISIONS					
CHECK WITH TRACING TO SEE IF YOU HAVE LATEST REVISION					

REFERENCE INFORMATION & FILE NO. OF SURVEYS



SAN FRANCISCO MUNICIPAL TRANSPORTATION AGENCY

CITY AND COUNTY OF SAN FRANCISCO

DRAWN:	DATE:
H.YU	07/2019
CHECKED:	DATE:
L.VENTURA	09/2020

SCALE:
AS SHOWN
SHEET OF SHEETS
1 OF 2

TRAFFIC SIGNAL INVENTORY DIAGRAM
24TH STREET AND POTRERO AVENUE

CNN NO.
23953000
REV NO.
0

