


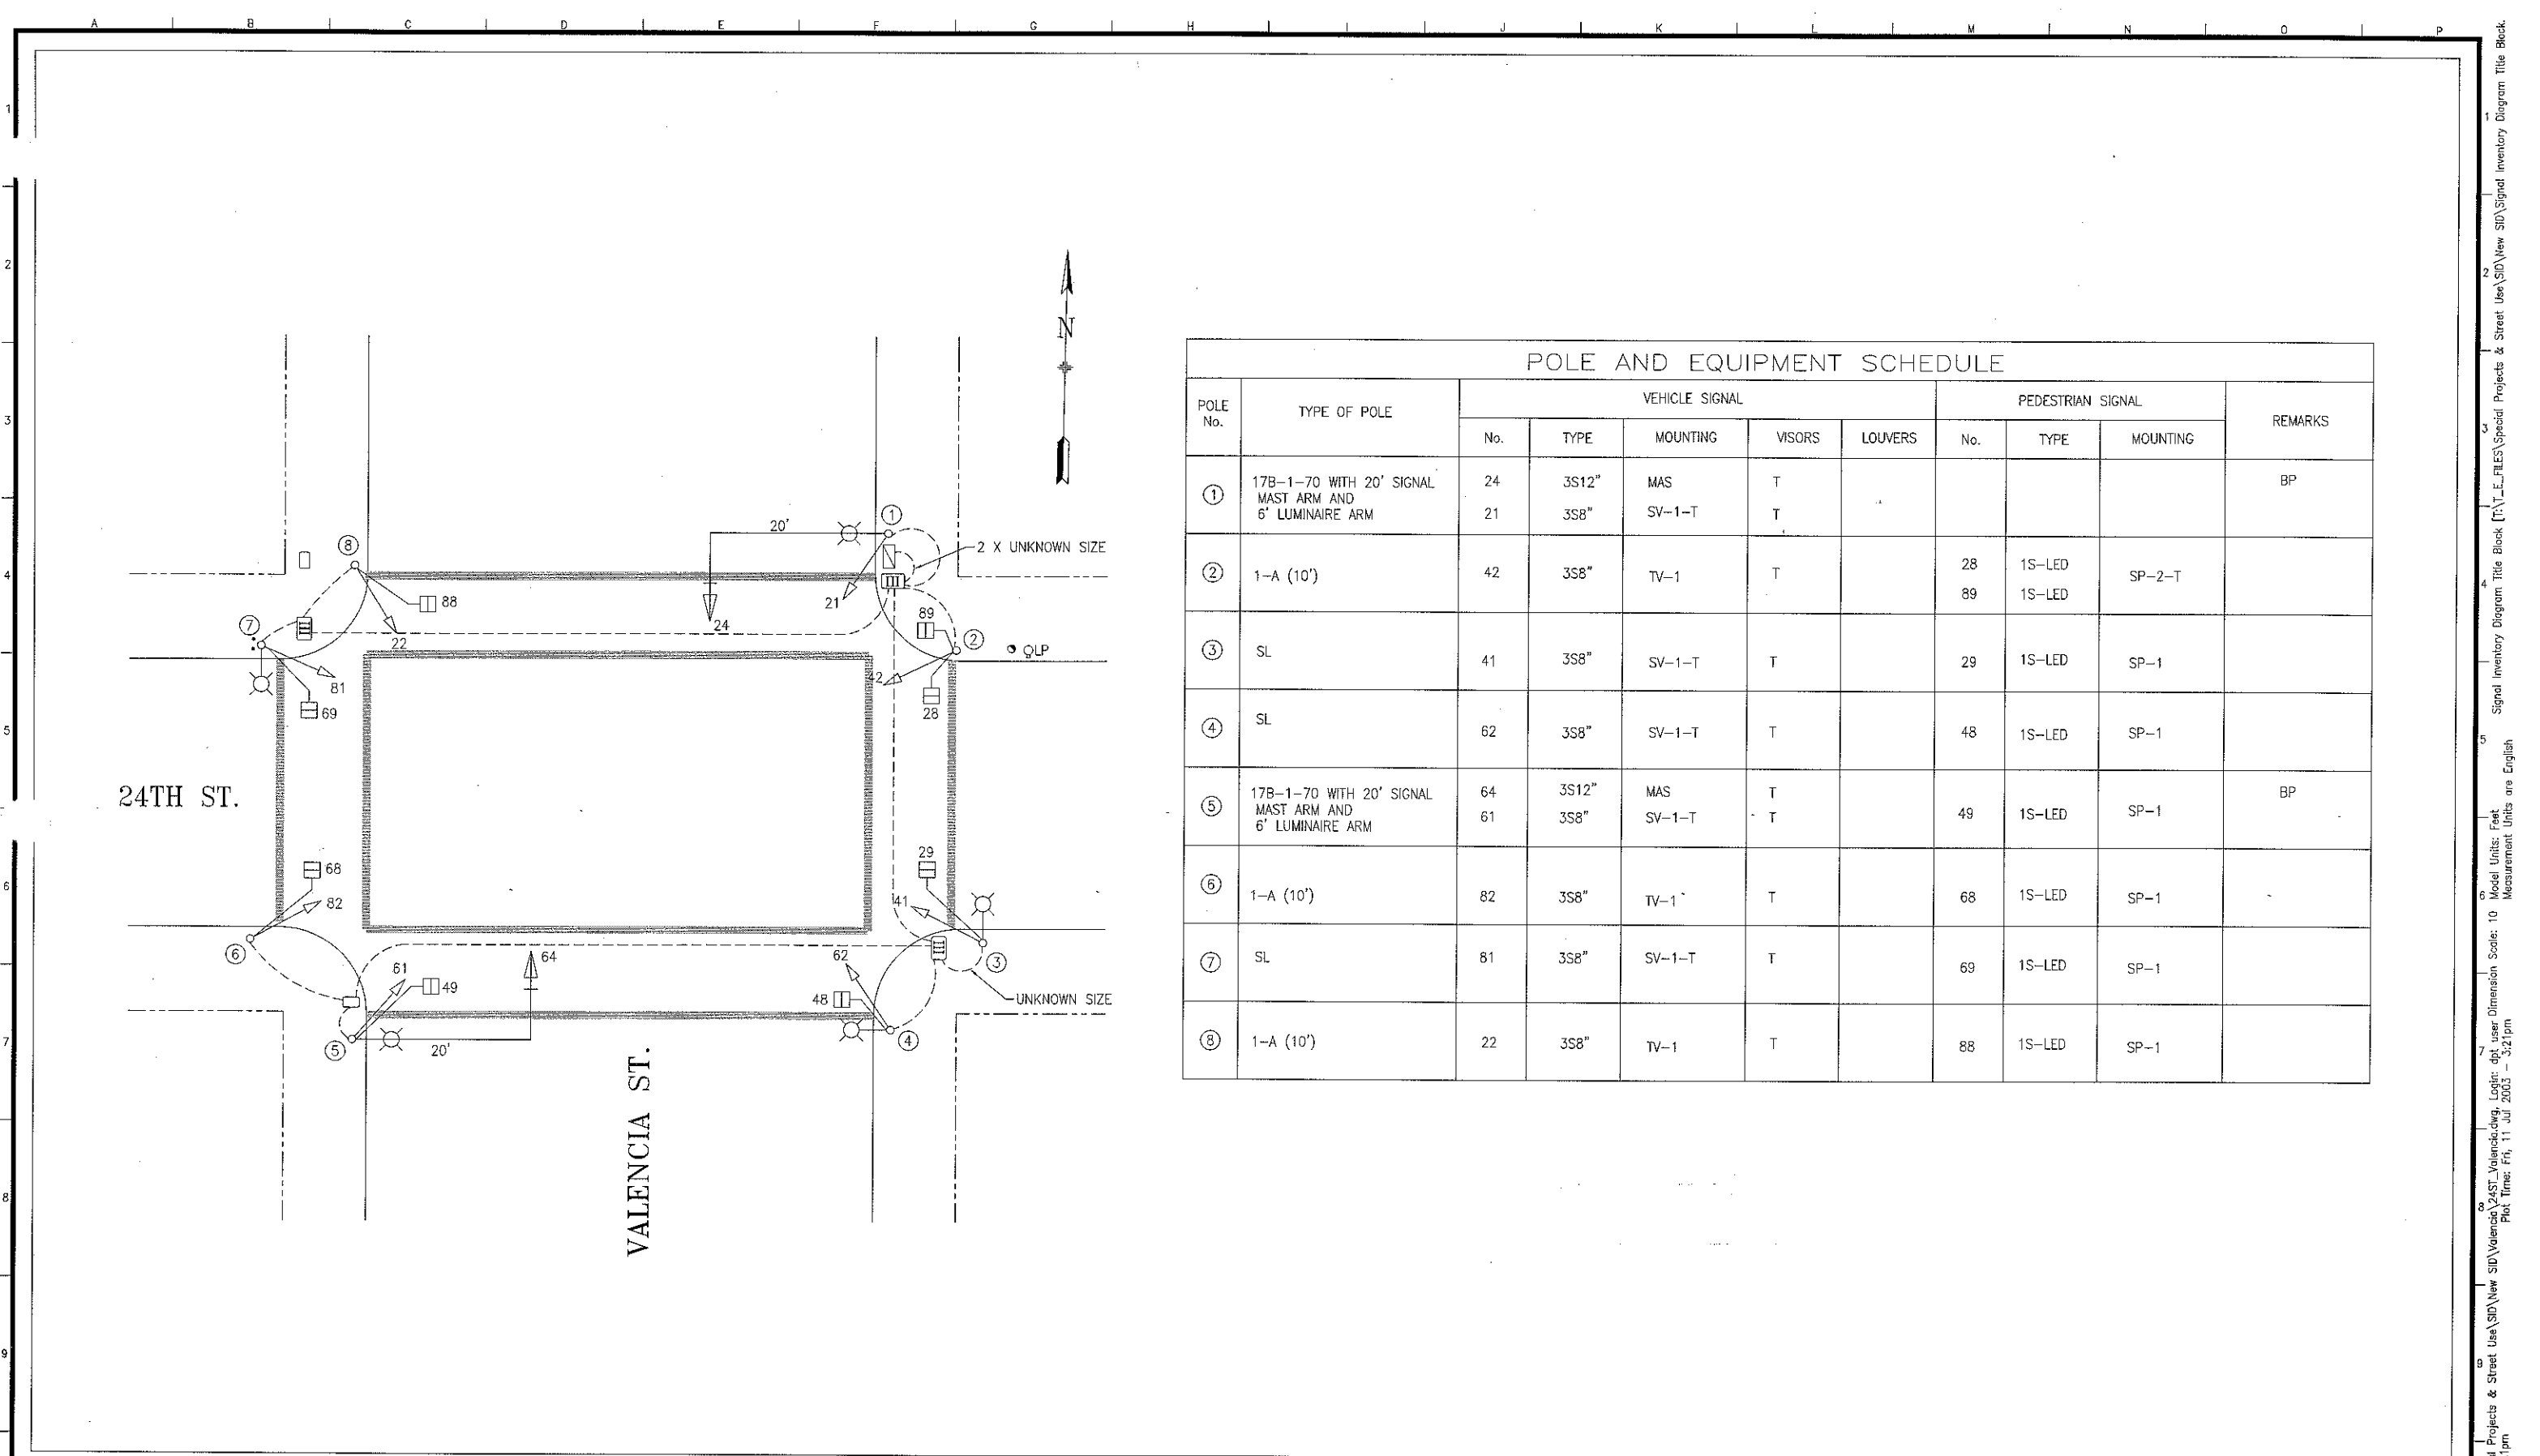

POLE AND EQUIPMENT SCHEDULE										
POLE No.	TYPE OF POLE	VEHICLE SIGNAL					PEDESTRIAN SIGNAL			REMARKS
		No.	TYPE	MOUNTING	VISORS	LOUVERS	No.	TYPE	MOUNTING	
①	17B-1-70 WITH 20' SIGNAL MAST ARM AND 6' LUMINAIRE ARM	24	3S12"	MAS	T					BP
		21	3S8"	SV-1-T	T					
②	1-A (10')	42	3S8"	TV-1	T		28	1S-LED	SP-2-T	
							89	1S-LED		
③	SL	41	3S8"	SV-1-T	T		29	1S-LED	SP-1	
④	SL	62	3S8"	SV-1-T	T		48	1S-LED	SP-1	
⑤	17B-1-70 WITH 20' SIGNAL MAST ARM AND 6' LUMINAIRE ARM	64	3S12"	MAS	T		49	1S-LED	SP-1	BP
		61	3S8"	SV-1-T	T					
⑥	1-A (10')	82	3S8"	TV-1	T		68	1S-LED	SP-1	
⑦	SL	81	3S8"	SV-1-T	T		69	1S-LED	SP-1	
⑧	1-A (10')	22	3S8"	TV-1	T		88	1S-LED	SP-1	

NO.		DATE	DESCRIPTION		BY	APP.	COMPLETION DATE / ELECTRICIAN INITIAL		DEPARTMENT OF PARKING AND TRAFFIC DIVISION OF TRAFFIC ENGINEERING CITY AND COUNTY OF SAN FRANCISCO	DRAWN: CXL DATE: 4/03 SCALE: 1" = 20'	CHECKED: PSZ DATE: 7/24/03 SHEET OF SHEETS: 1 OF 1	TRAFFIC SIGNAL INVENTORY DIAGRAM		CNN NO. 24101000
			TABLE OF REVISIONS CHECK WITH TRACING TO SEE IF YOU HAVE LATEST REVISION									24TH ST AND VALENCIA ST		REV. NO.

Drawing Path: T:\T_E_FILES\Special Projects & Street Use\New SID\New SID\T_E_FILES\Special Projects & Street Use\New SID\New SID\Inventory Diagram Title Block
Plot Time: Fri, 11 Jul 2003 - 3:21pm
Model Units: Feet
Measurement Units are English