


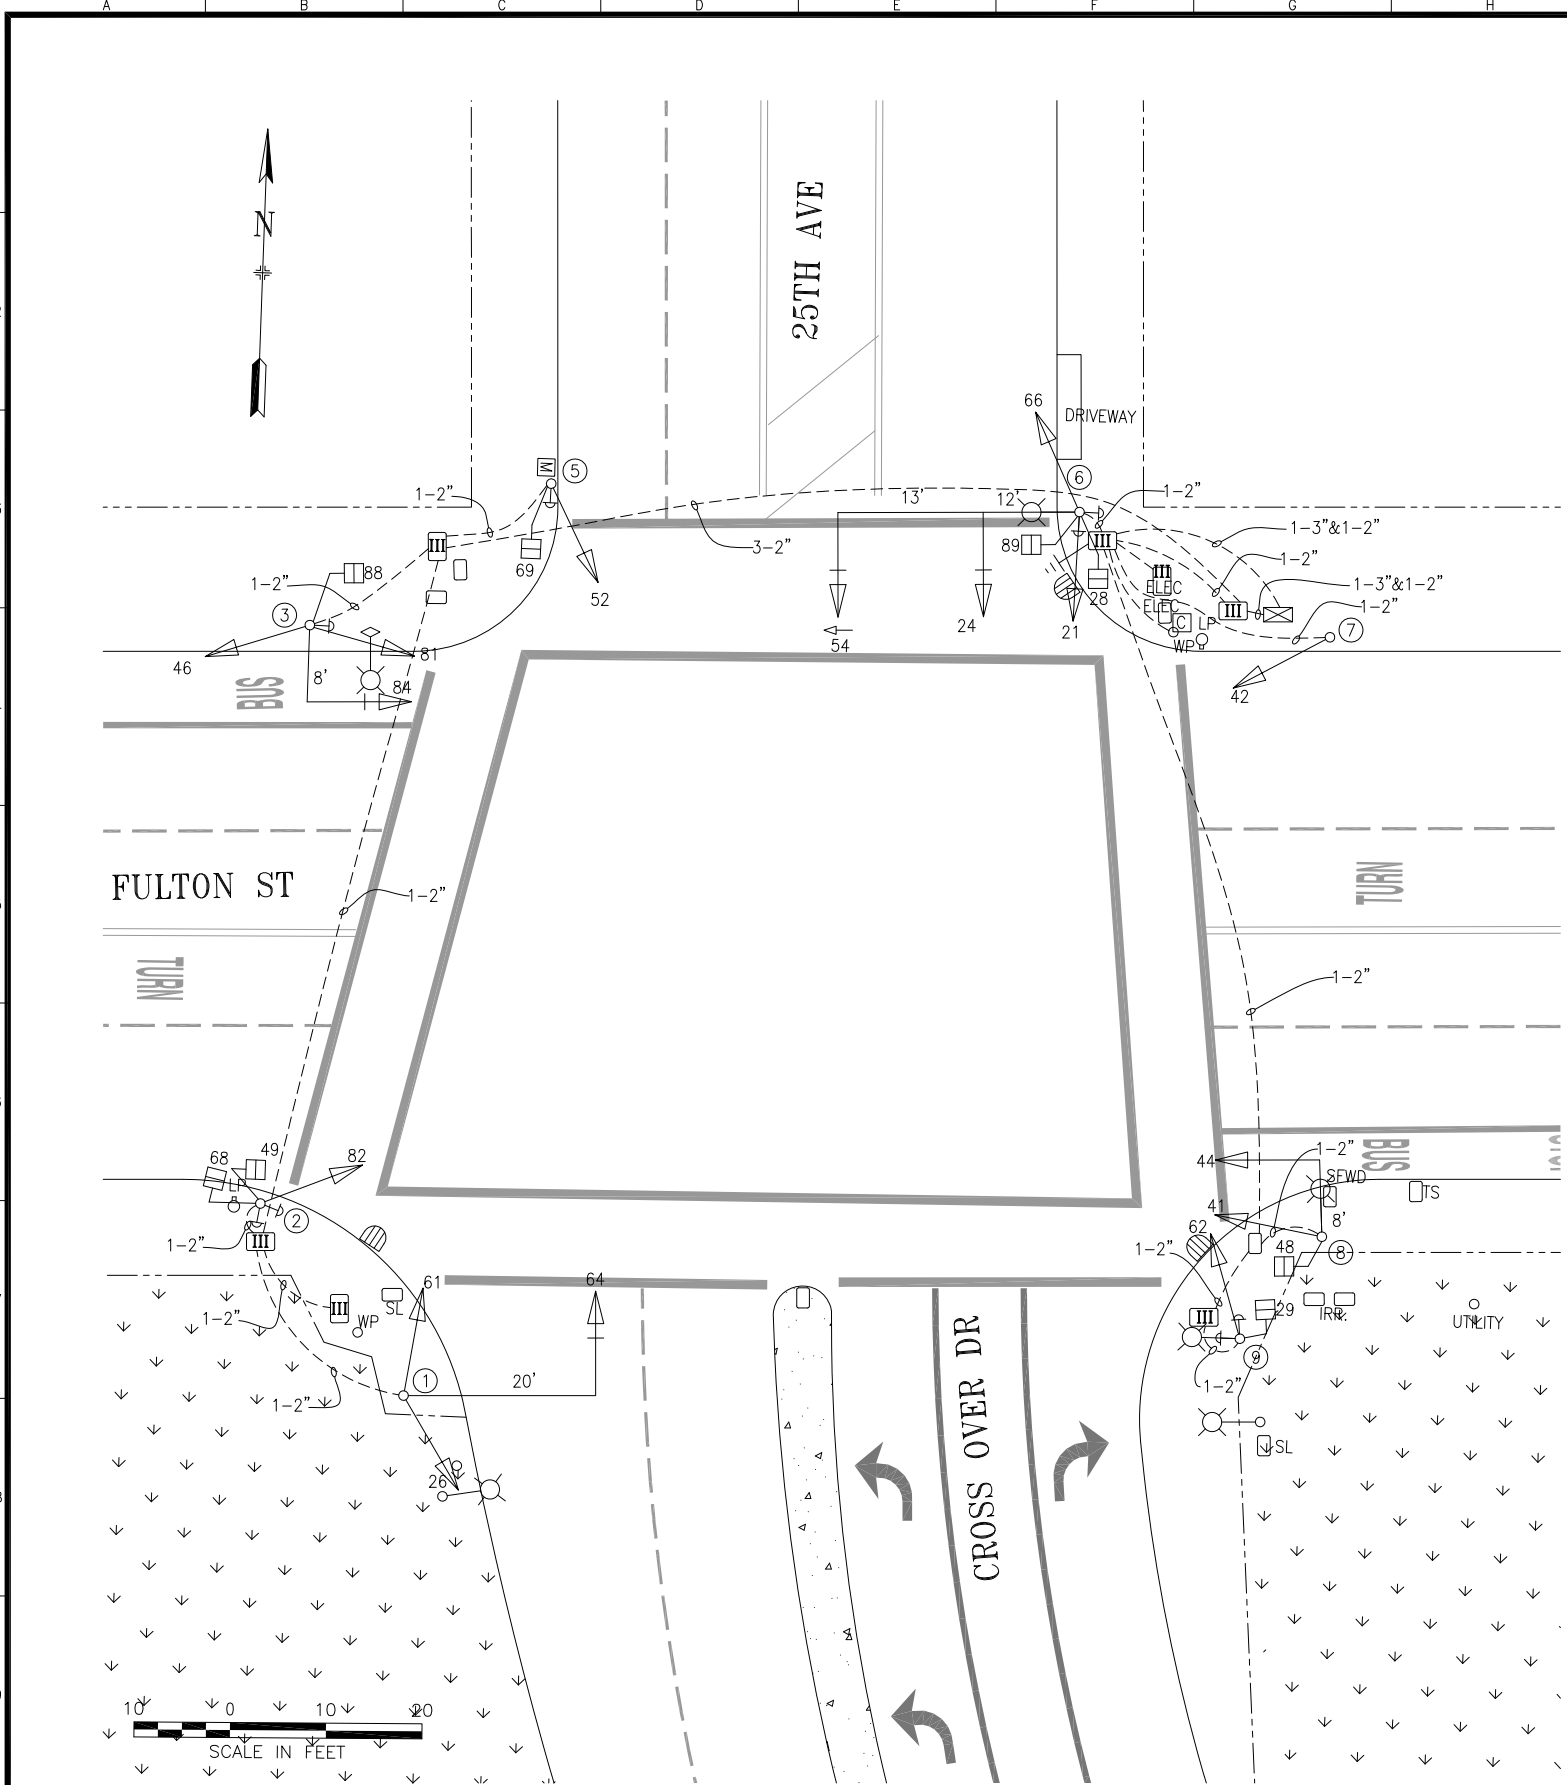

POLE AND EQUIPMENT SCHEDULE											
POLE No.	TYPE OF POLE	LUMINAIRE VOLTAGE/WATTAGE	VEHICLE SIGNAL					PEDESTRIAN SIGNAL			REMARKS
			No.	TYPE	MOUNTING	VISORS	LOUVERS	No.	TYPE	MOUNTING	
①	16-1-100 WITH 20' MAST ARM		26 61 64	3S12" 3S12" 3S12"	SV-2-TA MAS	T T T					BACKPLATE
②	1-A (10')		82	3S12"	TV-1-T	T		49 68	1S-COUNT 1S-COUNT	SP-1-SF (12") SP-1 (22")	APS PPB APS PPB
③	16-1-100 WITH 8' MAST ARM		46 81 84	3S12" 3S12" 3S12"	SV-2-TA MAT	T T T		88	1S-COUNT	SP-1	APS PPB BACKPLATE
⑤	1-A (10')		52	3S12" LA	TV-1-T	T		69	1S-COUNT	SP-1	APS PPB
⑥	19-2-100 WITH 25' MAST ARM & 6' LUMINAIRE	HPS 120V/200W	21 66 24 54	3S12" 3S12" 3S12" 3S12" LA	SV-2-T MAS MAS	T T T T		89 28	1S-COUNT 1S-COUNT	SP-1-SF (12") SP-1 (22")	APS PPB X 2 BACKPLATE X 2
⑦	1-A (10')		42	3S12"	TV-1-T	T					
⑧	19-1-100 w/ 8' MAST ARM & 6' LUMINAIRE	HPS 120V/200W	41 44	3S12" 3S12"	SV-1-T MAS	T T		29	1S-COUNT	SP-1	BACKPLATE
⑨	CITY STANDARD STREET LIGHT	HPS 120V/200W	62	3S12"	SV-1-T	T		48	1S-COUNT	SP-1	APS PPB X 2

NO.	DATE	DESCRIPTION	BY	APP.
1	3/30/15	APS ACTIVATED PER SRC 2014-295	JH	MV
1	12/XX/14	SIGNAL 66 ADDED AFTER SWITCHOVER BY CHANGE ORDER TO 2108J	JH	MV
0	6/17/14	UPGRADE ACTIVATED THRU 2108J; CONVERTED FROM CONTRACT PLAN	JH	MV
TABLE OF REVISIONS				
CHECK WITH TRACING TO SEE IF YOU HAVE LATEST REVISION				

REFERENCE INFORMATION & FILE NO. OF SURVEYS
--



SAN FRANCISCO MUNICIPAL TRANSPORTATION AGENCY

CITY AND COUNTY OF SAN FRANCISCO

DRAWN: JH	DATE: 09/2015
CHECKED: MV	DATE: 09/2015

SCALE: AS SHOWN
SHEET OF SHEETS 1 OF 1

TRAFFIC SIGNAL INVENTORY DIAGRAM
25TH AVE, CROSSOVER DR AND FULTON ST

CNN NO. 27519000
REV NO. 2