


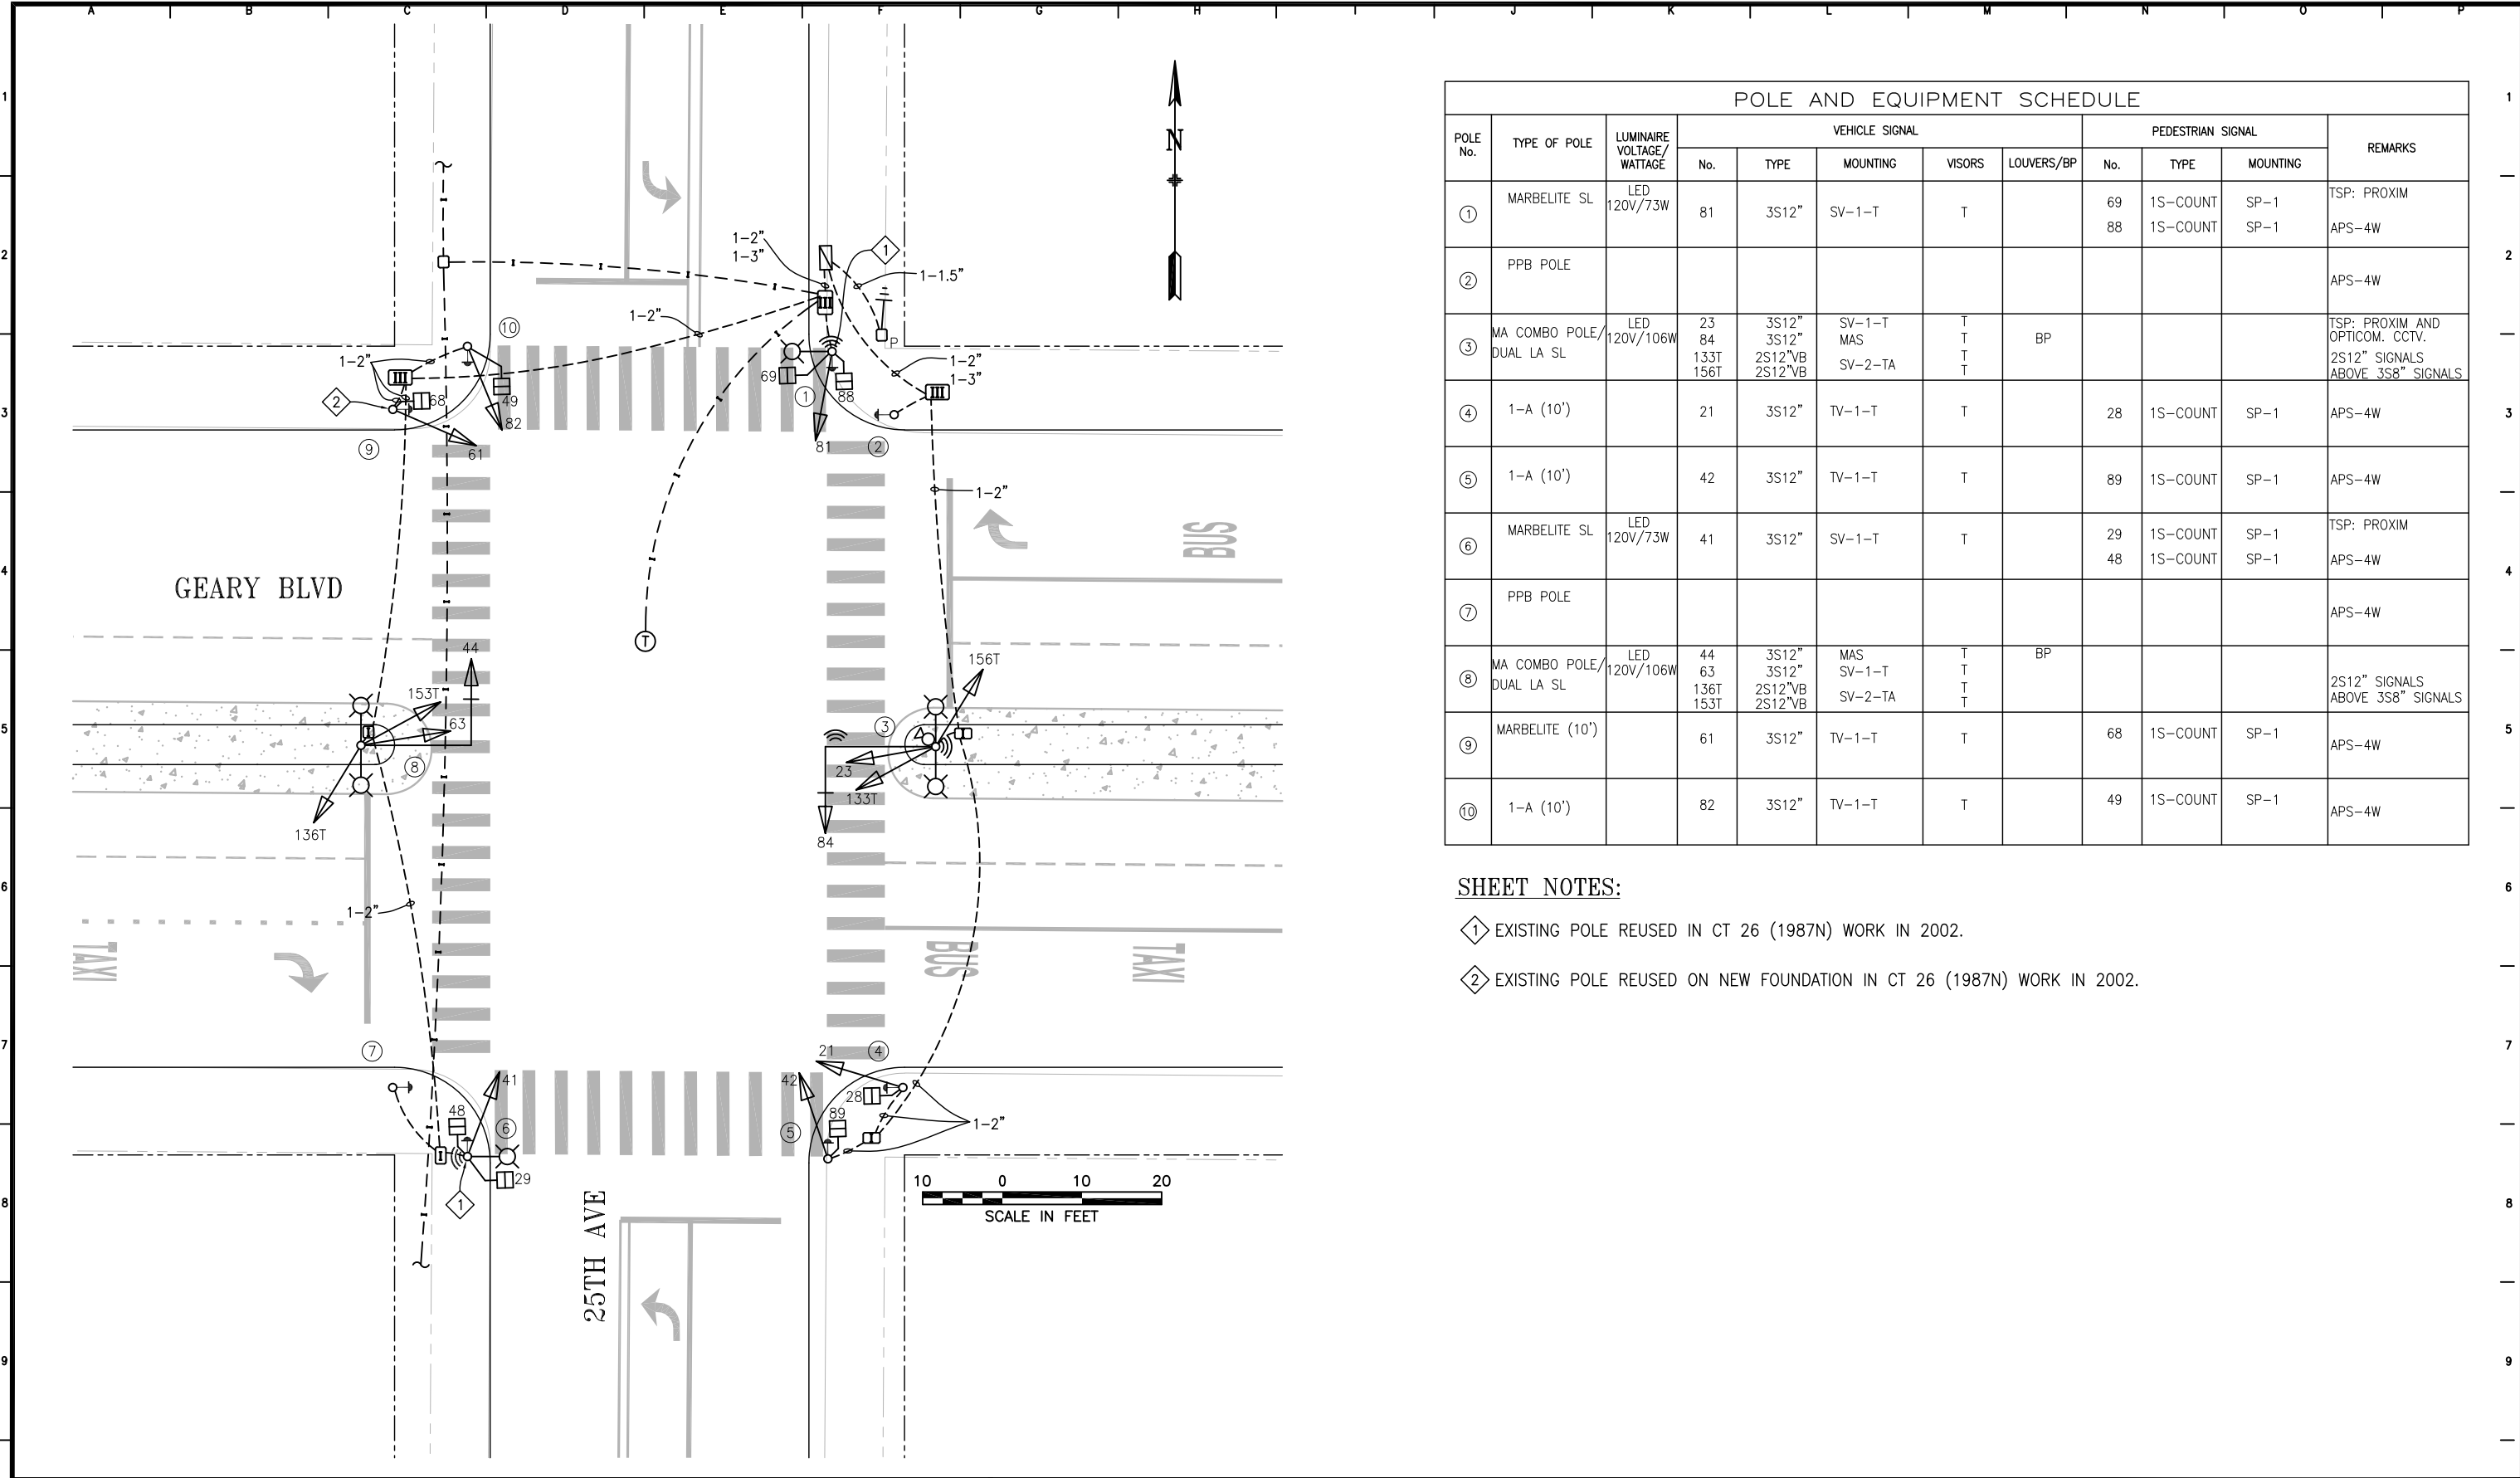

POLE AND EQUIPMENT SCHEDULE											
POLE No.	TYPE OF POLE	LUMINAIRE VOLTAGE/WATTAGE	VEHICLE SIGNAL					PEDESTRIAN SIGNAL			REMARKS
			No.	TYPE	MOUNTING	VISORS	LOUVERS/BP	No.	TYPE	MOUNTING	
①	MARBELITE SL	LED 120V/73W	81	3S12"	SV-1-T	T		69 88	1S-COUNT 1S-COUNT	SP-1 SP-1	TSP: PROXIM APS-4W
②	PPB POLE										APS-4W
③	MA COMBO POLE/ DUAL LA SL	LED 120V/106W	23 84 133T 156T	3S12" 3S12" 2S12"VB 2S12"VB	SV-1-T MAS SV-2-TA	T T T T	BP				TSP: PROXIM AND OPTICOM. CCTV. 2S12" SIGNALS ABOVE 3S8" SIGNALS
④	1-A (10')		21	3S12"	TV-1-T	T		28	1S-COUNT	SP-1	APS-4W
⑤	1-A (10')		42	3S12"	TV-1-T	T		89	1S-COUNT	SP-1	APS-4W
⑥	MARBELITE SL	LED 120V/73W	41	3S12"	SV-1-T	T		29 48	1S-COUNT 1S-COUNT	SP-1 SP-1	TSP: PROXIM APS-4W
⑦	PPB POLE										APS-4W
⑧	MA COMBO POLE/ DUAL LA SL	LED 120V/106W	44 63 136T 153T	3S12" 3S12" 2S12"VB 2S12"VB	MAS SV-1-T SV-2-TA	T T T T	BP				2S12" SIGNALS ABOVE 3S8" SIGNALS
⑨	MARBELITE (10')		61	3S12"	TV-1-T	T		68	1S-COUNT	SP-1	APS-4W
⑩	1-A (10')		82	3S12"	TV-1-T	T		49	1S-COUNT	SP-1	APS-4W

SHEET NOTES:

- ① EXISTING POLE REUSED IN CT 26 (1987N) WORK IN 2002.
- ② EXISTING POLE REUSED ON NEW FOUNDATION IN CT 26 (1987N) WORK IN 2002.

0 12/18/20		INSTALLED TRANSIT SIGNALS (ø13 & ø15) FOR GEARY EB & WB VIA SRC 2020-283; CONVERTED FROM SRC 2020-208 MARKUP.	D. MACKOWSKI	K. KWONG
NO.	DATE	DESCRIPTION	BY	APPROVED
TABLE OF REVISIONS CHECKOUT DRAWING THROUGH THE SID CUSTODIAN FOR THE LATEST REVISION				



SFMTA

SEE CT 26 (1987N) E-3.0 FILE #74,253 FOR 8/20/2002 AS-BUILT DRAWING	
DRAWN BY: D. MACKOWSKI	DATE: 06/23/21
CHECKED BY: K. KWONG	DATE: 07/23/21

SCALE
AS SHOWN
SHEET OF SHEETS
1 OF 1

TRAFFIC SIGNAL INVENTORY DIAGRAM
25TH AVE & GEARY BLVD

CNN NO: 27553000
REV NO: 0