




5	1/27/19	SRC 2018-193: CONVERT "I" TO BAR FOR SIGNALS LRV2A, LRV2B, LRV6A & LRV6B & NEW TS SIGNALS	TY	CL
4	11/2016	PER FIELD: UPGRADED SIGNAL 25 TO 3-SECTION, 12-INCH RYG	TY	MV
3	4/2016	PER FIELD: REMOVED PPB FROM POLE 7	TY	MV
2	11/2013	PER FIELD: REMOVED PPB FROM POLES 9 & 10	TY	MV
1	4/2011	PER FIELD: UPGRADED SIGNAL 45 TO 3-SECTION, 12-INCH RYG	TY	MV
0	5/21/08	MUNI METRO EAST PROJECT	DRP	AH
NO.	DATE	DESCRIPTION	BY	APP.
TABLE OF REVISIONS CHECK WITH TRACING TO SEE IF YOU HAVE LATEST REVISION				

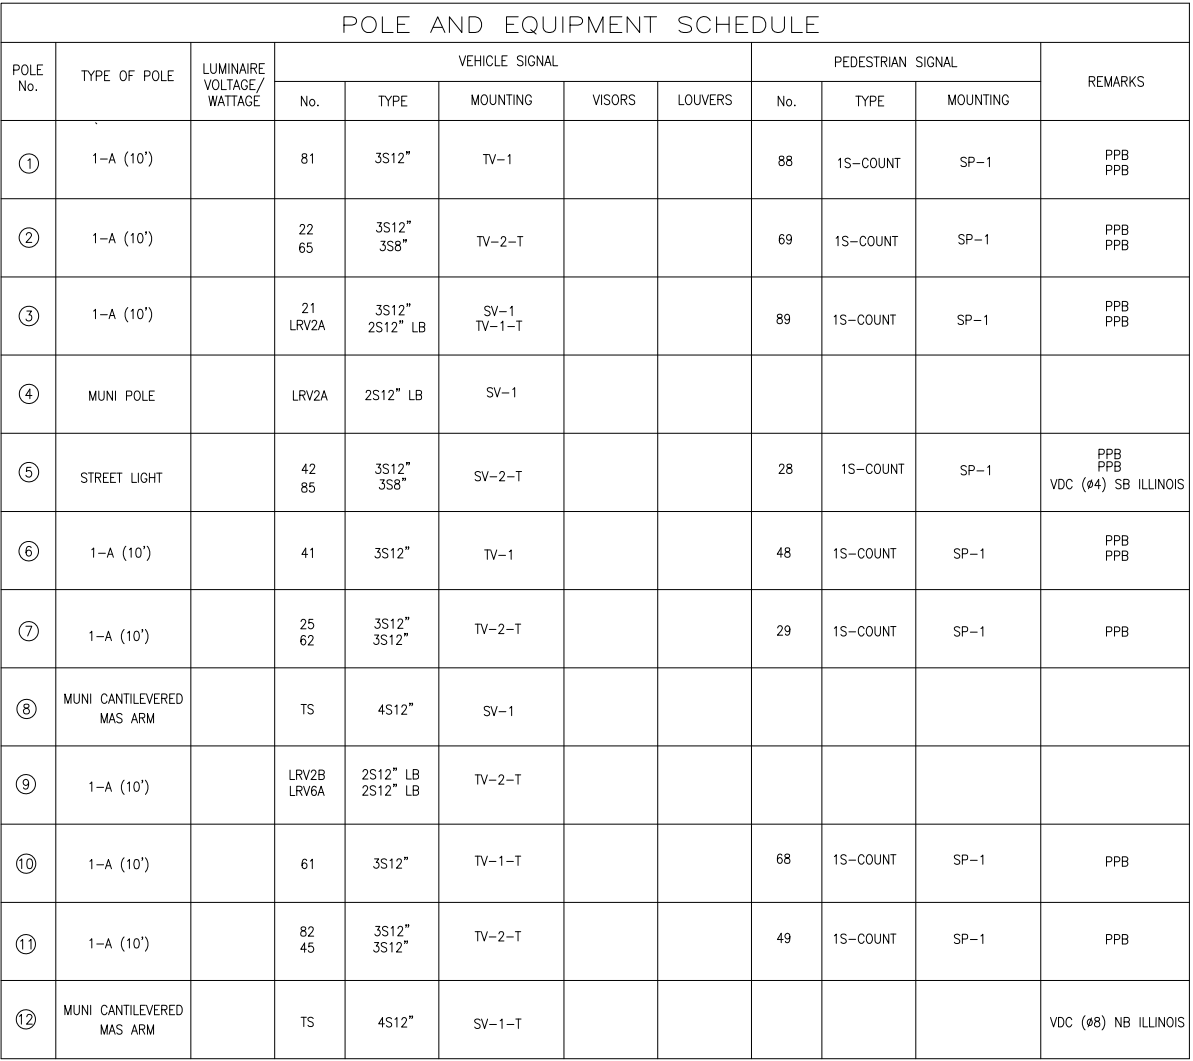

DRAWN:	DATE:	SCALE:
DRP	06/5/08	1" = 10'
CHECKED:	DATE:	SHEET OF SHEETS
AH	06/5/08	1 OF 1

TRAFFIC SIGNAL INVENTORY DIAGRAM

25TH STREET AND ILLINOIS STREET

CNN NO.
23534000
REV. NO.
5