


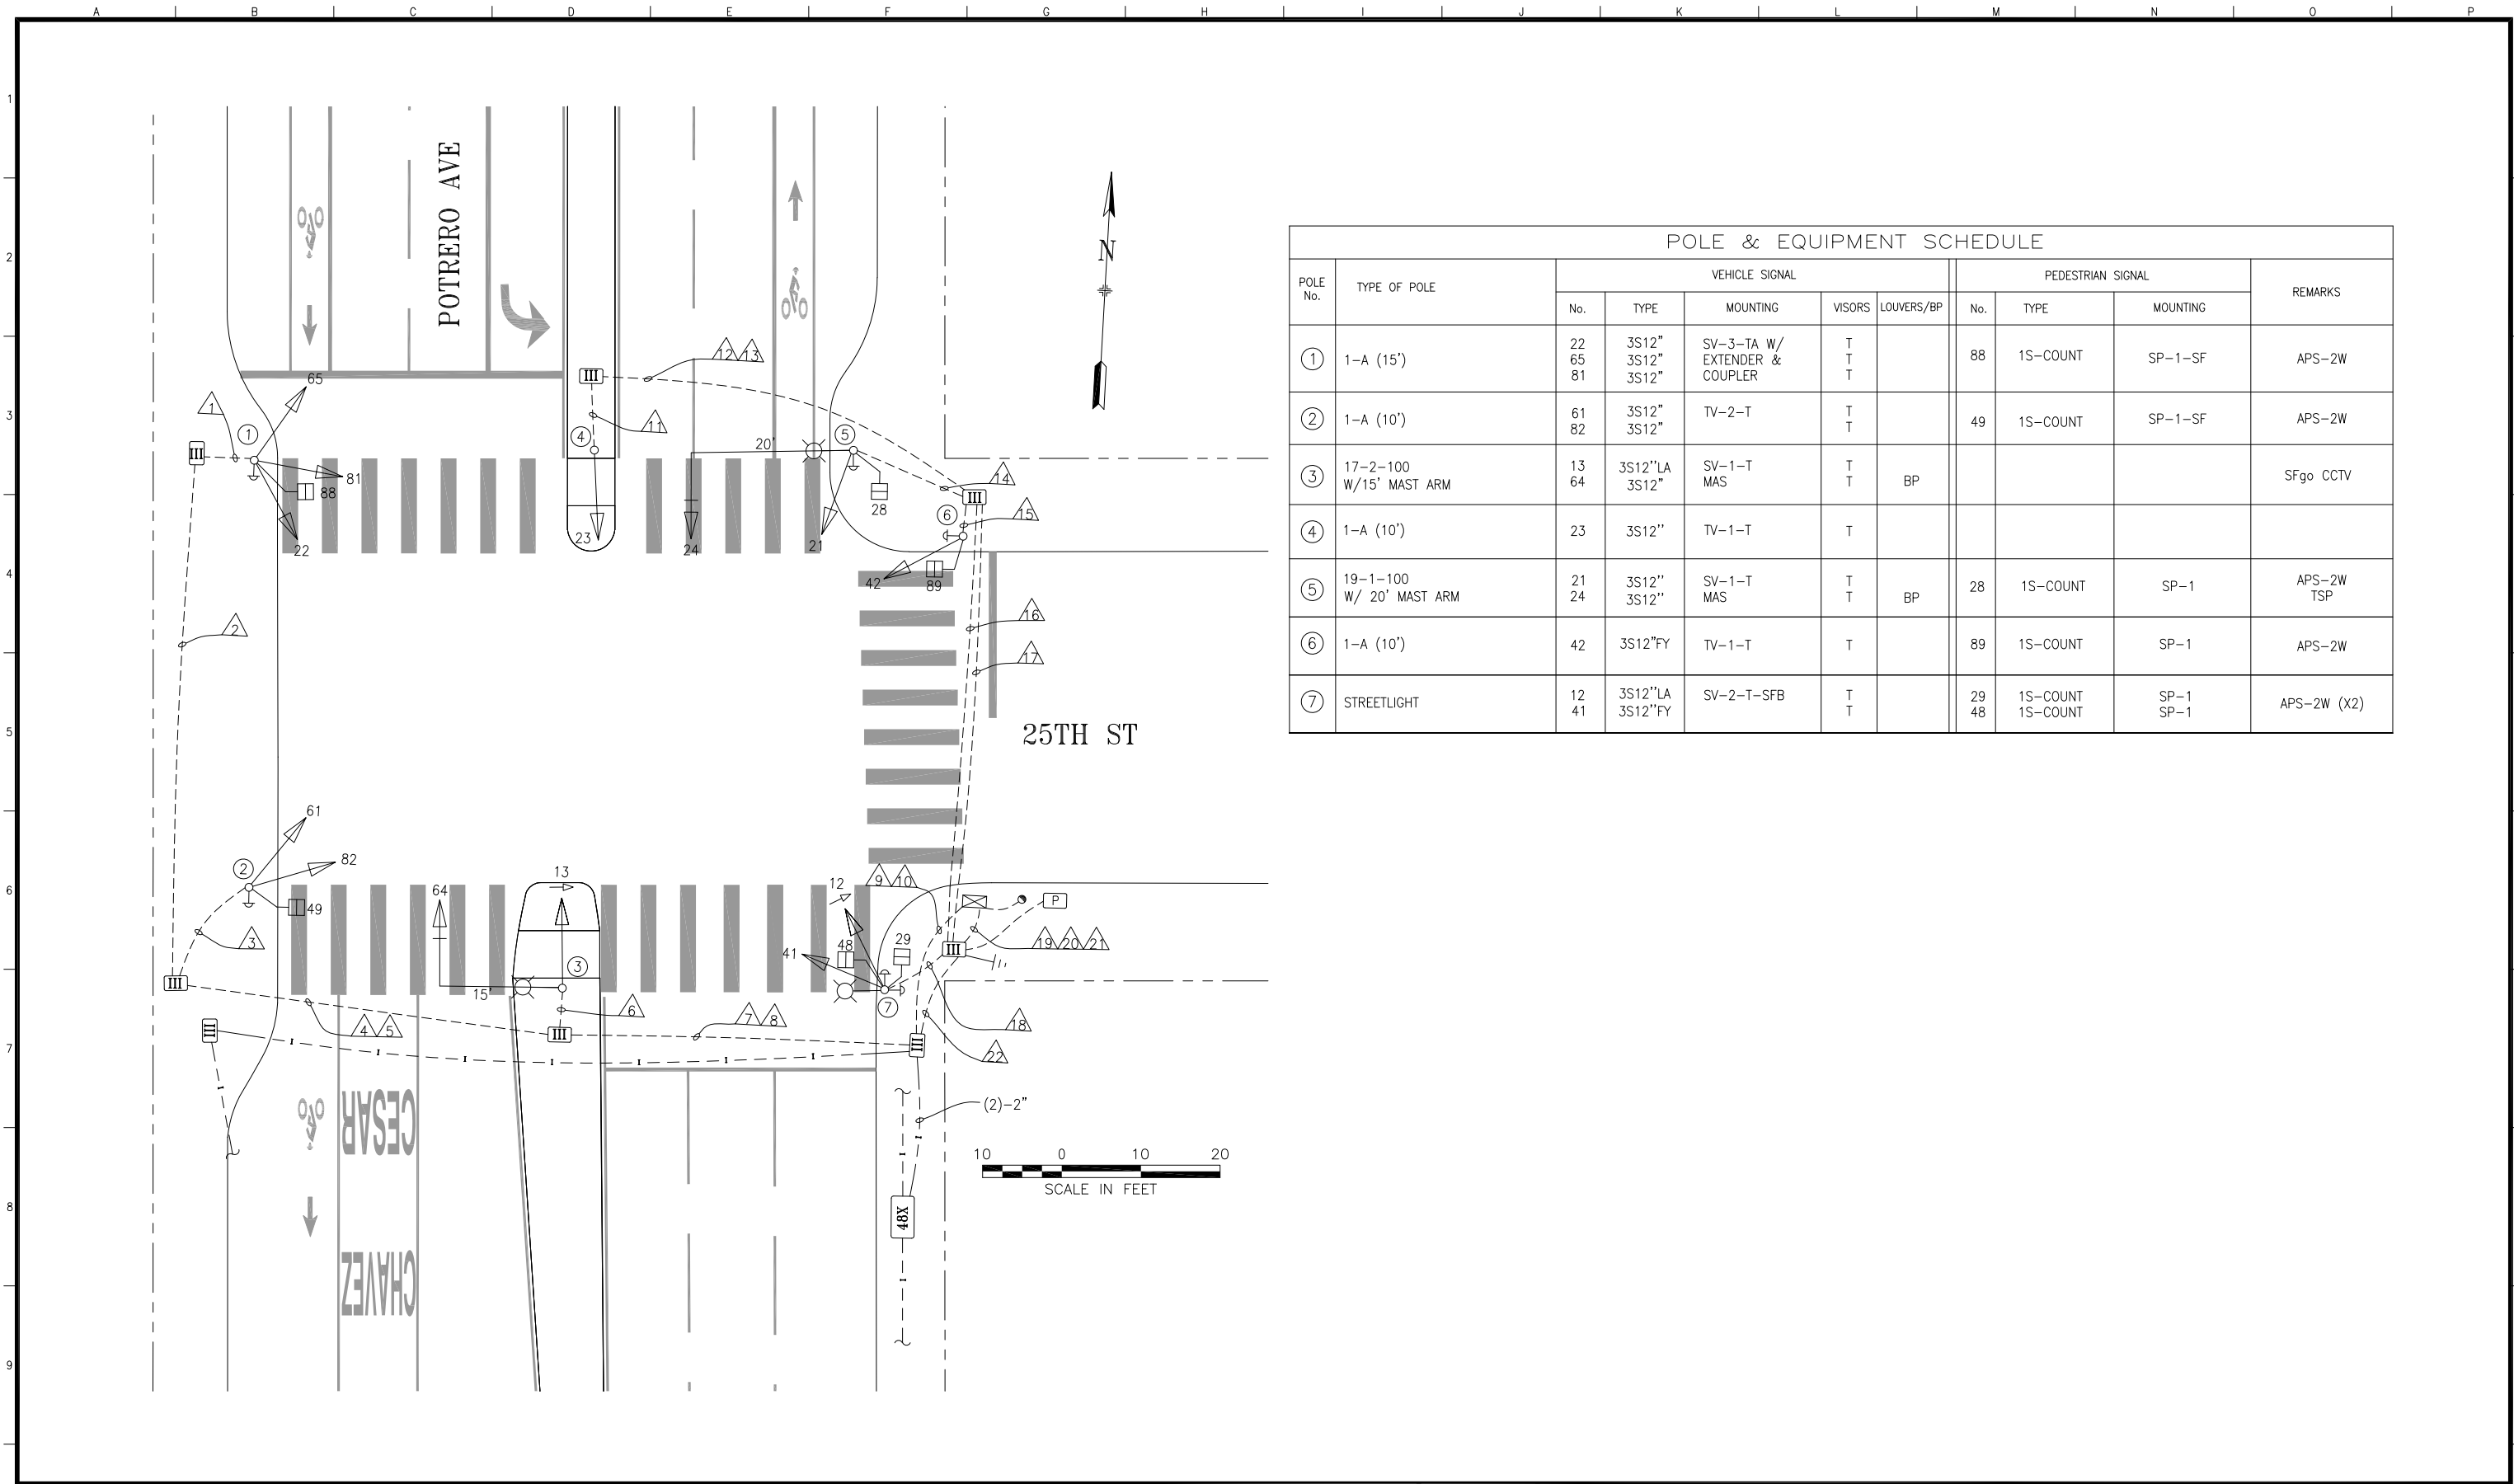

POLE & EQUIPMENT SCHEDULE										
POLE No.	TYPE OF POLE	VEHICLE SIGNAL					PEDESTRIAN SIGNAL			REMARKS
		No.	TYPE	MOUNTING	VISORS	LOUVERS/BP	No.	TYPE	MOUNTING	
①	1-A (15')	22 65 81	3S12" 3S12" 3S12"	SV-3-TA W/ EXTENDER & COUPLER	T T T		88	1S-COUNT	SP-1-SF	APS-2W
②	1-A (10')	61 82	3S12" 3S12"	TV-2-T	T T		49	1S-COUNT	SP-1-SF	APS-2W
③	17-2-100 W/15' MAST ARM	13 64	3S12"LA 3S12"	SV-1-T MAS	T T	BP				SFgo CCTV
④	1-A (10')	23	3S12"	TV-1-T	T					
⑤	19-1-100 W/ 20' MAST ARM	21 24	3S12" 3S12"	SV-1-T MAS	T T	BP	28	1S-COUNT	SP-1	APS-2W TSP
⑥	1-A (10')	42	3S12"FY	TV-1-T	T		89	1S-COUNT	SP-1	APS-2W
⑦	STREETLIGHT	12 41	3S12"LA 3S12"FY	SV-2-T-SFB	T T		29 48	1S-COUNT 1S-COUNT	SP-1 SP-1	APS-2W (X2)

0	01/23/18	UPGRADED BY 2127J; CONVERTED FROM AS-BUILTS	Hfu	Lventura	
NO.	DATE	DESCRIPTION	BY	APP.	
TABLE OF REVISIONS					
CHECK WITH TRACING TO SEE IF YOU HAVE LATEST REVISION					

REFERENCE INFORMATION & FILE NO. OF SURVEYS



SAN FRANCISCO MUNICIPAL TRANSPORTATION AGENCY

CITY AND COUNTY OF SAN FRANCISCO

DRAWN:	DATE:
H.YU	07/2019
CHECKED:	DATE:
L.VENTURA	09/2020

SCALE:
AS SHOWN
SHEET OF SHEETS
1 OF 2

TRAFFIC SIGNAL INVENTORY DIAGRAM
25TH STREET AND POTRERO AVENUE

CNN NO.
23952000
REV NO.
0

