


GUERRERO & 26TH ST.

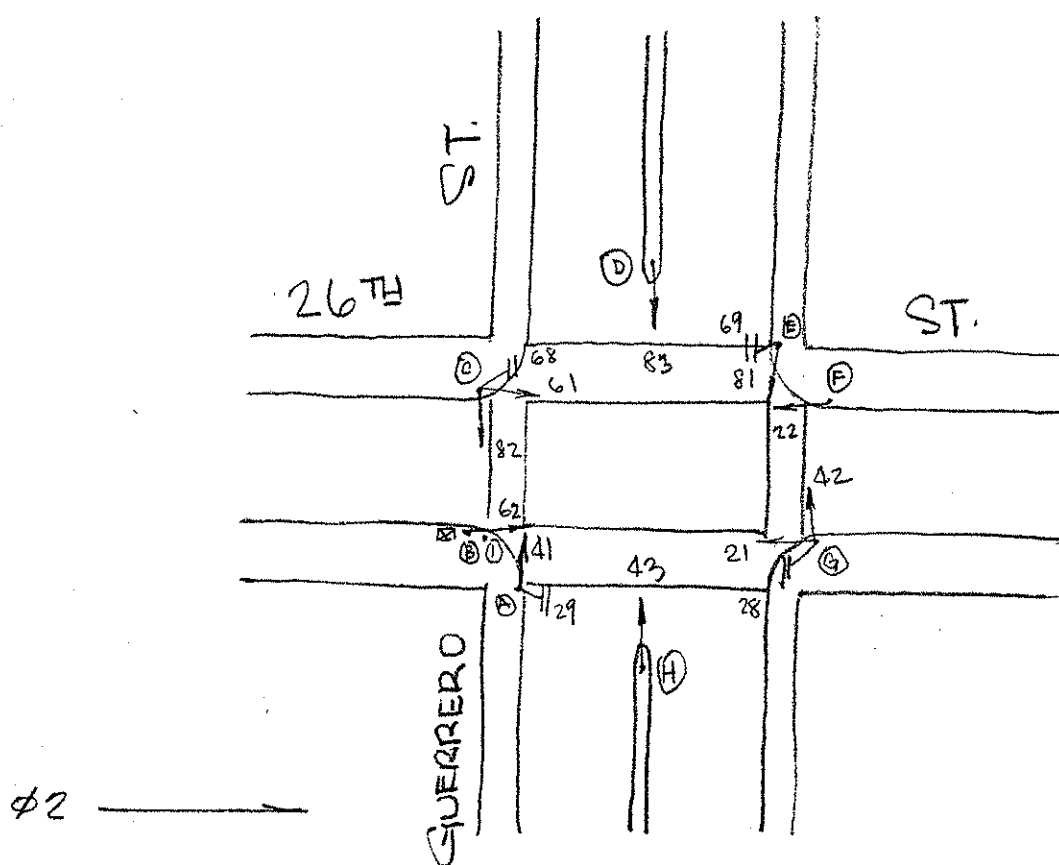

8-1-91

POLE	FUNC.	MAT'L	SIGNAL NO.	MAKE	NO. OF SECT.	SIZE	VISOR	B.P. OR LOUVERS	MOUN'T	PED SIGNAL NO.	LEGEND	MESSAGE		MAKE	MOUN'T
												ELEMENT	COLOR		
A	S	S	41	EA	3	8"	FL 8"	No	T	29	W/DW	GRD	W/OR	ED	S
B	L	S	62	EA	3	8"	FL 8"	No	S	68	W/DW	GRD	W/OR	ED	S
C	S	S	82	EA	3	8"	FL 8"	No	T	69	W/DW	GRD	W/OR	ED	S
D	L	S	61	EA	3	8"	FL 8"	No	T	28	I	15-1	W/OR	ICC	S
E	S	S	83	EA	3	8"	FL 8"	No	S						
F	L	S	81	EA	3	8"	FL 8"	No	T						
G	S	S	22	EA	3	8"	FL 8"	No	S						
H	L	S	42	EA	3	8"	FL 8"	No	T						
			21	EA	3	8"	FL 8"	No	T						
I	U	W	43	EA	3	8"	FL 8"	No	S						

CONTROLLER CABINET SIZE : ORDINARY BASE CABINET: YES

COMMENTS: Replaced ped. Signal # 28 with ICC