


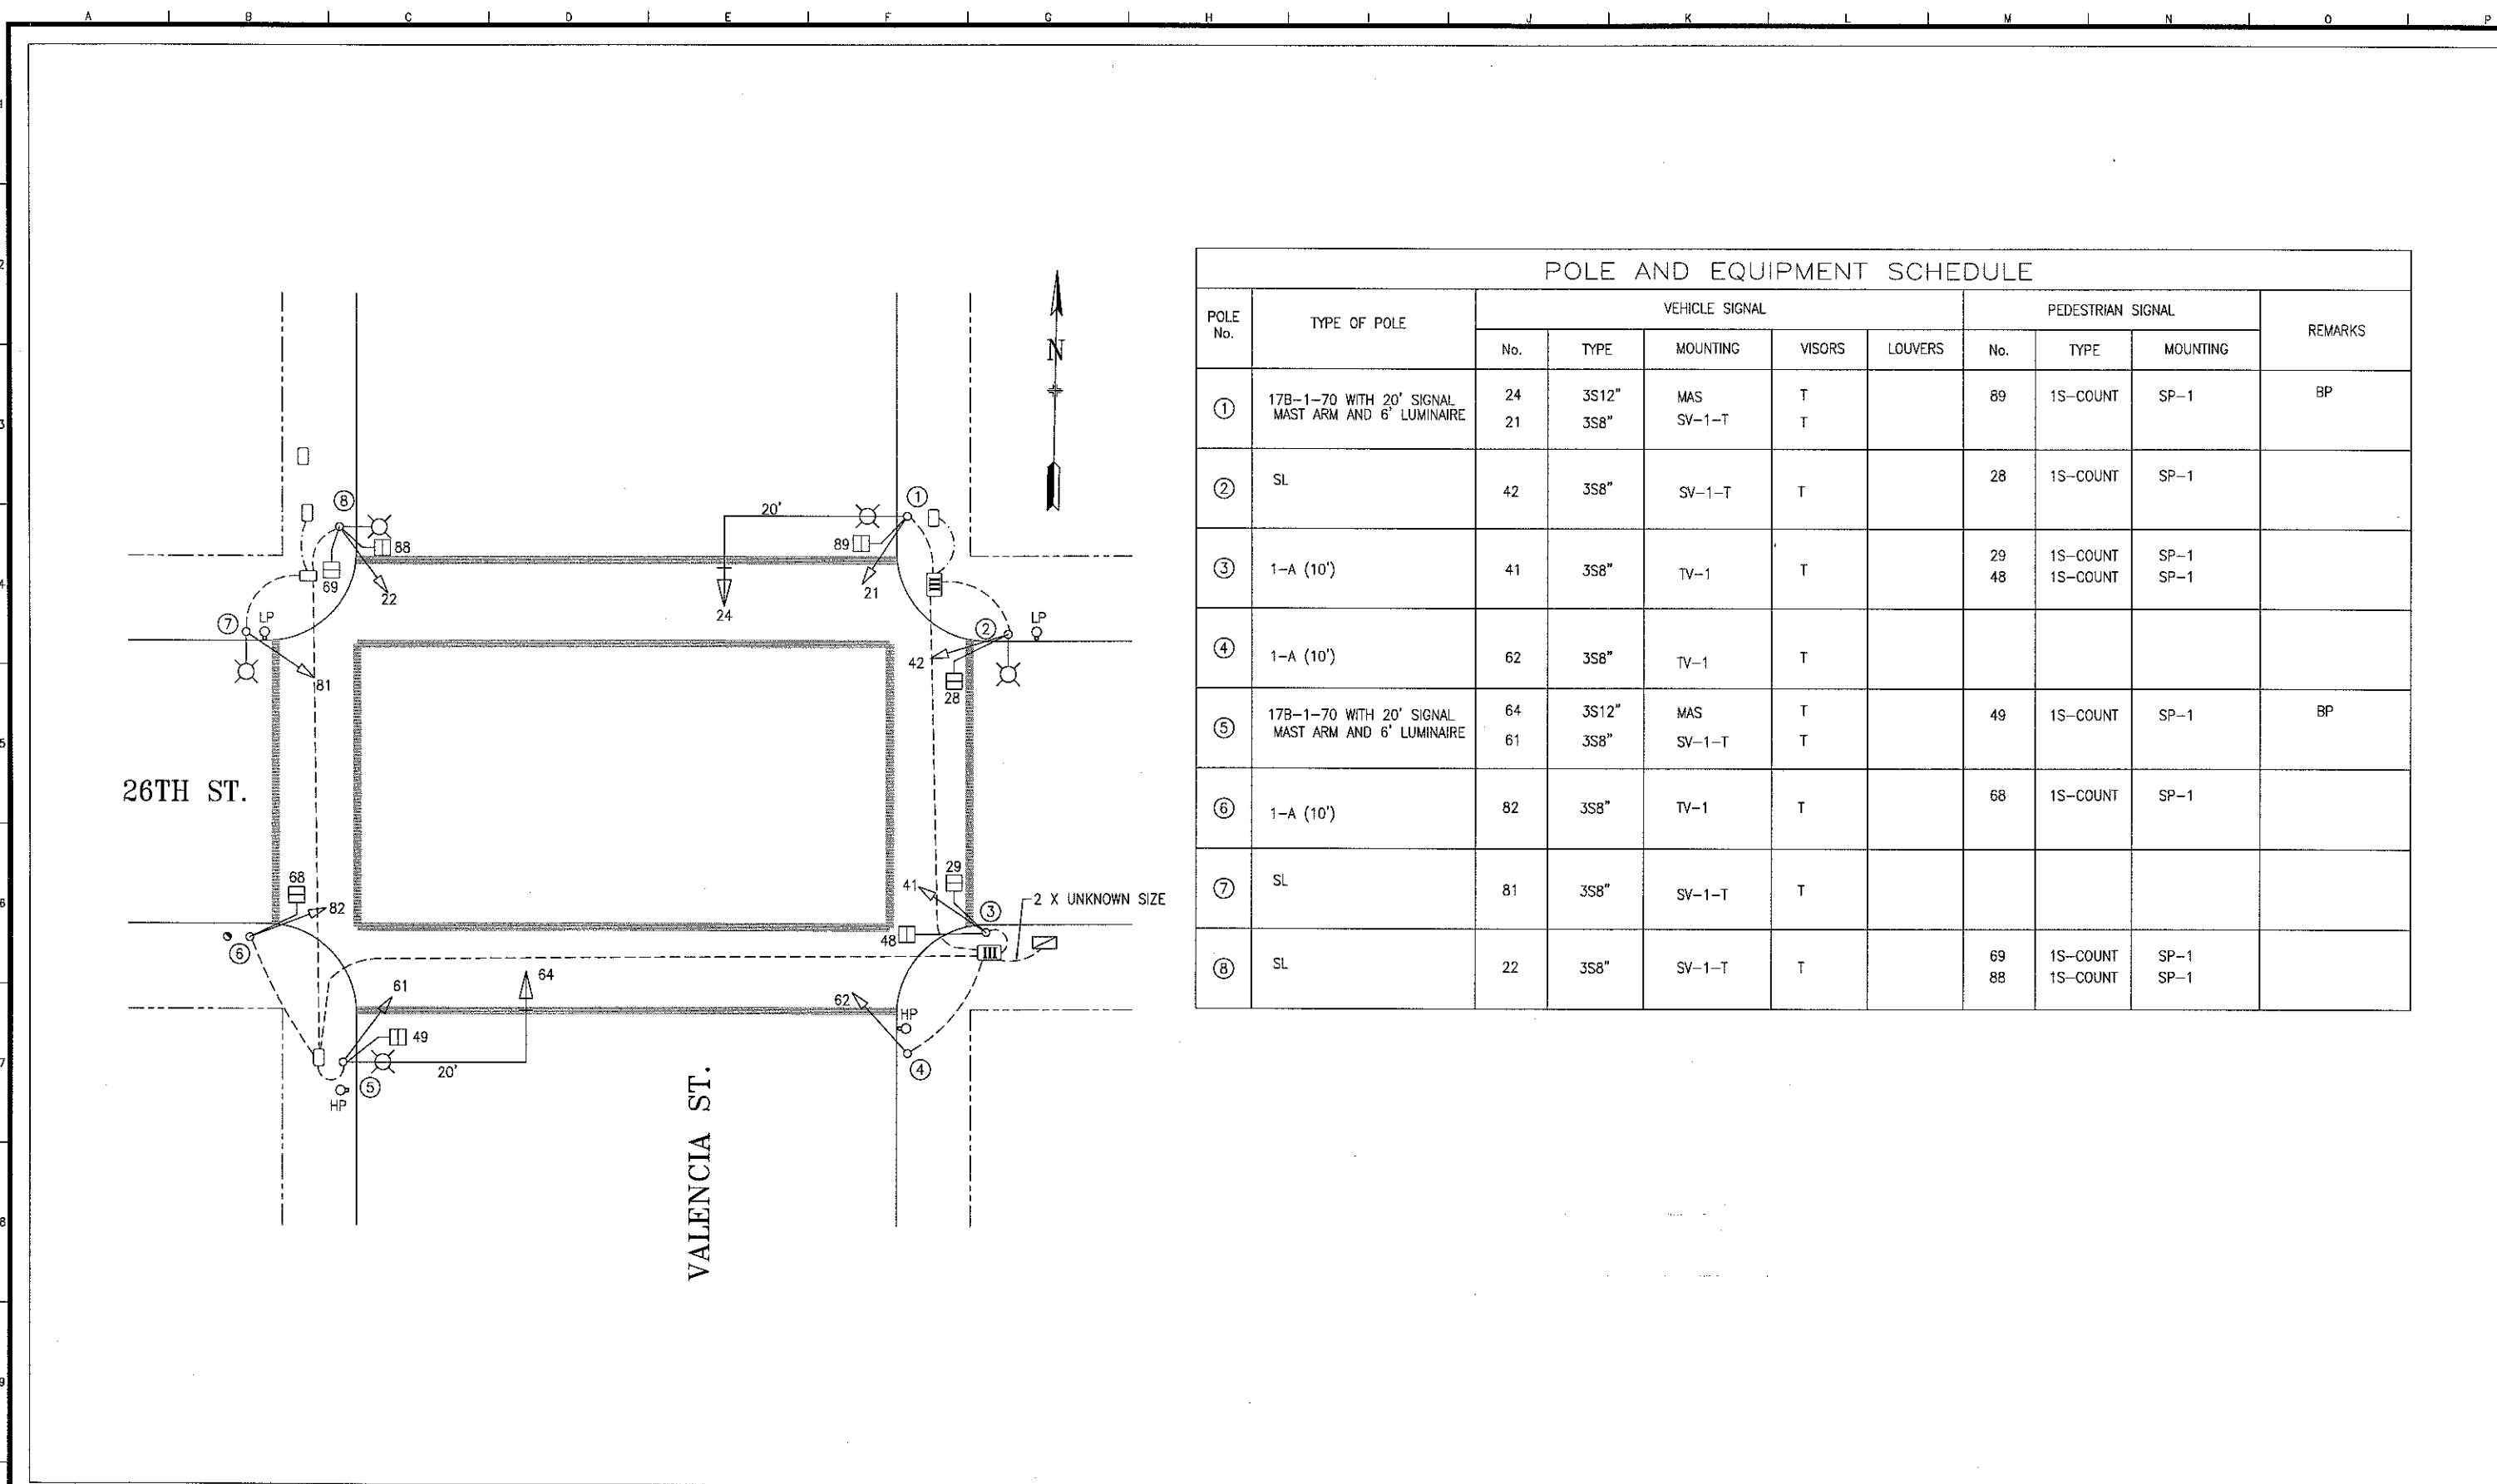

POLE AND EQUIPMENT SCHEDULE										
POLE No.	TYPE OF POLE	VEHICLE SIGNAL					PEDESTRIAN SIGNAL			REMARKS
		No.	TYPE	MOUNTING	VISORS	LOUVERS	No.	TYPE	MOUNTING	
①	17B-1-70 WITH 20' SIGNAL MAST ARM AND 6" LUMINAIRE	24	3S12"	MAS	T		89	1S-COUNT	SP-1	BP
		21	3S8"	SV-1-T	T					
②	SL	42	3S8"	SV-1-T	T		28	1S-COUNT	SP-1	
③	1-A (10')	41	3S8"	TV-1	T		29	1S-COUNT	SP-1	
							48	1S-COUNT	SP-1	
④	1-A (10')	62	3S8"	TV-1	T					
⑤	17B-1-70 WITH 20' SIGNAL MAST ARM AND 6" LUMINAIRE	64	3S12"	MAS	T		49	1S-COUNT	SP-1	BP
		61	3S8"	SV-1-T	T					
⑥	1-A (10')	82	3S8"	TV-1	T		68	1S-COUNT	SP-1	
⑦	SL	81	3S8"	SV-1-T	T					
⑧	SL	22	3S8"	SV-1-T	T		69	1S-COUNT	SP-1	
							88	1S-COUNT	SP-1	

1 07/05 ADD ADDITIONAL PED SIGNALS BY SIGNAL SHOP.		CXL JK	COMPLETION DATE / ELECTRICIAN INITIAL		DEPARTMENT OF PARKING AND TRAFFIC DIVISION OF TRAFFIC ENGINEERING CITY AND COUNTY OF SAN FRANCISCO	DRAWN: DATE: SCALE: CXL 4/03 1" = 20'	TRAFFIC SIGNAL INVENTORY DIAGRAM	CNN NO. 21346000
TABLE OF REVISIONS CHECK WITH TRACING TO SEE IF YOU HAVE LATEST REVISION		BY APP.				CHECKED: DATE: SHEET OF SHEETS JK 5/06 1 OF 1		26TH ST AND VALENCIA ST

Drawing Path: T:\T.E.FILES\Official_Records\Signal_Inventory\Current\#26ST_Valencia.dwg, Login: CLEUNG2
Plot Time: Thu, 13 Apr 2006 2:33pm
Signal Inventory Diagram Title Block [T:\T.E.FILES\Special Projects & Street Use\Signal Inventory Diagram Title Block.dwg]
Model Units: Feet
Measurement Units are English
Dimension Scale: 10
Scale: 1" = 20'