


27th & GEARY

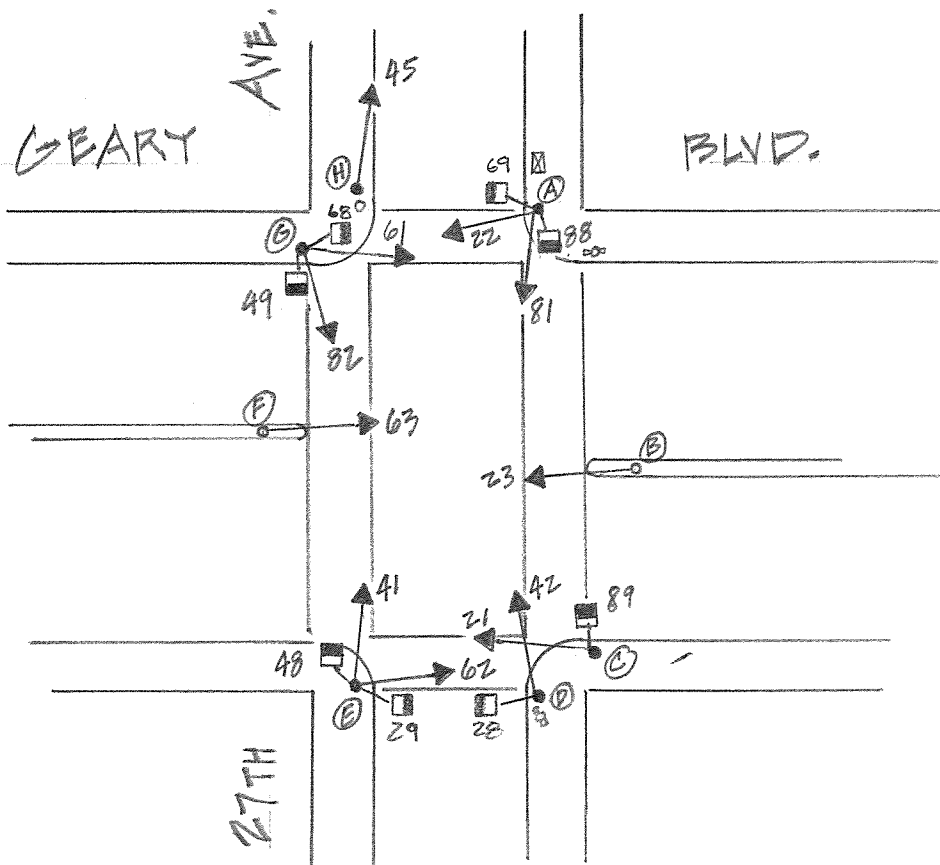

9/8/22

POLE	FUNC.	MAT'L	SIGNAL NO.	MAKE	NO. OF SECT.	SIZE	VISOR	B.P. OR LOUVERS	MOUN'T	PED SIGNAL NO.	LEGEND	MESSAGE		MAKE	MOUN'
												ELEMENT	COLOR		
A	S	S	22	EC	3	8"		NO	T	88	COUNT	LED	OR/WH		S
B	L	C	81	EC	3	8"		NO	T	89					S
C	S	S	23		3	8"		NO	S	48					S
D	S	S	21	EC	3	8"		NO	T	49					S
E	S	S	42	EC	3	8"		NO	T	69					S
F	L	C	62	EC	3	8"		NO	T	28					S
G	S	S	41	EC	3	8"		NO	T	29					S
H	S	S	63		3	8"		NO	S	68					S
			82	EC	3	8"		NO	T						
			61	EC	3	8"		NO	T						
			45	EC	3	8"		NO	T						

CONTROLLER CABINET SIZE : LARGE BASE CABINET : NO

COMMENTS : REMOVE LOUVERS FROM SIGNAL 82 PER SRC 2022-225

-J. HORNBOSTEL