


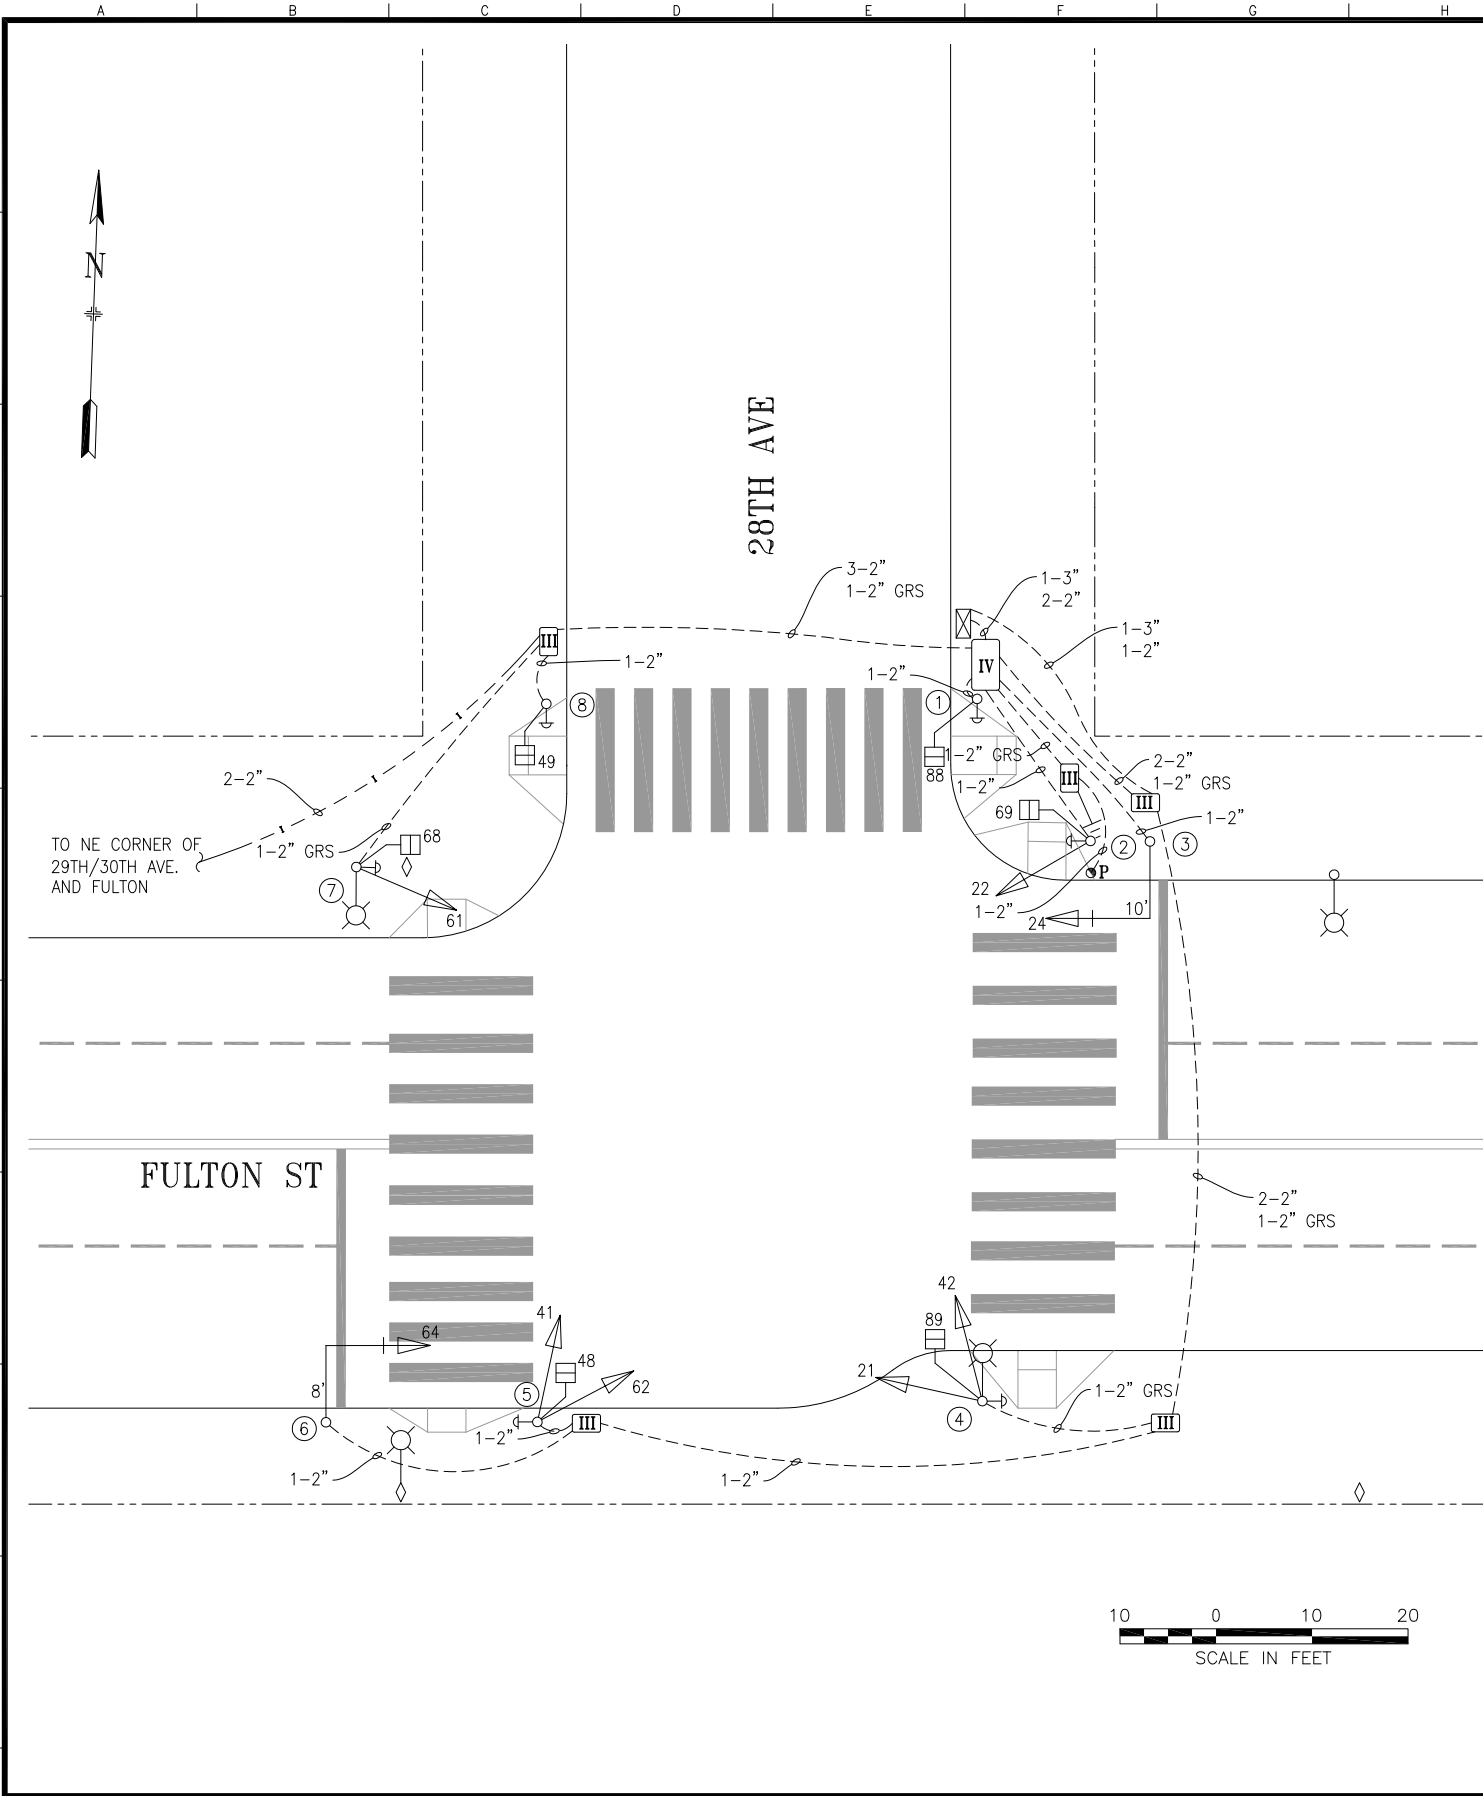

POLE AND EQUIPMENT SCHEDULE										
POLE No.	TYPE OF POLE	LUMINAIRE VOLTAGE/WATTAGE	VEHICLE SIGNAL				PEDESTRIAN SIGNAL			REMARKS
			No.	TYPE	MOUNTING	VISORS	No.	TYPE	MOUNTING	
①	1-A (7')						88	1S-COUNT	TP-1	APS-2W
②	1-A (10')		22	3S12"	TV-1-T	T	69	1S-COUNT	SP-1	APS-2W
③	16-2-100 WITH 10' MAST ARM		24	3S12"	MAS ①	T				BACKPLATE
④	CITY STANDARD STREETLIGHT WITH 6' LUMINAIRE ARM	LED 120/54W	21 42	3S12" 3S12"	SV-2-TC	T T	89	1S-COUNT	SP-1	APS-2W
⑤	1-A (10')		41 62	3S12" 3S12"	TV-2-T-SFA	T T	48	1S-COUNT	SP-1	APS-2W
⑥	16-2-100 WITH 8' MAST ARM		64	3S12"	MAS ①	T				BACKPLATE
⑦	CITY STANDARD STREETLIGHT WITH 6' LUMINAIRE ARM	LED 120/54W	61	3S12"	SV-1-T	T	68	1S-COUNT	SP-1 (22")	MOUNT SIGNAL 61 ON CURB SIDE OF POLE APS-2W
⑧	1-A (7')						49	1S-COUNT	TP-1	APS-2W

SHEET NOTES:

① PLUMBIZER MOUNTED BETWEEN GREEN AND YELLOW

INTERCONNECT WIRING DETAIL

NOT TO SCALE

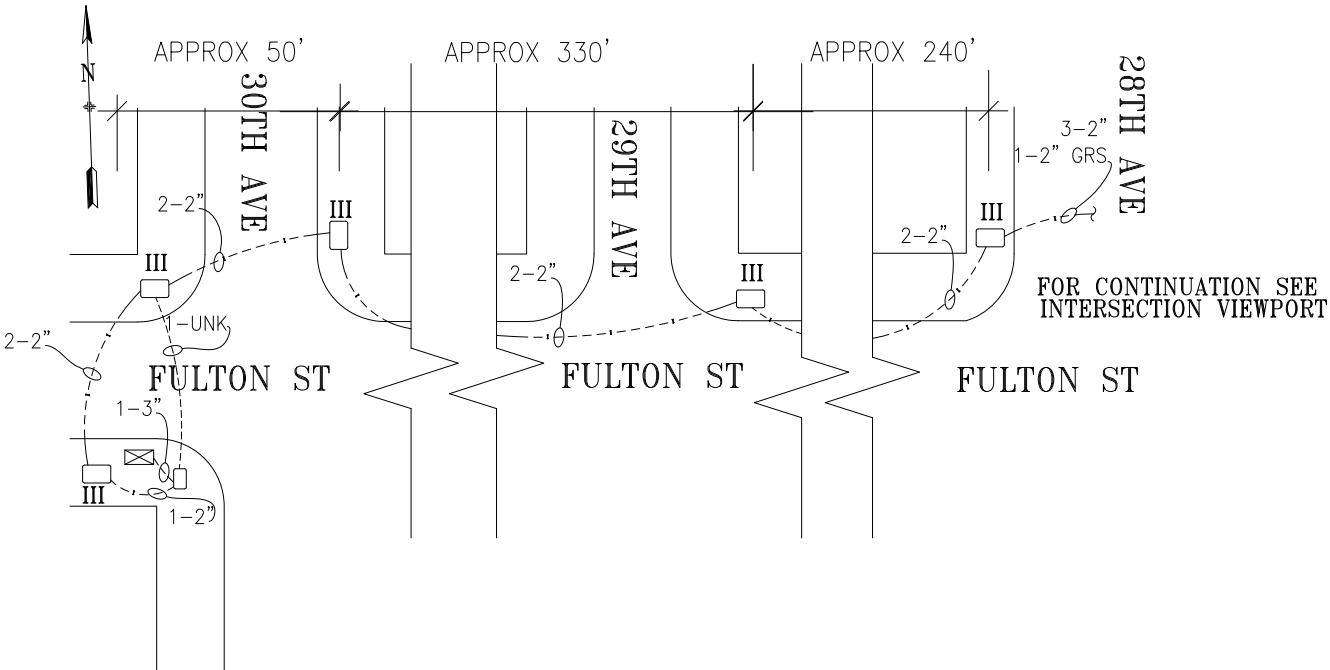


TABLE OF REVISIONS		CHECK WITH TRACING TO SEE IF YOU HAVE LATEST REVISION	
NO.	DATE	DESCRIPTION	BY APP.
0	11/30/17	NEW SIGNAL ACTIVATED THROUGH #2772J	AScalesG0DeLeon

REFERENCE INFORMATION
& FILE NO. OF SURVEYS



SAN FRANCISCO MUNICIPAL TRANSPORTATION AGENCY
CITY AND COUNTY OF SAN FRANCISCO

DRAWN:	DATE:
AS	7/5/18
CHECKED:	DATE:
GD	8/3/18

SCALE:

AS SHOWN

SHEET OF SHEETS

1 OF 1

TRAFFIC SIGNAL INVENTORY DIAGRAM

28TH AVENUE AND FULTON STREET

CNN NO.

27527000

REV NO.

0