


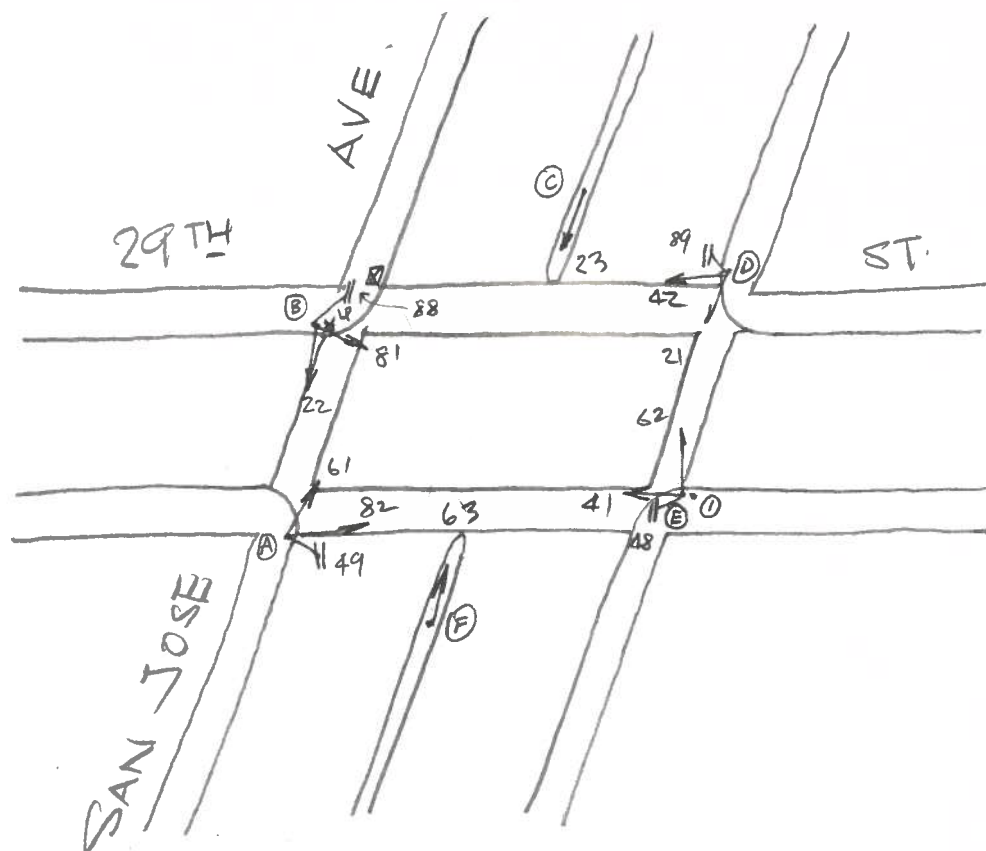

10-26-2018

[illegible]

CONTROLLER CABINET SIZE : ORDINARY BASE CABINET: NO

COMMENTS :

upgrade signal NO 82, 61, 42, 21 and 63 from 8" to 12".

SRC 2017-403 - (KML)