


GEARY Blvd.

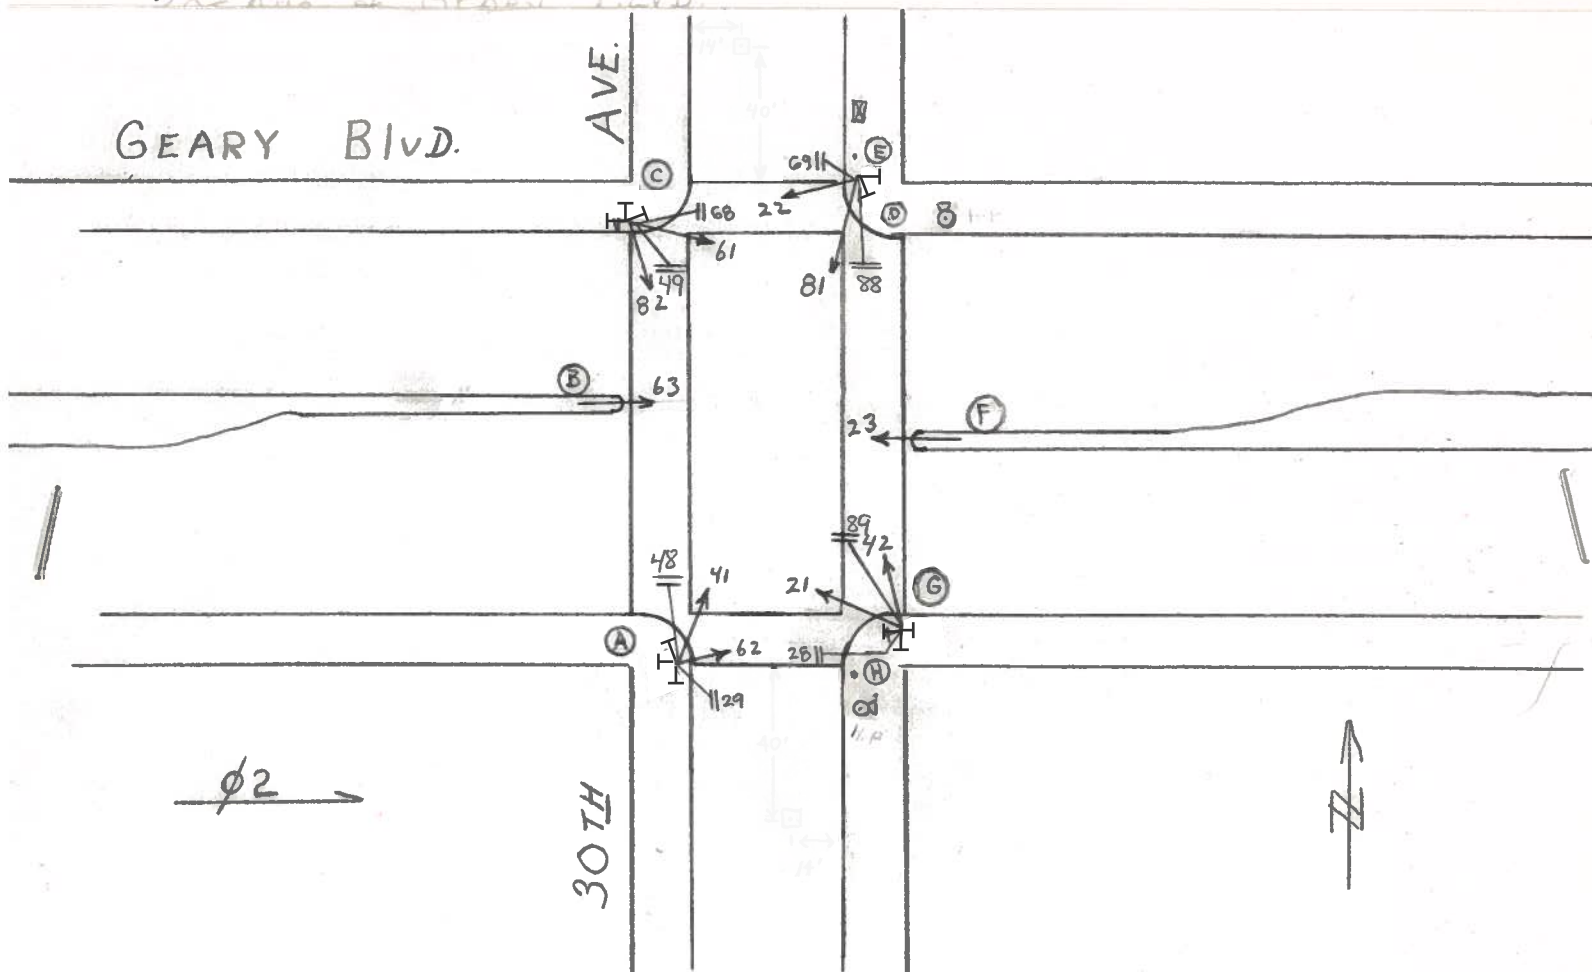

** Pole F: TSP Preempt & Network Radio

5/5/2022

[illegible]

CONTROLLER CABINET SIZE : ORDINARY BASE CABINET: YES

COMMENTS : Install APS
(SRC 2021-055) E. Luu