



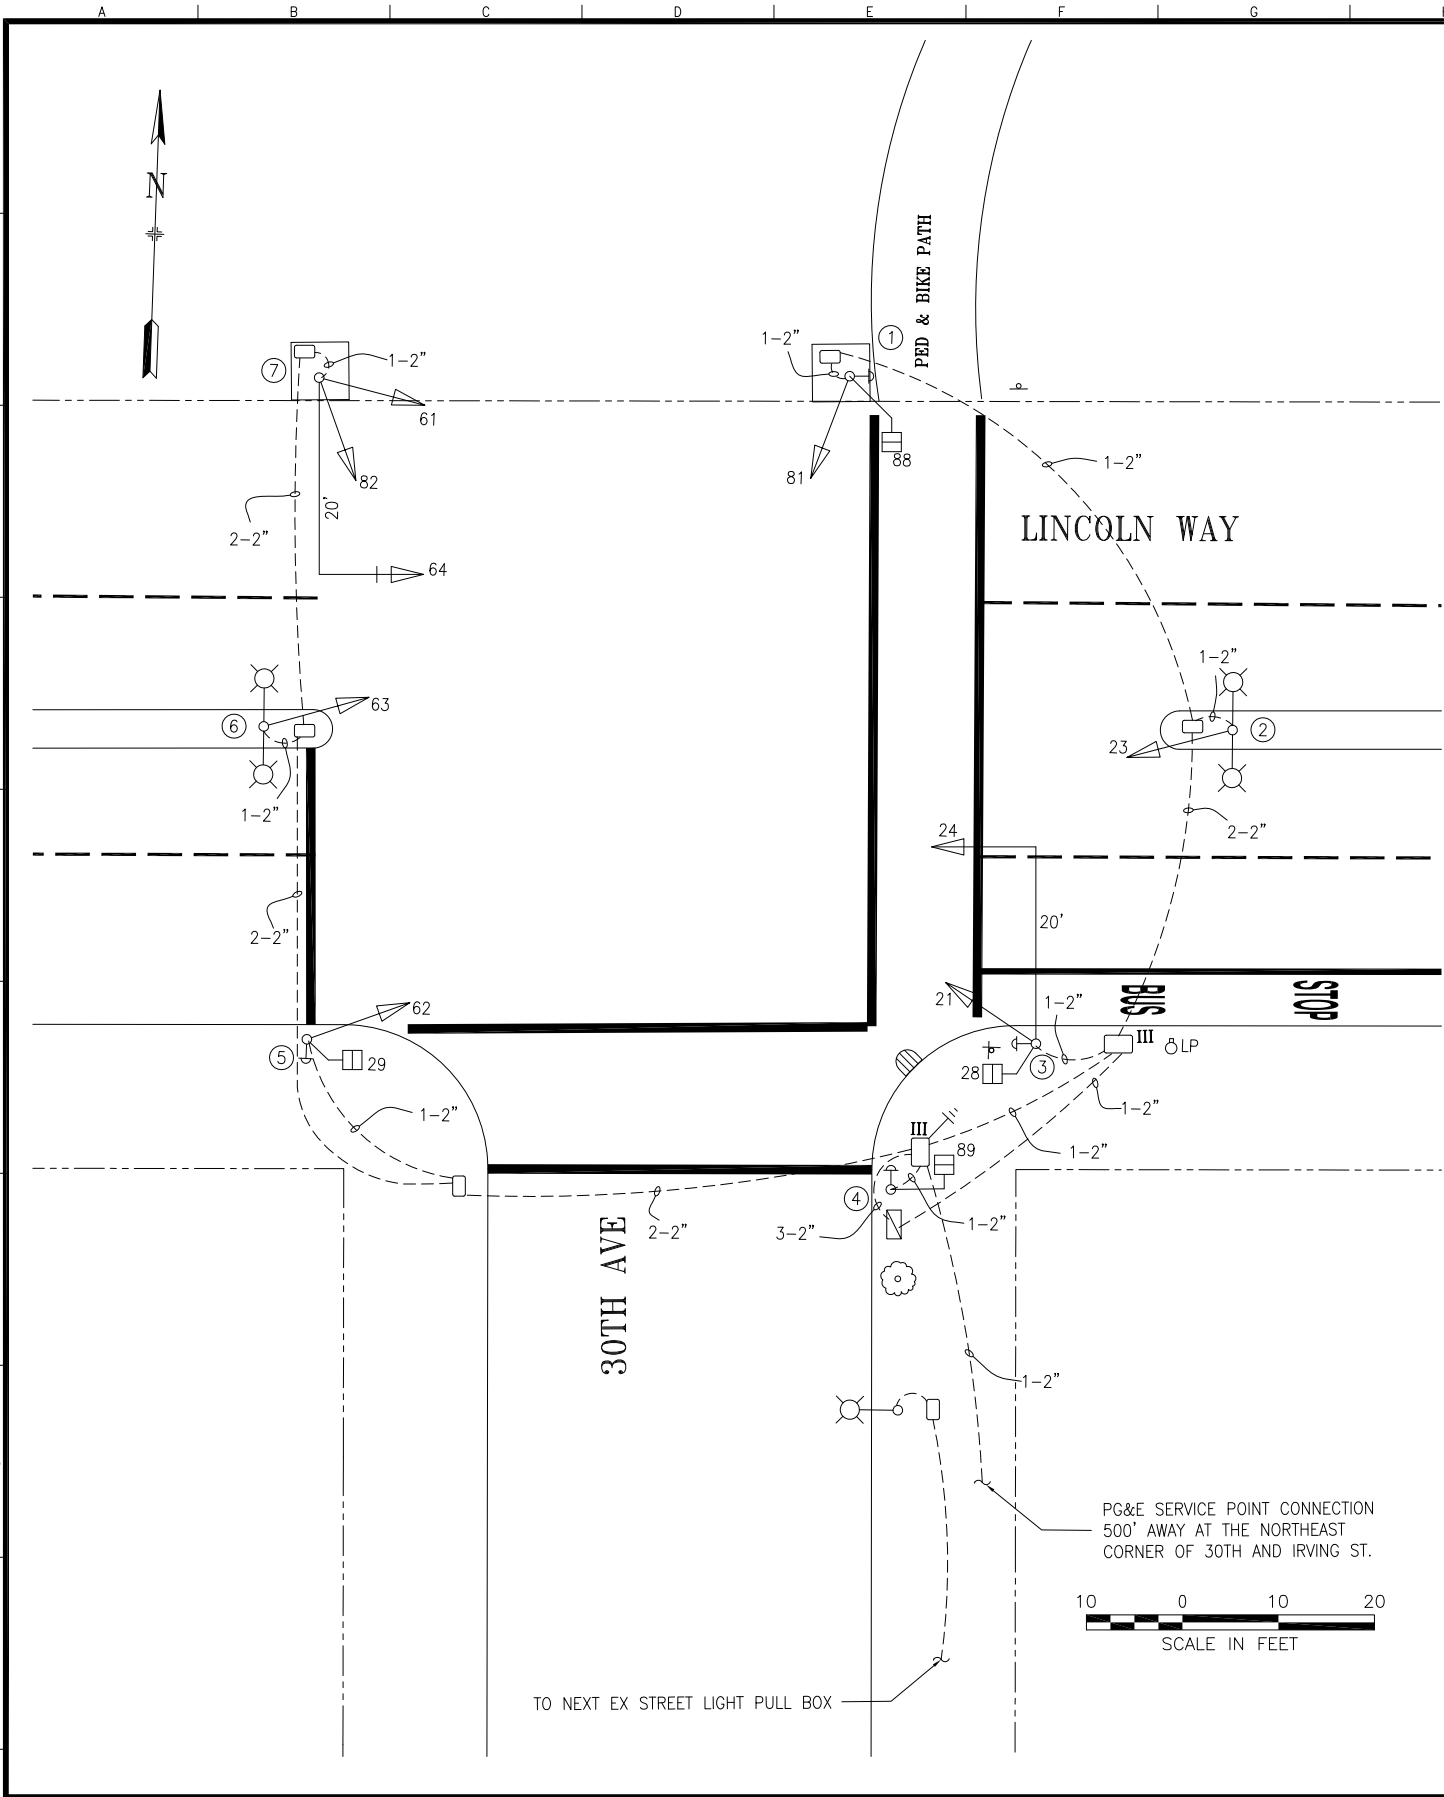

POLE AND EQUIPMENT SCHEDULE											
POLE No.	TYPE OF POLE	LUMINAIRE VOLTAGE/ WATTAGE	VEHICLE SIGNAL					PEDESTRIAN SIGNAL			REMARKS
			No.	TYPE	MOUNTING	VISORS	LOUVERS	No.	TYPE	MOUNTING	
①	CITY STANDARD STREET LIGHT	120-240 V/ 150 W	81	3S8"	SV-1	T		88	1S-COUNT	SP-1	F/I PPB F/I CAMERA
②	EX SL		23	3S8"	SV-1	T					
③	1-A (10')		21	3S8"	TV-1	T		28	1S-COUNT	SP-1	F/I PPB
④	1-A (7')							89	1S-COUNT	TP-1	F/I PPB
⑤	1-A (10')		62	3S8"	TV-1	T		29	1S-COUNT	SP-1	F/I PPB
⑥	EX SL		63	3S8"	SV-1	T					
⑥	16-1-100 WITH 20' MAST ARM		64 82	3S12" 3S8"	MAS SV-1-T	T T					F/I BACKPLATE

PHASE DIAGRAM

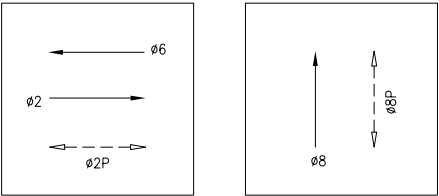

PHASE SEQUENCE

G	Y	R		LINCOLN WAY (EB & WB) - ø2 & ø6
R		G	Y R	30TH AVE (NB) - ø8
WM	FRH	RH		PED XING 30TH AVE (SS) - ø2P
RH		WM	FRH RH	PED XING LINCOLN WAY (ES) - ø8P

0	06/5/09	ACTIVATED NEW SIGNALS THROUGH CT 59 (1499J); CONVERTED FROM AS-BUILTS.	SS	GD	
NO.	DATE	DESCRIPTION	BY	APP.	

TABLE OF REVISIONS
CHECK WITH TRACING TO SEE IF YOU HAVE LATEST REVISION

REFERENCE INFORMATION
& FILE NO. OF SURVEYS



SAN FRANCISCO MUNICIPAL TRANSPORTATION AGENCY
CITY AND COUNTY OF SAN FRANCISCO

		SCALE: AS SHOWN	TRAFFIC SIGNAL INVENTORY DIAGRAM	CNN NO. 27813000
DRAWN: SS	DATE: 09/14		SHEET OF SHEETS 1 OF 1	REV NO. 0
CHECKED: GD	DATE: 09/14		30TH AVE AND LINCOLN WAY	