
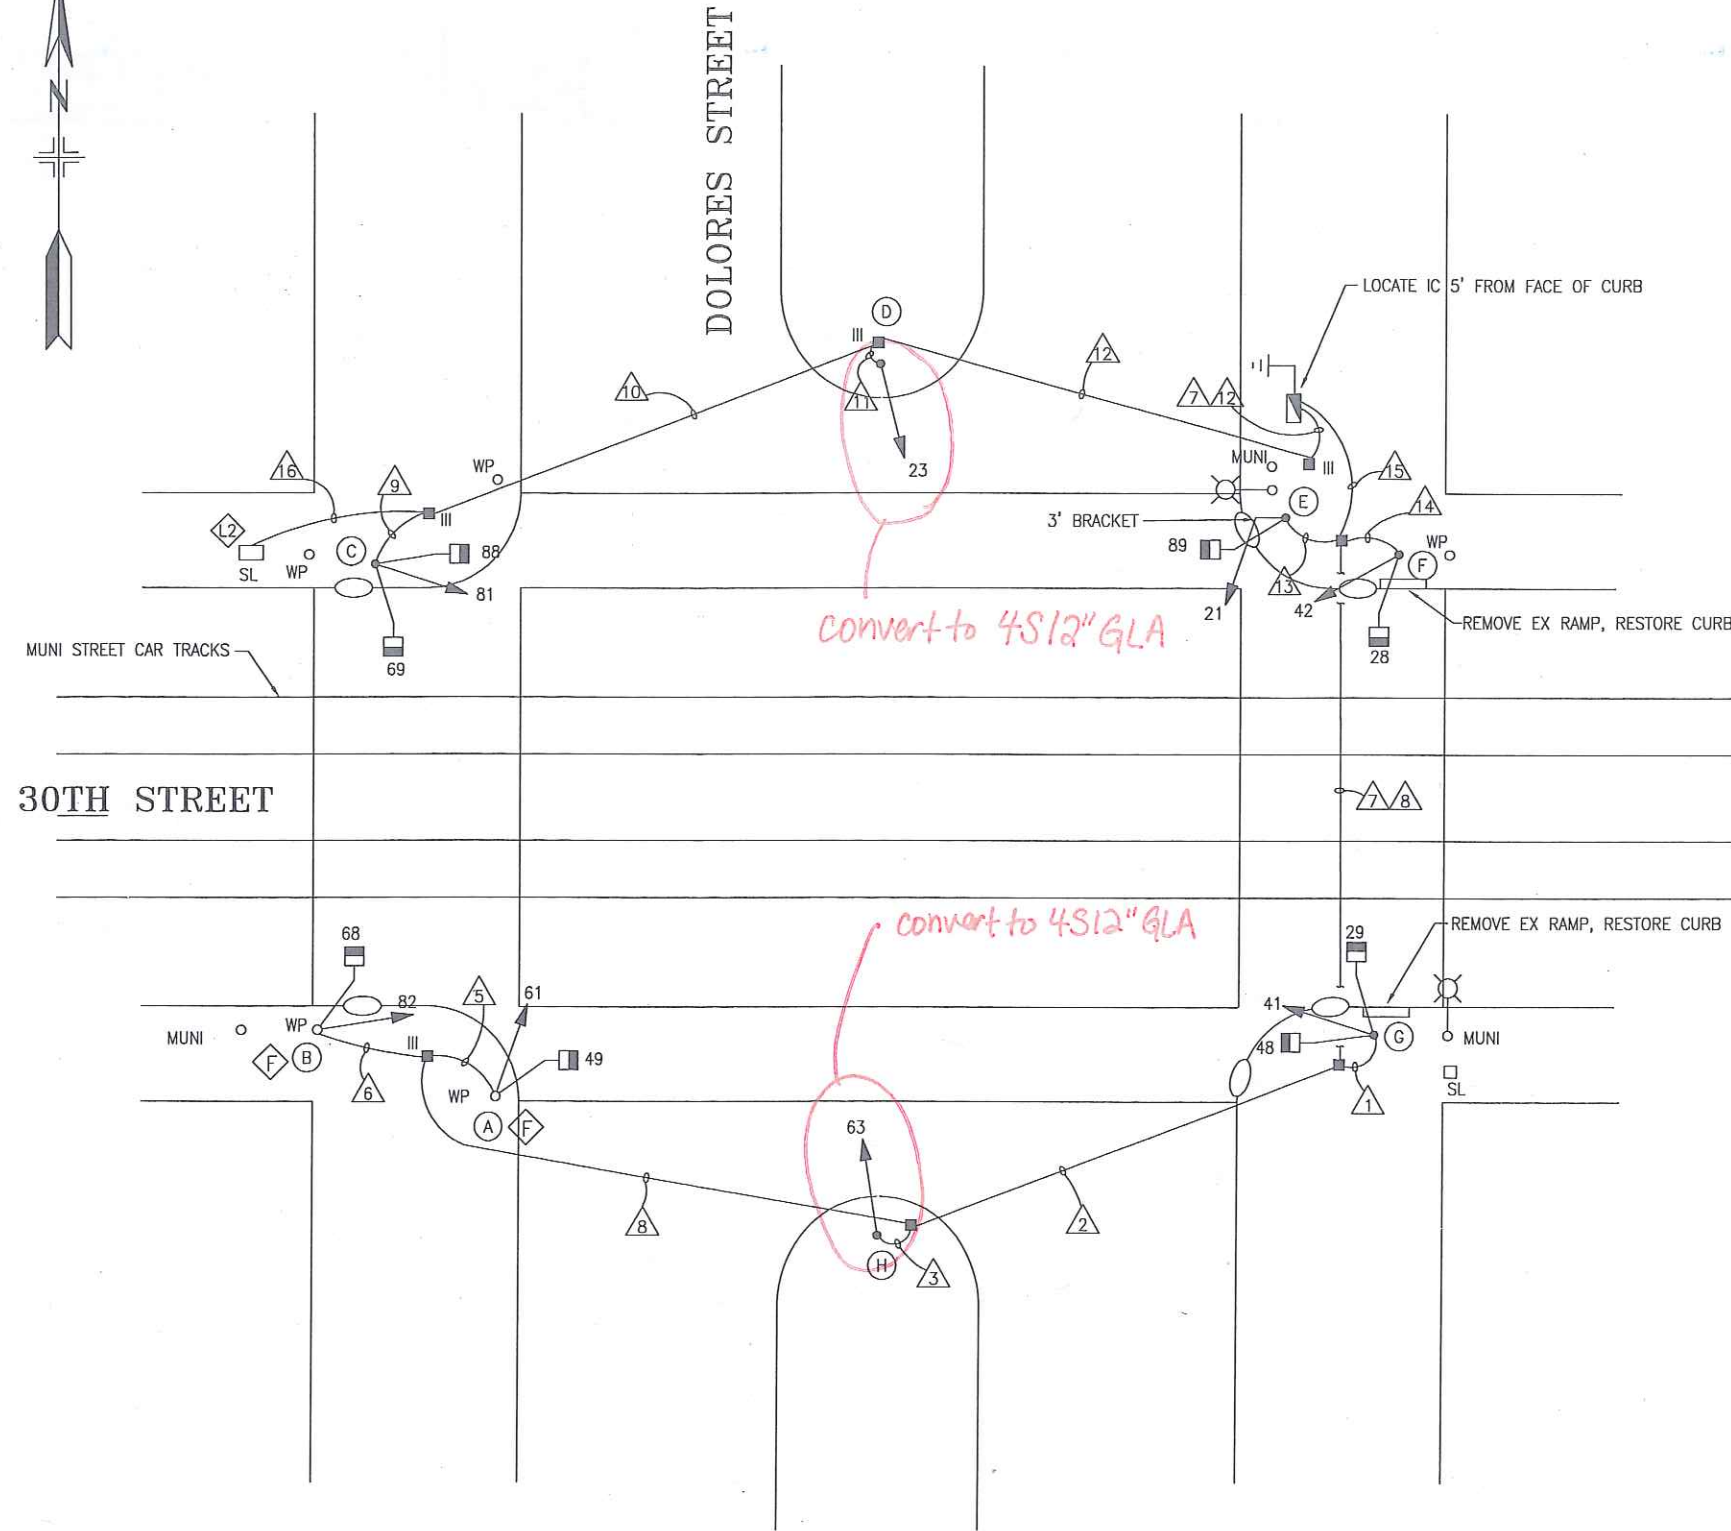


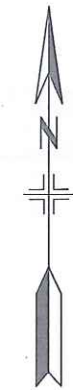


PHASE SEQUENCE

G	Y	R
R		G
WM	FRH	RH
RH	WM	FRH

DOLORES STREET
30TH STREET
PED XING 30TH
PED XING DOLORES

PHASE DIAGRAM

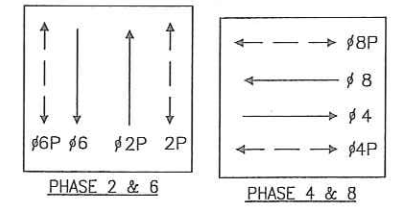

Completed 1/28/2013
changed by DL/CW for SRC 2011-155

DETAIL NOTES:

- (F) SIGNALS SHALL USE NEW EXTERNAL CONDUIT. (1/E-14)
- (12) F/I IN-LINE FUSE HOLDERS W/ 40A FUSE FOR IC SERVICE. SPLICE TO LINE SIDE OF CITY SERVICE. BOND TO GROUND ROD. F/I GROUND ROD IF NEEDED.

AS BUILT DRAWING
APPROVAL SIGNATURES ON ORIGINAL CONTRACT DRAWINGS.

DRAWING INFORMATION:
FILE NAME: E-5
ORIGIN: ELECTRICAL
DATE: 4/98
LIMITS: (0,0), (340',220')
PLOT SCALE: 1"=10'

	7/31/00	AS-BUILT	JM	SL
NO.	DATE	DESCRIPTION	BY	APP.
TABLE OF REVISIONS				
CHECK WITH TRACING TO SEE IF YOU HAVE LATEST REVISION				

REFERENCE
INFORMATION & FILE
No. OF SURVEYS



BUREAU OF ENGINEERING
DEPARTMENT OF PUBLIC WORKS
CITY AND COUNTY OF SAN FRANCISCO

DESIGNED:	DATE:	APPROVED
CF	4/98	
DRAWN:	DATE:	SECTION MANAGER
JS	2/98	
CHECKED:	DATE:	DIVISION MANAGER
CF	4/98	
		CITY ENGINEER

SCALE:
1"=10'-0"
SHEET OF SHEETS
6 OF 17

TRAFFIC SIGNAL INSTALLATION
CONTRACT 51
30TH AND DOLORES STREETS

SPECIFICATION NO.
1664N
DRAWING NO.
E-5
FILE NO.
70,160
REV. NO.
1P

T:\E-FILES\Official_Records\Signal_Inventory\Bulldog\GCT51\1664N\E-05.dwg - Model: 10/2/2007 4:46:35 PM
CLEUNG

