


POLE AND EQUIPMENT SCHEDULE											CONTRACT WORK IN BOLD
POLE No.	TYPE OF POLE	LUMINAIRE VOLTAGE/ WATTAGE	VEHICLE SIGNAL					PEDESTRIAN SIGNAL			REMARKS
			No.	TYPE	MOUNTING	VISORS	LOUVERS	No.	TYPE	MOUNTING	
①	16-1-70 w/ 8' MAST ARM		64		MAS	T					BACKPLATE
②	1-A (10')		61	3S8"	TV-1	T		68	1S-COUNT	SP-1	
③	EX. MUNI w/ STREETLIGHT			3S8"	SV-1-T	T		88	1S-COUNT	SP-1	
④	1-A (10')		22	3S8"	TV-1	T		88 69	1S-COUNT 1S-COUNT	SP-1 SP-1	
⑤	16-1-70 w/ 8' MAST ARM		21 42 24	3S8" 3S12" 3S12"	SV-2-TA MAS	T T T		89	1S-COUNT	SP-1 (16")	BACKPLATE
⑥	CITY STANDARD STREETLIGHT w/ 6' LUMINAIRE	240V 200 WATTS	25 41	3S8" 3S8"	SV-2-TA			28	1S-COUNT	SP-1	
⑦	EX. MUNI		62	3S12"	SV-1-T			29 48	1S-COUNT 1S-COUNT	SP-1 SP-1	
⑧	CITY STANDARD STREETLIGHT										

PHASE DIAGRAM

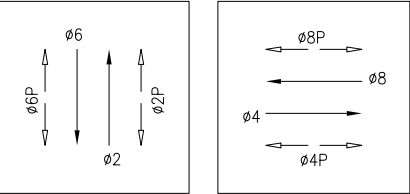

DETAIL NOTES:

① REUSE EX. POLE TOP ADAPTER UPON WHICH STANDARD POLE TOP SIGNAL FITTING WILL BE USED.

SHEET NOTES:

1. CONTRACTOR SHOULD AVOID DAMAGE THE CURB RAMPS.

PHASE SEQUENCE  
(STEADY DEMAND)

G	Y	R		NB MISSION ST - 02
R		G	Y R	30TH ST (EB & WB) - 04 & 08
WM	FRH	RH		PED XING 30TH ST (ES & WS) - 02P & 06P
RH		WM	FRH RH	PED XING MISSION ST (SS & NS) - 04P & 08P

TABLE OF REVISIONS			
NO.	DATE	DESCRIPTION	BY APP.
0	2-14-13	PED SIGNALS AND CROSSWALK INSTALLED	MV HQ
CHECK WITH TRACING TO SEE IF YOU HAVE LATEST REVISION			

REFERENCE INFORMATION  
& FILE NO. OF SURVEYS



SAN FRANCISCO MUNICIPAL TRANSPORTATION AGENCY  
CITY AND COUNTY OF SAN FRANCISCO

DRAWN: DATE:  
GD 02/14  
CHECKED: DATE:  
MV 02/14

SCALE:

AS SHOWN

SHEET OF SHEETS

1 OF 1

TRAFFIC SIGNAL INVENTORY DIAGRAM

30TH ST AND MISSION ST  
TRAFFIC SIGNAL WORK

CNN NO.

21329000

REV NO.