


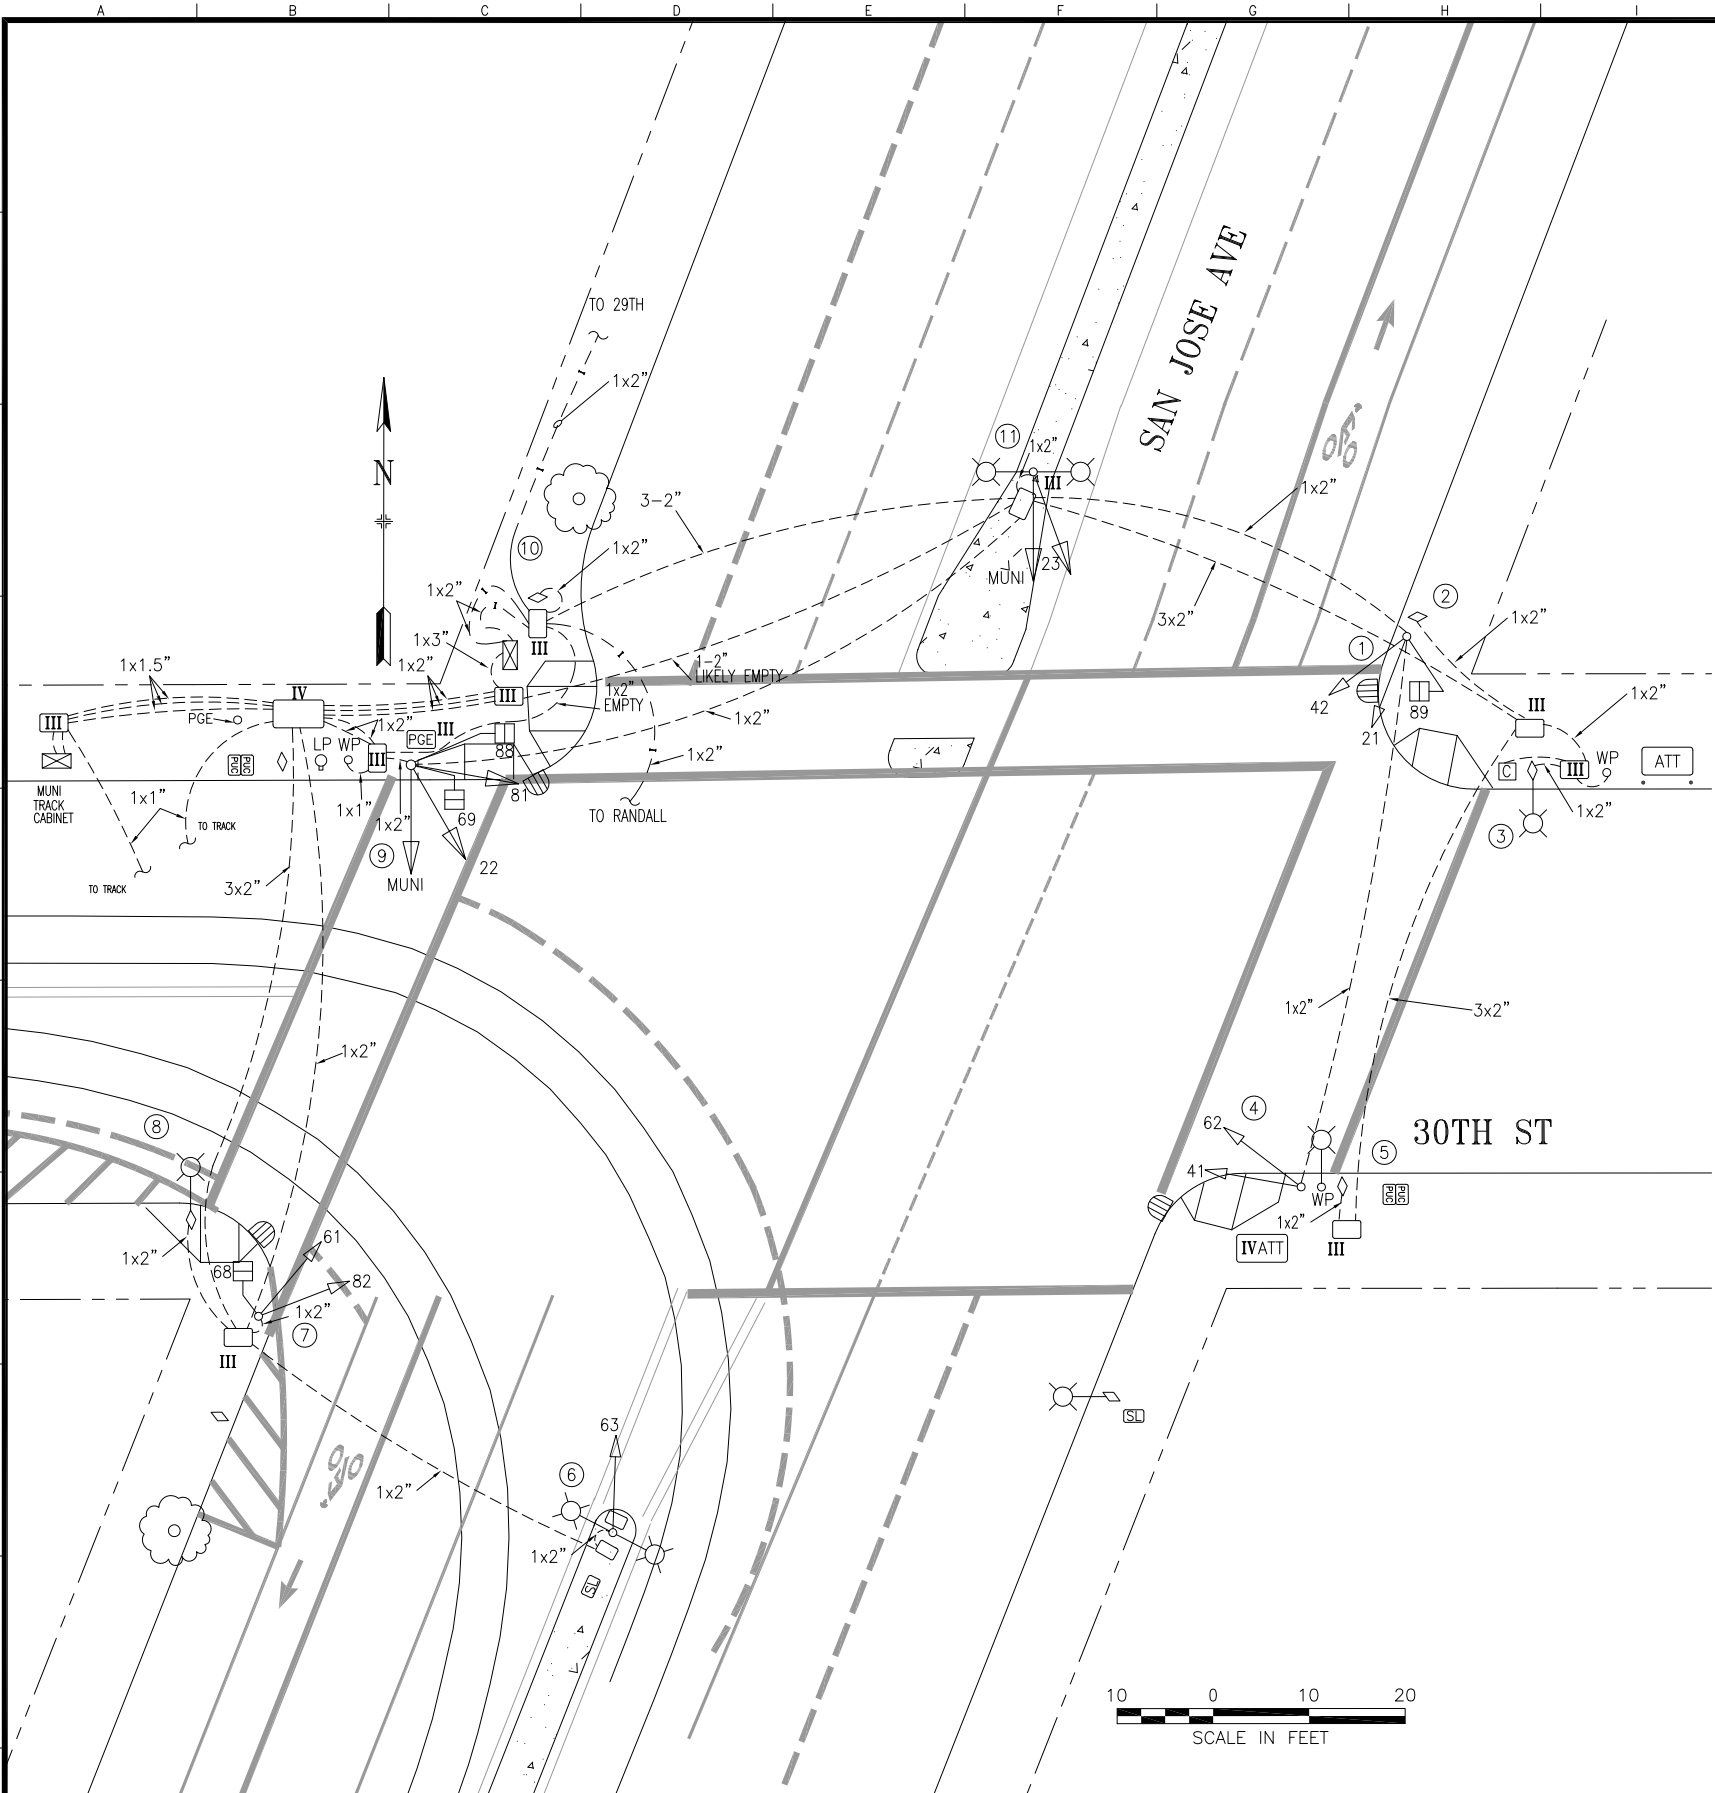

POLE AND EQUIPMENT SCHEDULE											
POLE No.	TYPE OF POLE	LUMINAIRE VOLTAGE/ WATTAGE	VEHICLE SIGNAL					PEDESTRIAN SIGNAL			REMARKS
			No.	TYPE	MOUNTING	VISORS	LOUVERS	No.	TYPE	MOUNTING	
①	TAPER TUBE (10')		21 42	3S8" 3S8"	TV-2-TA	T T		89	1S-COUNT	SP-1	
②	MUNI POLE										EXTERNAL CONDUIT
③	MUNI POLE W/ 6' LA										
④	TAPER TUBE (10')		41 62	3S8" 3S8"	TV-2-TA	T T					
⑤	MUNI POLE										LB CONDULET AT POLE BASE
⑥	MUNI POLE W/ DUAL LA		63	3S8"	SV-1	T					
⑦	TAPER TUBE (10')		61 82	3S8" 3S8"	TV-2-TA	T T		68	1S-COUNT	SP-1	
⑧	MUNI POLE W/ 6' LA										LB CONDULET AT POLE BASE
⑨	TAPER TUBE (10')		22 81 MUNI	3S12" 3S12" 2S12"LB	TV-3-T	T T T		69 88	1S-COUNT 1S-COUNT	SP-1 SP-1	
⑩	MUNI POLE										EXTERNAL CONDUIT
⑪	SL W/ DUAL LA		23 MUNI	3S12" 2S12"LB	SV-2-TA	T T					

0	4/29/16	UPDATED PER FIELD CHECK		DYeung	Melasco
NO.	DATE	DESCRIPTION	BY	APP.	
TABLE OF REVISIONS					
CHECK WITH TRACING TO SEE IF YOU HAVE LATEST REVISION					

REFERENCE INFORMATION & FILE NO. OF SURVEYS



SAN FRANCISCO MUNICIPAL TRANSPORTATION AGENCY

CITY AND COUNTY OF SAN FRANCISCO

DRAWN:	DATE:
DYeung	4/2016
CHECKED:	DATE:
MVelasco	4/2016

SCALE:
AS SHOWN
SHEET OF SHEETS
1 OF 1

TRAFFIC SIGNAL INVENTORY DIAGRAM
30TH STREET AND SAN JOSE AVENUE

CNN NO.
21890000
REV NO.
0