


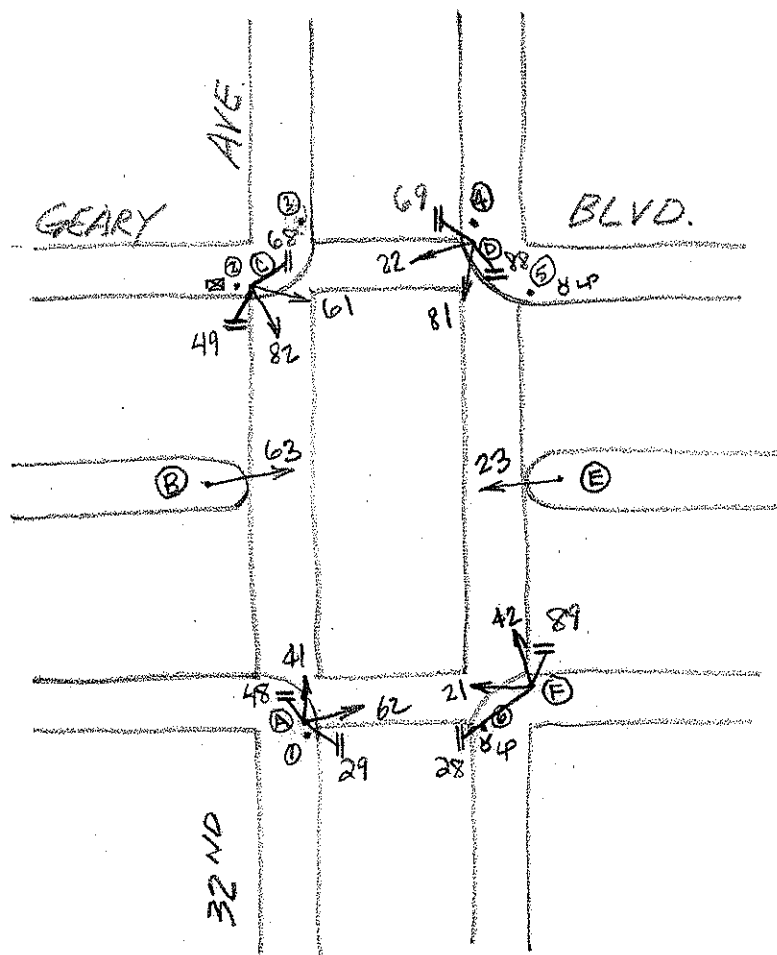

7-06-04

POLE	FUNC.	MAT'L	SIGNAL NO.	MAKE	NO. OF SECT.	SIZE	VISOR	B.P. OR LOUVERS	MOUN'T	PED SIGNAL NO.	LEGEND	MESSAGE		MAKE	MOUN'T
												ELEMENT	COLOR		
A	S	C	41	EA	3	8"	FC 8"	NO	T	28	COUNT	LED	WH/OR	Dialight	S
B	L	C	62	EA	3	8"	FC 8"	NO	T	29	COUNT	LED	WH/OR	Dialight	S
C	S	C	63	ED	3	12" R 8" G+Y	FC 12" FC 8"	NO	S	48	COUNT	LED	WH/OR	Dialight	S
D	S	C	82	EA	3	8"	FC 8"	NO	T	49	COUNT	LED	WH/OR	Dialight	S
E	L	C	61	EA	3	12" R 8" G+Y	FC 12" FC 8"	NO	T	68	COUNT	LED	WH/OR	Dialight	S
F	S	C	22	EO	3	8"	FC 8"	NO	T	69	COUNT	LED	WH/OR	Dialight	S
			81	EO	3	8"	FC 8"	NO	T	88	COUNT	LED	WH/OR	Dialight	S
1	M	S	23	EC	3	8"	FC 8"	NO	S	89	COUNT	LED	WH/OR	Dialight	S
2	M	S	42	EO	3	8"	FC 8"	NO	T						
3	M	S	21	EO	3	8"	FC 8"	NO	T						
4	U	W													
5	M	S													
6	U	W													

CONTROLLER CABINET SIZE : ORDINARY BASE CABINET: YES

COMMENTS: ADDED COUNTDOWN PED SIGNALS IN ALL DIRECTIONS