


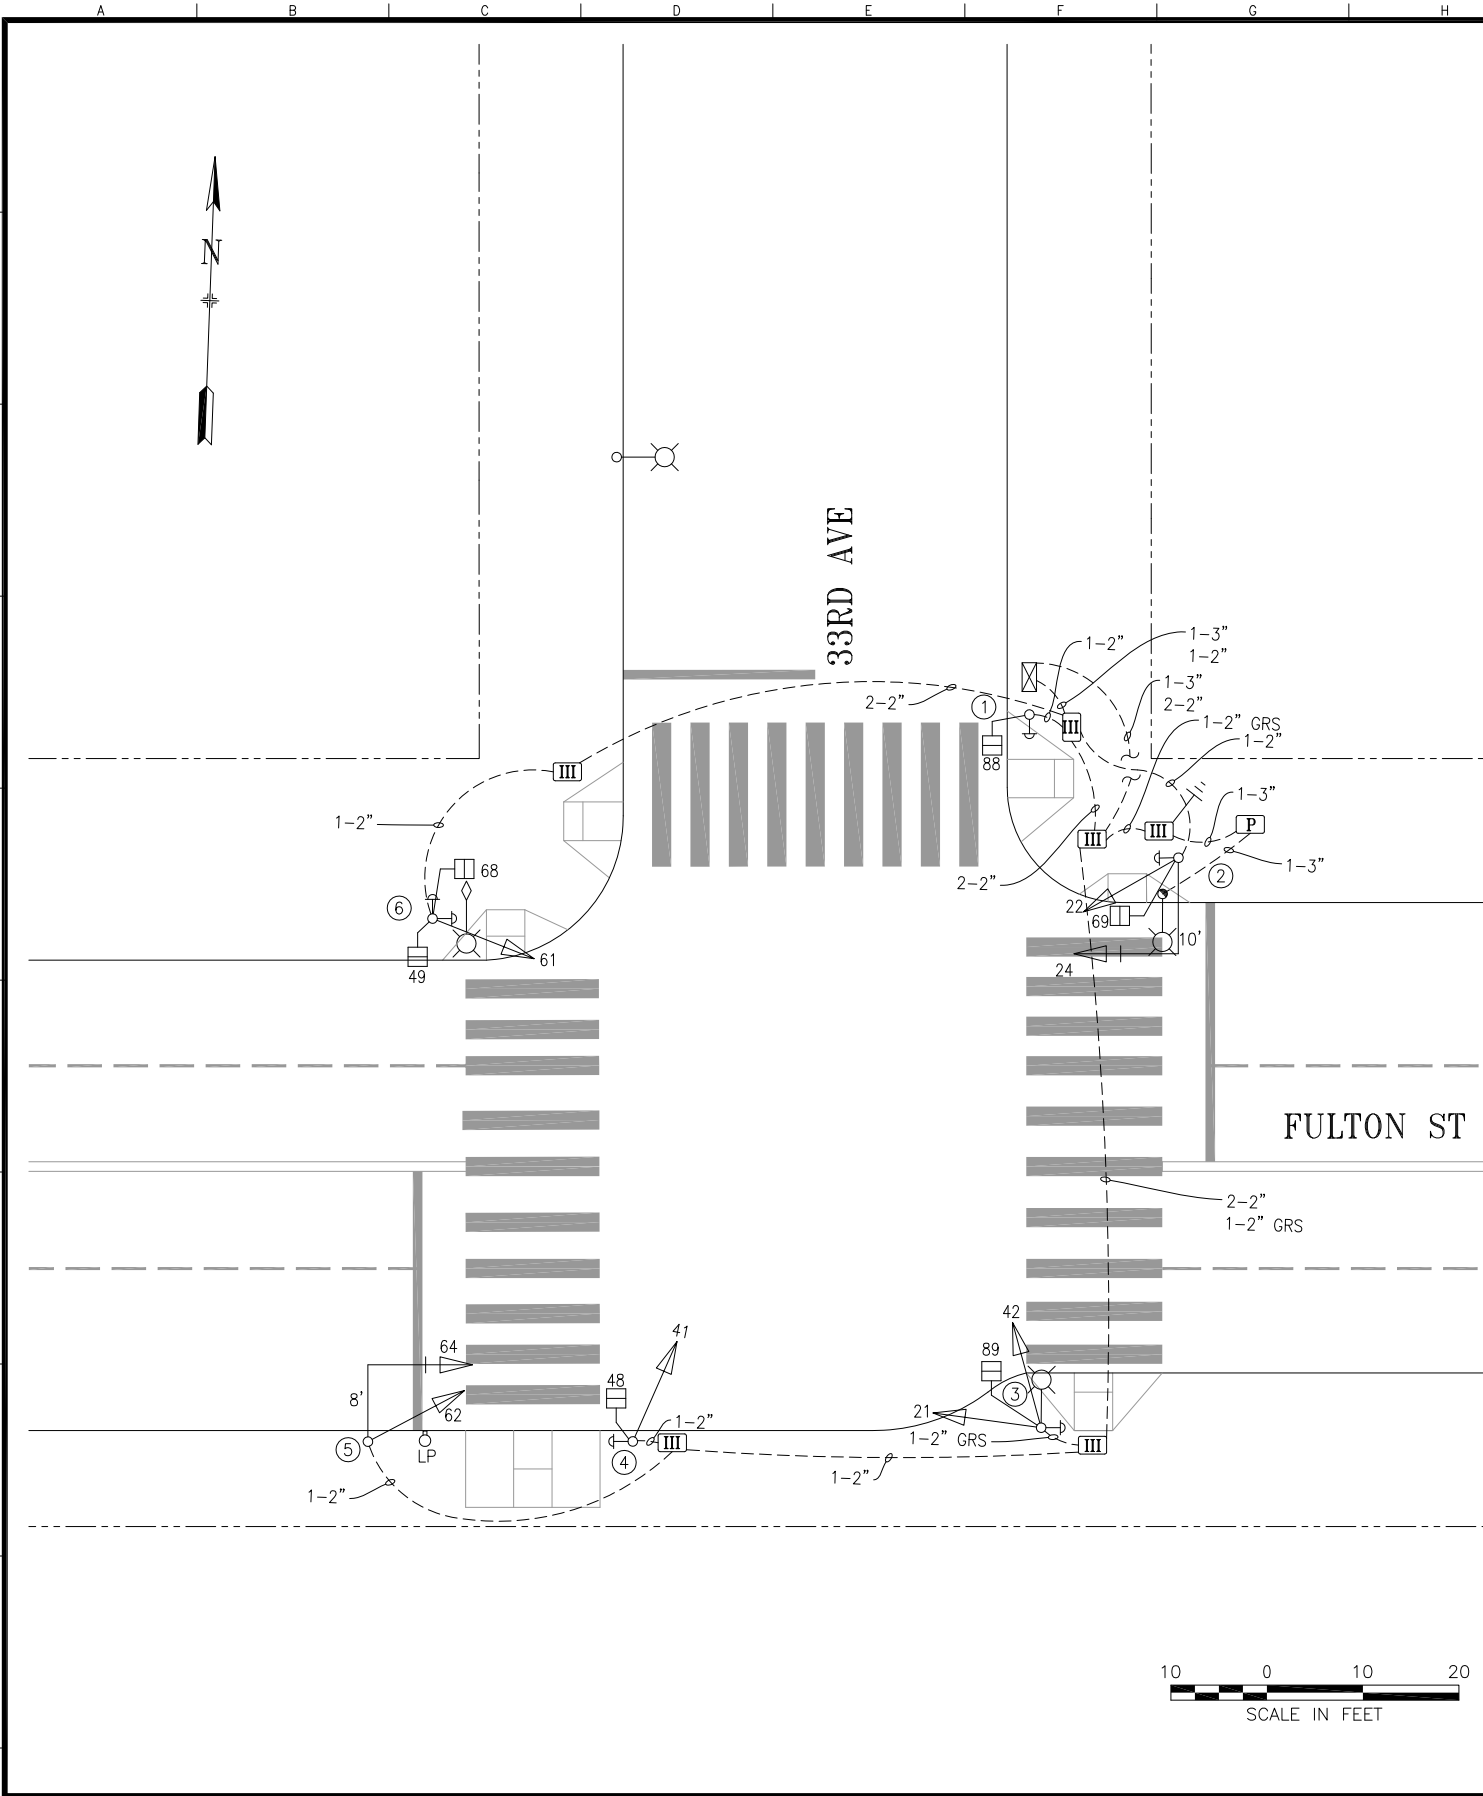

POLE AND EQUIPMENT SCHEDULE										
POLE No.	TYPE OF POLE	LUMINAIRE VOLTAGE/WATTAGE	VEHICLE SIGNAL				PEDESTRIAN SIGNAL			REMARKS
			No.	TYPE	MOUNTING	VISORS	No.	TYPE	MOUNTING	
①	1-A (7')						88	1S-COUNT	TP-1	APS-2W
②	16-2-100 WITH 10' MAST ARM		22 24	3S12" 3S12"	TV-1-T MAS ①	T T	69	1S-COUNT	SP-1	APS-2W BACKPLATE FOR SIGNAL 24
③	CITY STANDARD WITH 6' LUMINAIRE ARM	LED 120/54W	21 42	3S12" 3S12"	SV-2-TC	T T	89	1S-COUNT	SP-1	APS-2W
④	1-A (10')		41	3S12"	TV-1-T	T	48	1S-COUNT	SP-1	APS-2W
⑤	16-2-100 WITH 8' MAST ARM		62 64	3S12" 3S12"	SV-1-T MAS ①	T T				BACKPLATE FOR SIGNAL 64
⑥	1-A (10')		61	3S12"	TV-1-T	T	49 68	1S-COUNT 1S-COUNT	SP-1-SF (12'') SP-1 (22'')	APS-2W APS-2W

SHEET NOTES:

① PLUMBIZER MOUNTED BETWEEN GREEN AND YELLOW

0	11/30/17	NEW SIGNAL ACTIVATED THROUGH #2772J	AScales	GDeLeon	
NO.	DATE	DESCRIPTION	BY	APP.	
TABLE OF REVISIONS					
CHECK WITH TRACING TO SEE IF YOU HAVE LATEST REVISION					

REFERENCE INFORMATION & FILE NO. OF SURVEYS



SAN FRANCISCO MUNICIPAL TRANSPORTATION AGENCY
CITY AND COUNTY OF SAN FRANCISCO

DRAWN:	DATE:
AS	6/19/18
CHECKED:	DATE:
GD	8/3/18

SCALE:
AS SHOWN
SHEET OF SHEETS
1 OF 1

TRAFFIC SIGNAL INVENTORY DIAGRAM
33RD AVENUE AND FULTON STREET

CNN NO.
27821000
REV NO.
0