


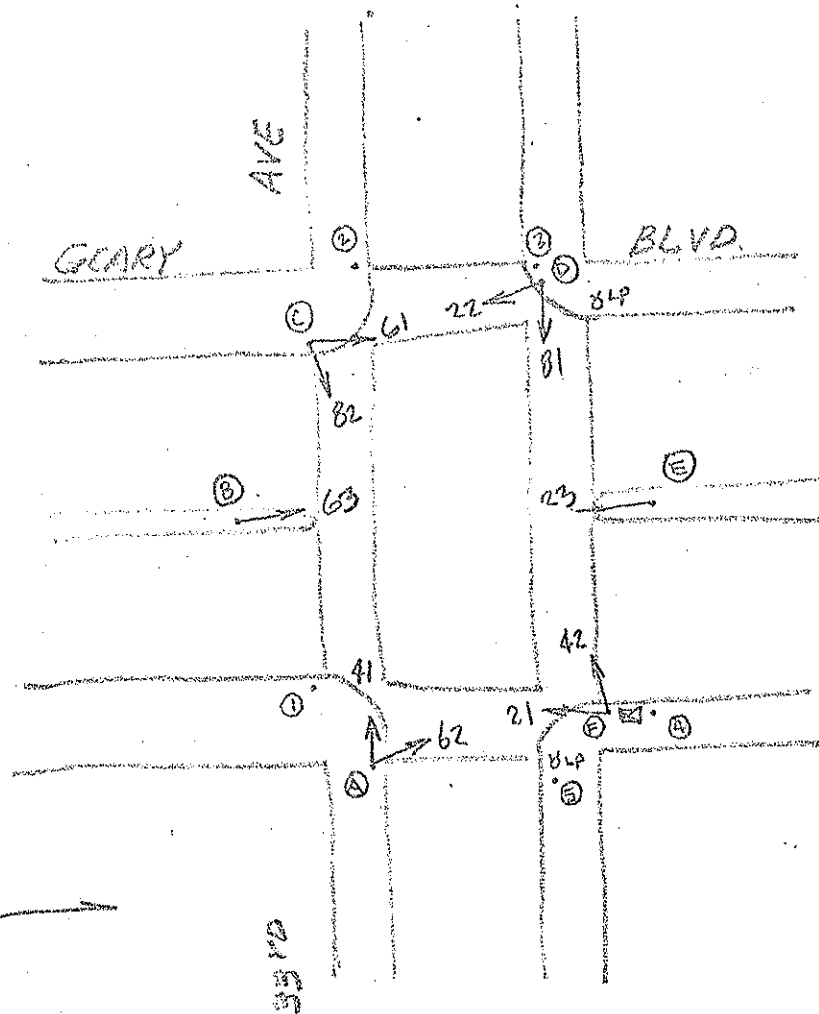

12-13-78

POLE	FUNC	MAT'L	SIGNAL NO.	MAKE	NO. OF SECT.	SIZE	VISOR	B.P. OR LOUVERS	MOUN'T	PED SIGNAL NO.	LEGEND	MESSAGE		MAKE	MOUN'T
												ELEMENT	COLOR		
A	S	S	41	EC	3	8"	FC 8"	NO	T						
B	L	C	62	EC	3	8"	FC 8"	NO	T						
C	S	C	63	EO	3	8"	FC 8"	NO	S						
D	S	C	82	EC	3	8"	FC 8"	NO	T						
E	L	C	61	EC	3	8"	FC 8"	NO	T						
F	S	C	22	EC	3	8"	FC 8"	NO	T						
			81	EC	3	8"	FC 8"	NO	T						
1	M	S	23	GA	3	8"	FC 8"	NO	S						
2	M	S	42	EO	3	8"	FC 8"	NO	T						
3	M	S	21	EO	3	8"	FC 8"	NO	T						
4	M	S													
5	U	W													

CONTROLLER CABINET SIZE : ORDINARY BASE CABINET: YES

COMMENTS :