


34TH AVE. & CLEARFIELD, SLOOT

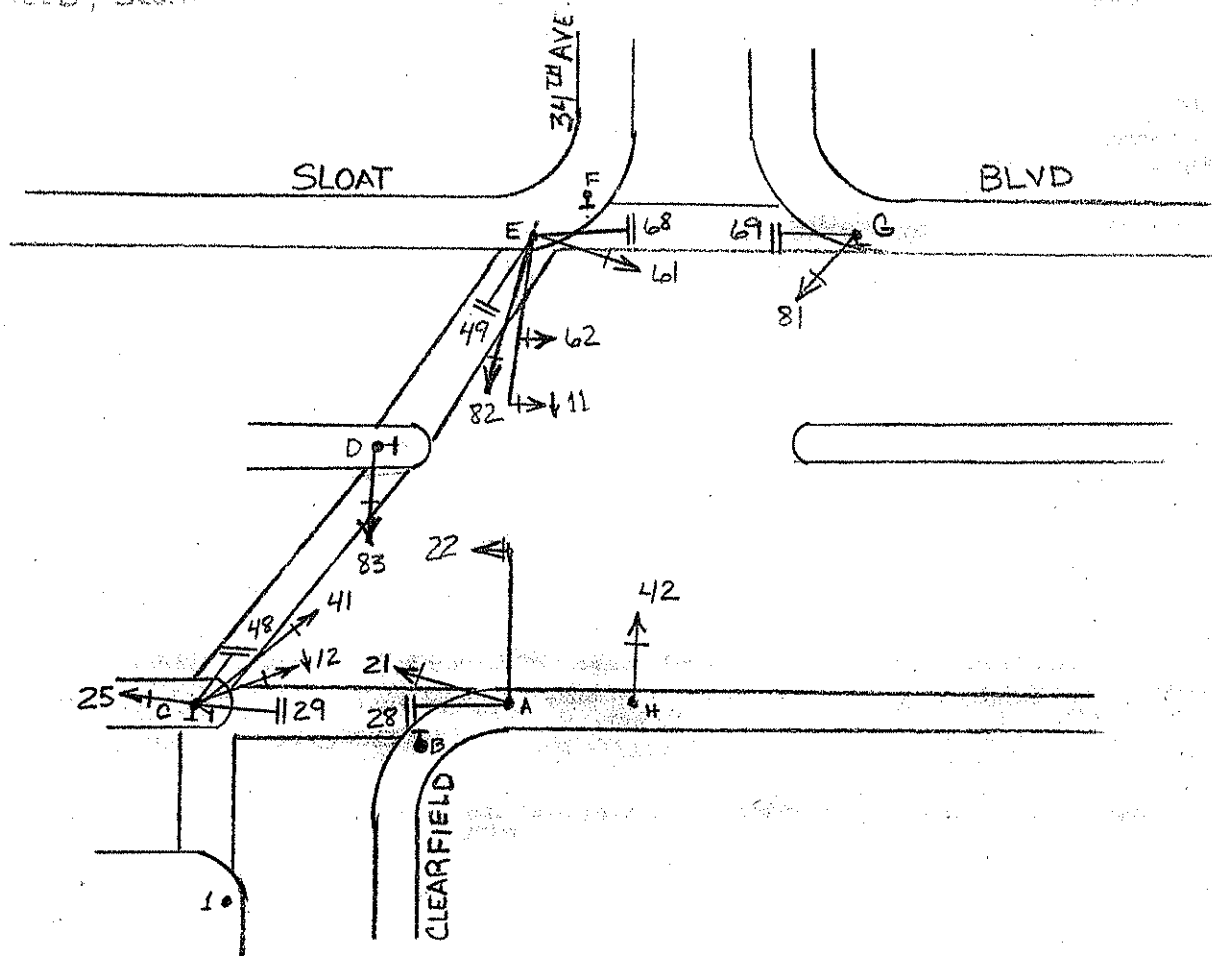

6-29-95

POLE	FUNC	MAT'L	SIGNAL NO.	MAKE	NO. OF SECT.	SIZE	VISOR	B.P. OR LOUVERS	MOUN'T	PED SIGNAL NO.	LEGEND	MESSAGE		MAKE	MOUN'T
												ELEMENT	COLOR		
A	S	S	11	PV	3	12" ←	CAP	BP	A	28	I	15-1	W/OR	ICC	S
B	S	S	12	PV	3	12" ←	CAP	BP	S	29	I	15-1	W/OR	ICC	S
C	L	S	21	State	3	12"	FC	BP	S	48	I	15-1	W/OR	ICC	S
D	S	S	22	PV	3	12"	CAP	BP	A	49	I	15-1	W/OR	ICC	S
E	L	S	25	State	3	12"	FC	BP	S	68	I	15-1	W/OR	ICC	S
F	S	S	41	PV	3	12"	CAP	BP	S	69	I	15-1	W/OR	ICC	S
G	L	S	42	State	3	12"	FC	BP	S						
H	L	S	61	PV	3	12"	CAP	BP	S						
			62	PV	3	12"	CAP	BP	A						
I	L	S	81	State	3	12"	FC	BP	S						
			82	State	3	12"	FC	BP	S						
			83	PV	3	12"	CAP	BP	T						

CONTROLLER CABINET SIZE : ORDINARY BASE CABINET : YES

COMMENTS : Could not identify make of signals