


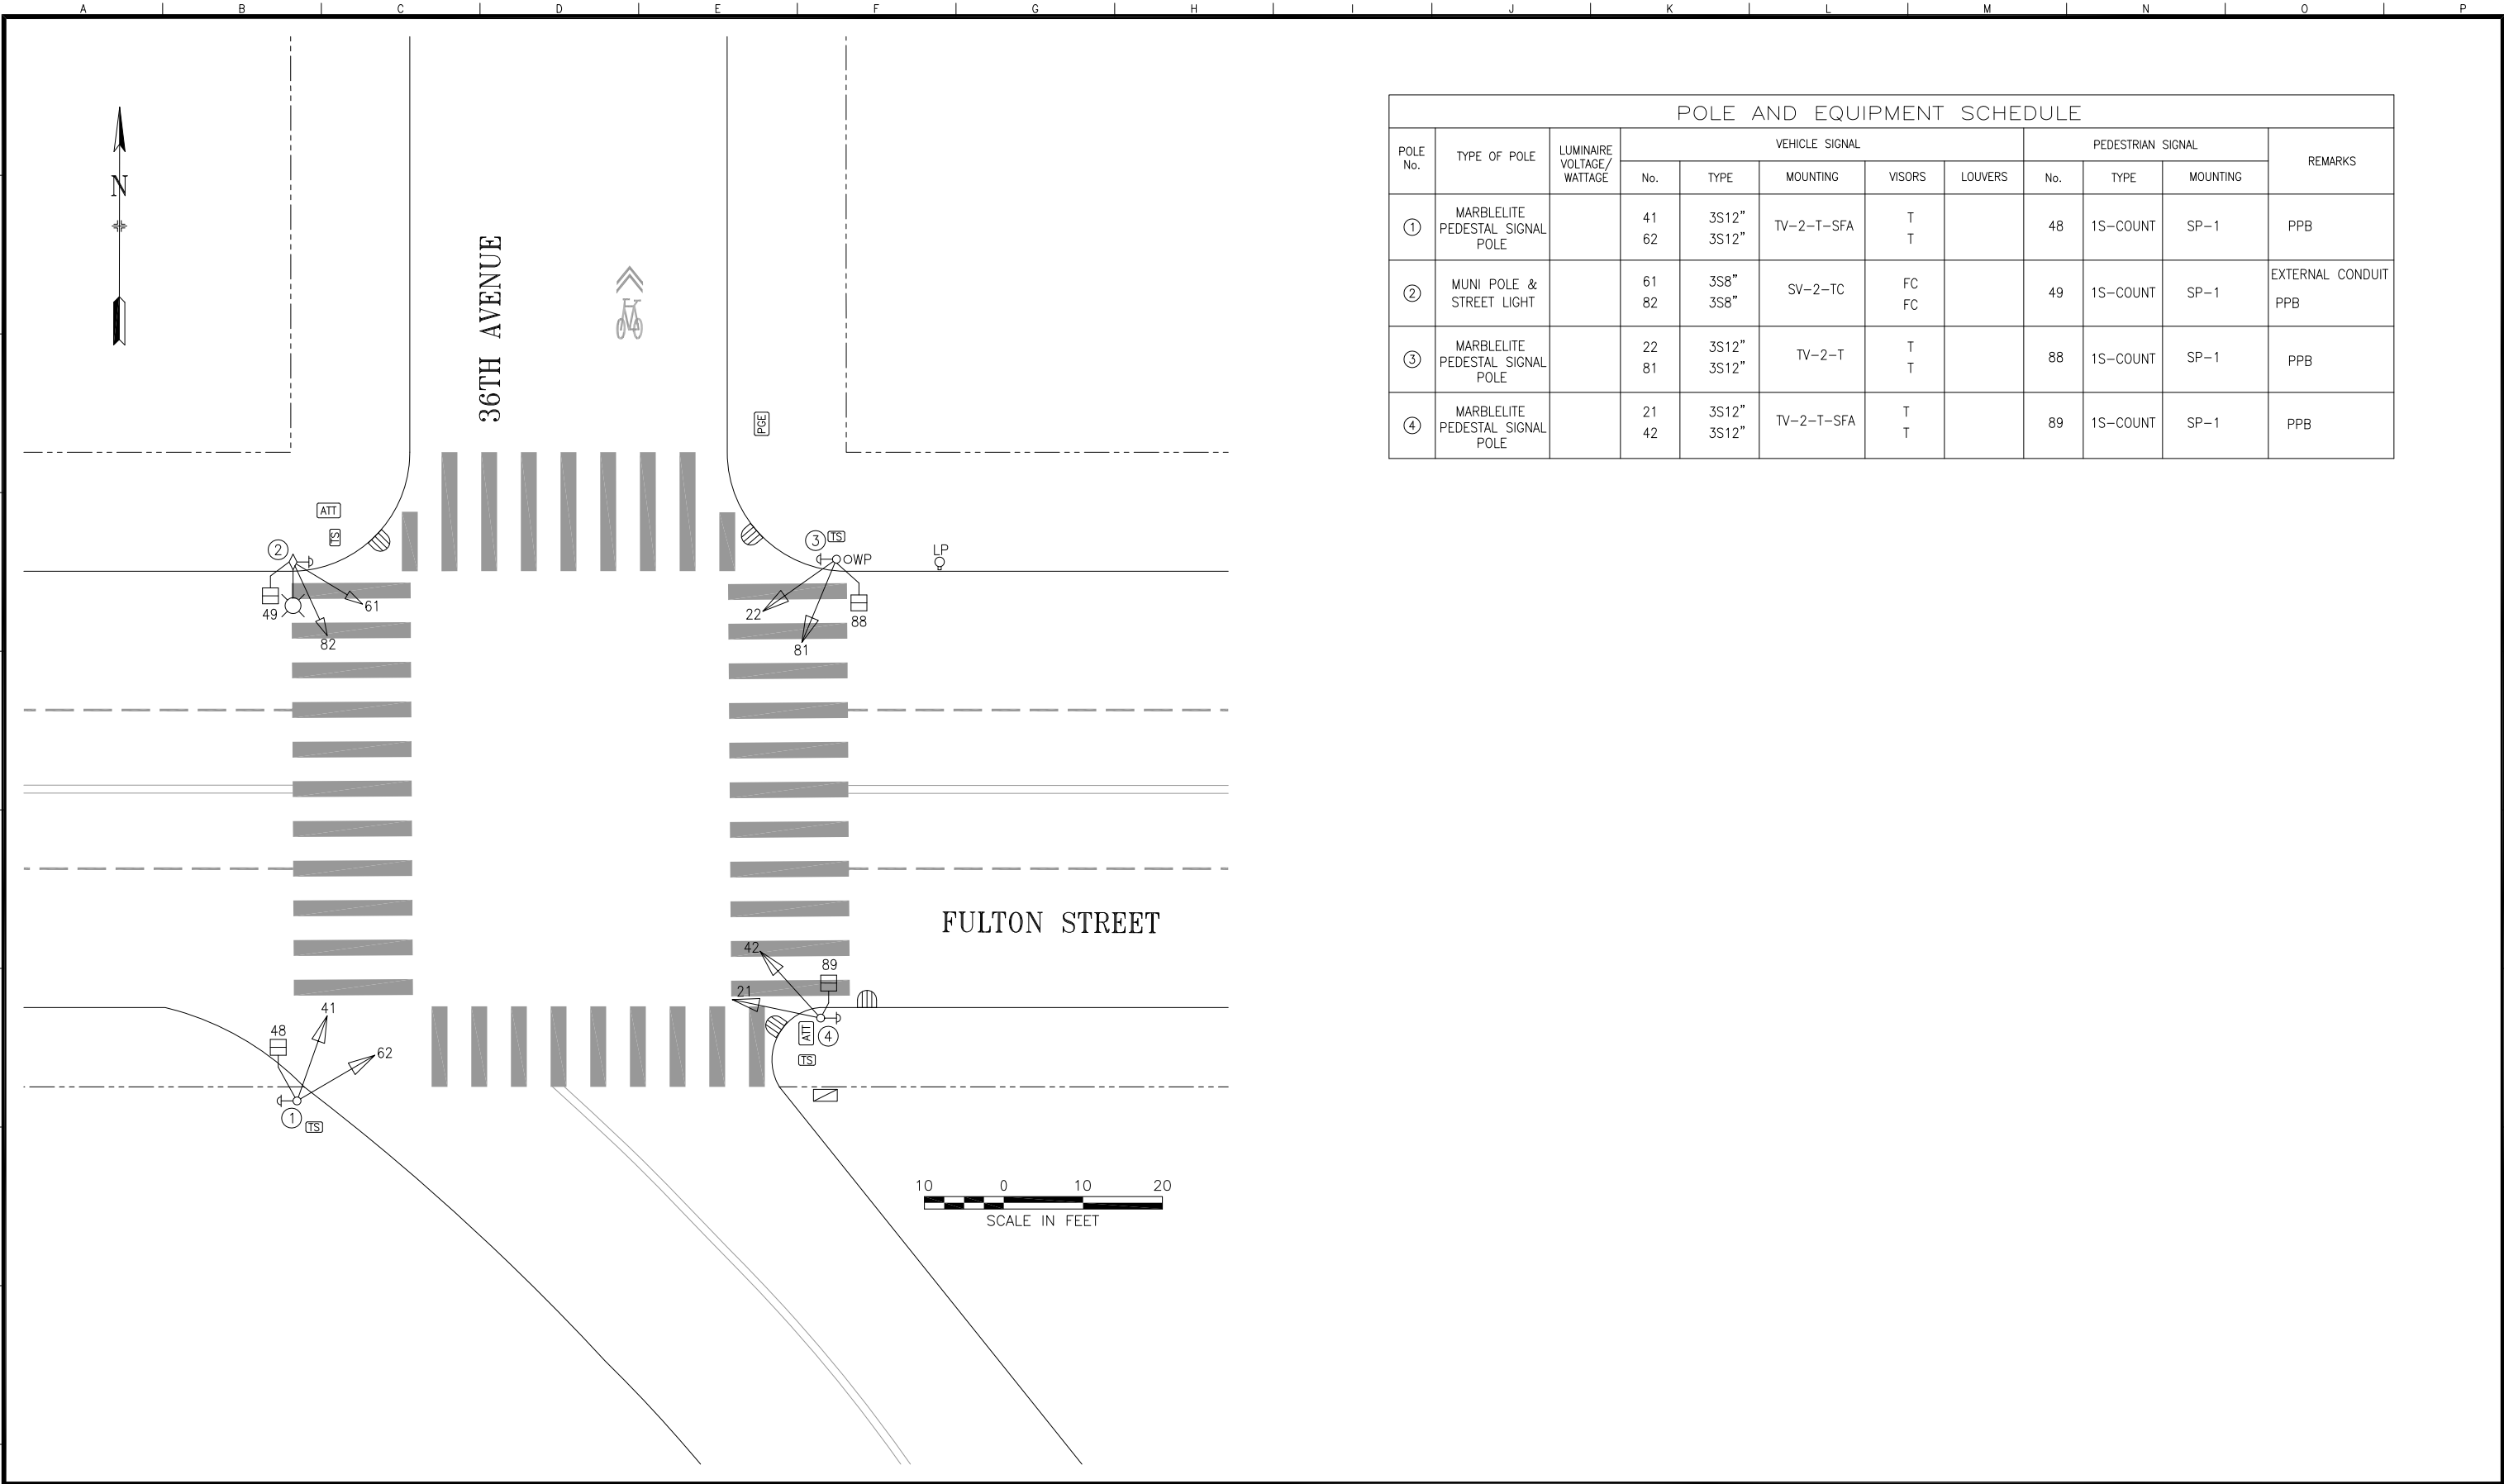

POLE AND EQUIPMENT SCHEDULE											
POLE No.	TYPE OF POLE	LUMINAIRE VOLTAGE/ WATTAGE	VEHICLE SIGNAL					PEDESTRIAN SIGNAL			REMARKS
			No.	TYPE	MOUNTING	VISORS	LOUVERS	No.	TYPE	MOUNTING	
①	MARBLELITE PEDESTAL SIGNAL POLE		41 62	3S12" 3S12"	TV-2-T-SFA	T T		48	1S-COUNT	SP-1	PPB
②	MUNI POLE & STREET LIGHT		61 82	3S8" 3S8"	SV-2-TC	FC FC		49	1S-COUNT	SP-1	EXTERNAL CONDUIT PPB
③	MARBLELITE PEDESTAL SIGNAL POLE		22 81	3S12" 3S12"	TV-2-T	T T		88	1S-COUNT	SP-1	PPB
④	MARBLELITE PEDESTAL SIGNAL POLE		21 42	3S12" 3S12"	TV-2-T-SFA	T T		89	1S-COUNT	SP-1	PPB

				REFERENCE INFORMATION & FILE NO. OF SURVEYS		 SAN FRANCISCO MUNICIPAL TRANSPORTATION AGENCY CITY AND COUNTY OF SAN FRANCISCO	DRAWN: DATE: AScales 11/2015		SCALE: AS SHOWN SHEET OF SHEETS 1 OF 1	TRAFFIC SIGNAL INVENTORY DIAGRAM 36TH AVENUE AND FULTON STREET	CNN NO. 27830000			
							CHECKED: DATE: MVelasco 11/2015				REV NO.			
											0			
0	8/5/15	2543J	PUNCHLIST WALKTHROUGH; UPGRADE TO 12"	DYoung	MVelasco									
NO.	DATE	DESCRIPTION		BY	APP.	TABLE OF REVISIONS CHECK WITH TRACING TO SEE IF YOU HAVE LATEST REVISION								