




φ2 →

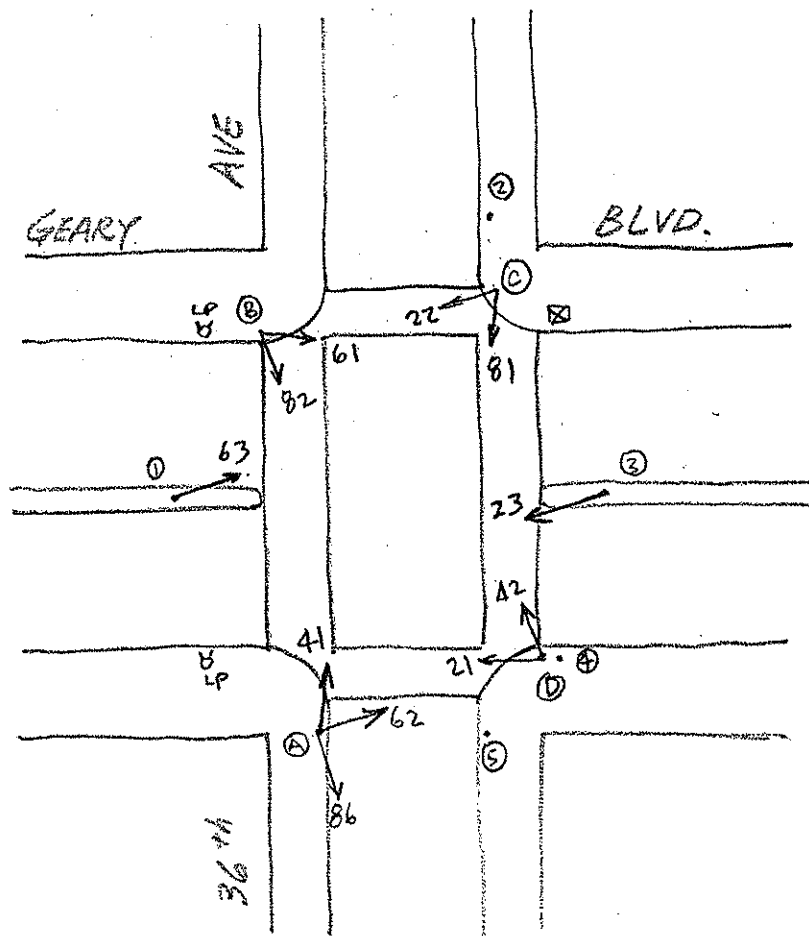

2-20-86

| POLE | FUNC. | MAT'L | SIGNAL NO. | MAKE | NO. OF SECT. | SIZE | VISOR  | B.P. OR LOUVERS | MOUN'T | PED SIGNAL NO. | LEGEND | MESSAGE |       | MAKE | MOUN'T |
|------|-------|-------|------------|------|--------------|------|--------|-----------------|--------|----------------|--------|---------|-------|------|--------|
|      |       |       |            |      |              |      |        |                 |        |                |        | ELEMENT | COLOR |      |        |
| A    | S     | C     | 41         | EC   | 3            | 8"   | FL 8"  | NO              | T      |                |        |         |       |      |        |
| B    | S     | C     | 62         | EC   | 3            | 8"   | FL 8"  | NO              | T      |                |        |         |       |      |        |
| C    | S     | C     | 82         | EC   | 3            | 8"   | FL 8"  | NO              | T      |                |        |         |       |      |        |
| D    | S     | C     | 61         | EC   | 3            | 8"   | FL 8"  | NO              | T      |                |        |         |       |      |        |
|      |       |       | 22         | GA   | 3            | 8"   | FL 8"  | NO              | T      |                |        |         |       |      |        |
| 1    | L     | C     | 81         | GA   | 3            | 8"   | FL 8"  | NO              | T      |                |        |         |       |      |        |
| 2    | U     | W     | 42         | GA   | 3            | 8"   | FL 8"  | NO              | T      |                |        |         |       |      |        |
| 3    | L     | C     | 21         | GA   | 3            | 8"   | FL 8"  | NO              | T      |                |        |         |       |      |        |
| 4    | U     | W     | 86         | EC   | 3            | 8"   | FL 8"  | NO              | T      |                |        |         |       |      |        |
| S    | U     | W     | 63         | EC   | 3            | 12"  | FL 12" | NO              | S      |                |        |         |       |      |        |
|      |       |       | 23         | EC   | 3            | 12"  | FL 12" | NO              | S      |                |        |         |       |      |        |
|      |       |       |            |      |              |      |        |                 |        |                |        |         |       |      |        |
|      |       |       |            |      |              |      |        |                 |        |                |        |         |       |      |        |
CONTROLLER CABINET SIZE : ORDINARY BASE CABINET: NO

COMMENTS :