


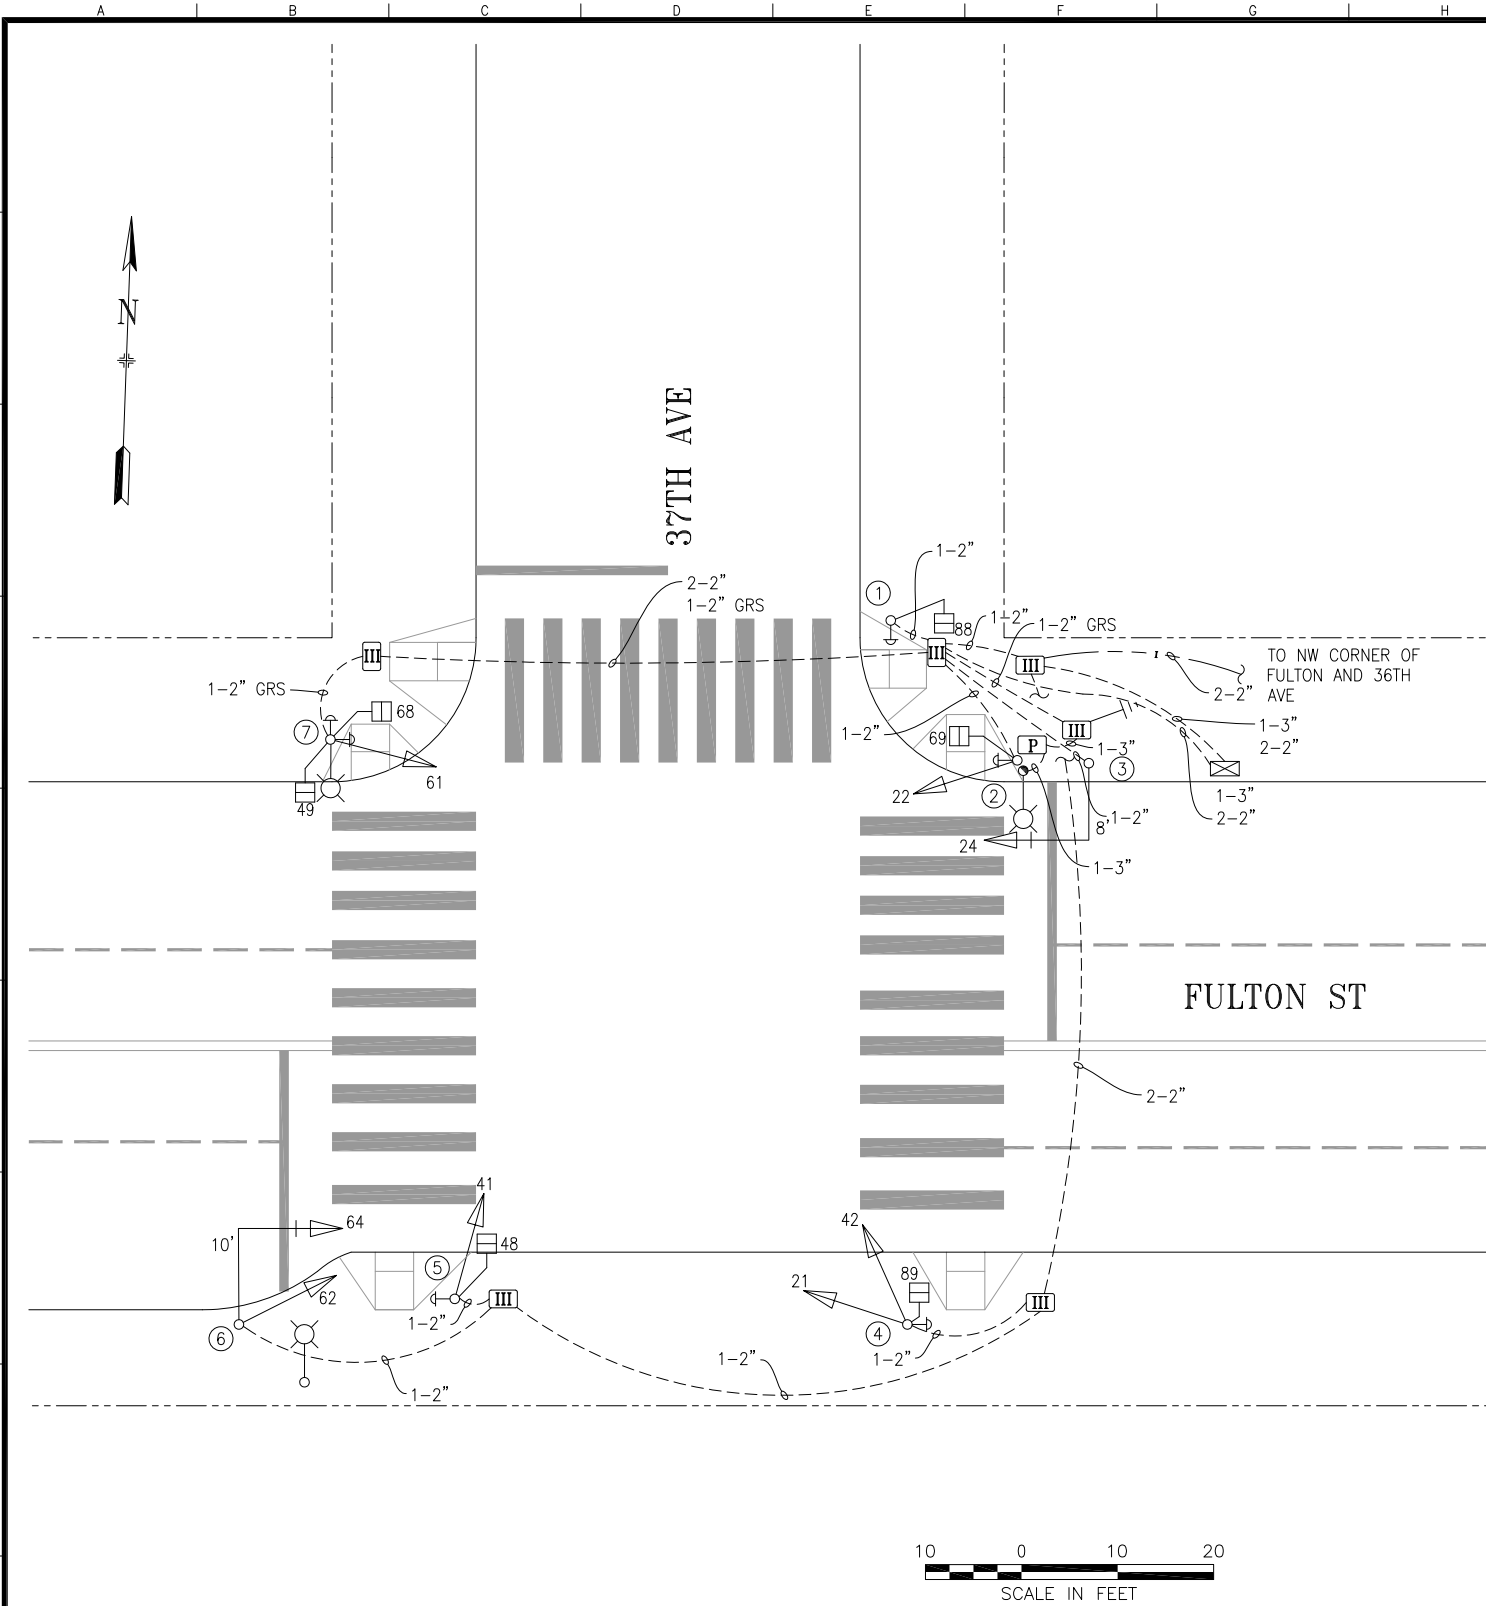

POLE AND EQUIPMENT SCHEDULE											
POLE No.	TYPE OF POLE	LUMINAIRE VOLTAGE/WATTAGE	VEHICLE SIGNAL					PEDESTRIAN SIGNAL			REMARKS
			No.	TYPE	MOUNTING	VISORS	LOUVERS	No.	TYPE	MOUNTING	
①	1-A (7')							88	1S-COUNT	TP-1	APS-2W
②	1-A (10')		22	3S12"	TV-1-T	T		69	1S-COUNT	SP-1	APS-2W
③	16-2-100 WITH 8' MAST ARM		24	3S12"	MAS ①	T					BACKPLATE
④	1-A (10')		21 42	3S12" 3S12"	TV-2-T-SFA	T T		89	1S-COUNT	SP-1	APS-2W
⑤	1-A (10')		41	3S12"	TV-1-T	T		48	1S-COUNT	SP-1	APS-2W
⑥	16-2-100 WITH 10' MAST ARM		62 64	3S12" 3S12"	SV-1-T MAS ①	T T	62 HORIZ LOUVER G BALL @45° UP TO THE RIGHT 64 HORIZ LOUVER G BALL @30° UP TO THE RIGHT				BACKPLATE FOR SIGNAL 64
⑦	CITY STANDARD WITH 6" LUMINAIRE ARM	LED 120/73W	61	3S12"	SV-1-T	T	61 HORIZ LOUVER G BALL @45° UP TO THE LEFT	49 68	1S-COUNT 1S-COUNT	SP-1-SF (12") SP-1 (22")	APS-2W APS-2W

SHEET NOTES:
① PLUMBIZER MOUNTED BETWEEN GREEN AND YELLOW

INTERCONNECT WIRING DETAIL
NOT TO SCALE

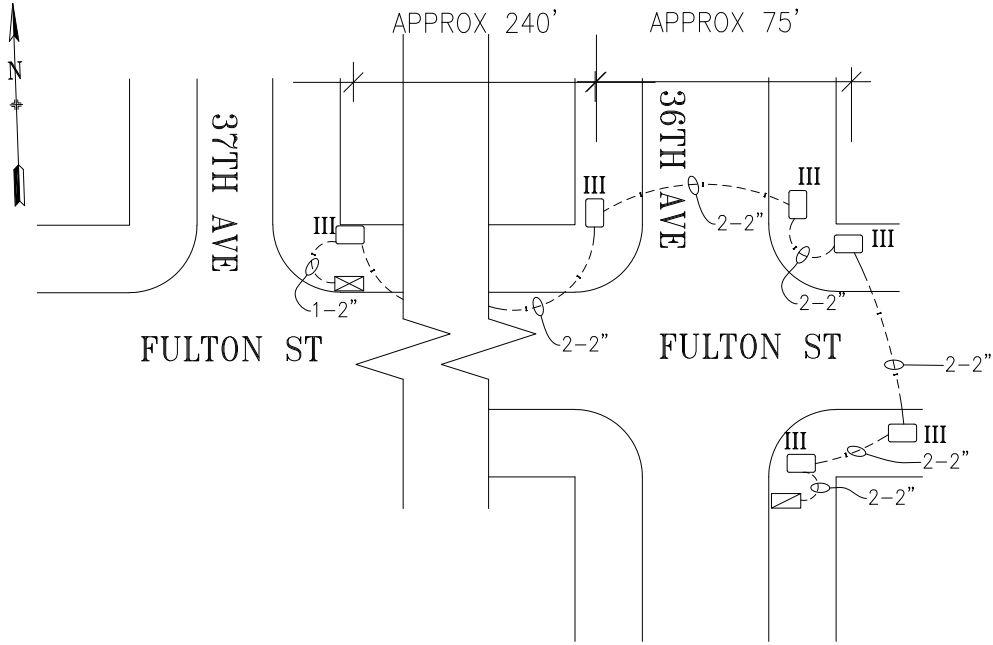


TABLE OF REVISIONS			CHECK WITH TRACING TO SEE IF YOU HAVE LATEST REVISION	
NO.	DATE	DESCRIPTION	BY	APP.
1	12/23/19	ADD LOUVERS TO PHASE 6 SIGNALS (SRC 2019-412)	D'treung	GDeLeon
0	11/2/17	NEW SIGNAL ACTIVATED THROUGH #2772J	AScales	GDeLeon

REFERENCE INFORMATION & FILE NO. OF SURVEYS



SAN FRANCISCO MUNICIPAL TRANSPORTATION AGENCY
CITY AND COUNTY OF SAN FRANCISCO

DRAWN:	DATE:
AS	6/19/18
CHECKED:	DATE:
GD	8/3/18

SCALE:
AS SHOWN
SHEET OF SHEETS
1 OF 1

TRAFFIC SIGNAL INVENTORY DIAGRAM
37TH AVENUE AND FULTON STREET

CNN NO.
27862000
REV NO.
1