




POLE AND EQUIPMENT SCHEDULE										
POLE No.	TYPE OF POLE	LUMINAIRE VOLTAGE/ WATTAGE	VEHICLE SIGNAL					PEDESTRIAN SIGNAL		REMARKS
			No.	TYPE	MOUNTING	VISORS	LOUVERS	No.	TYPE	
①	CITY STANDARD STREETLIGHT	120V/150W						88	POLY 1S-COUNT	APS
								69	POLY 1S-COUNT	SP-1 (22")
②	PPBP									SP-1-SF
③	EX. MARBLITE SL W/ DUAL LUMINAIRE ARMS		23	POLY3S12"	SV-1-T	T		80	POLY 1S-COUNT	SP-1
④	18-2-100 WITH 25' MAST ARM		21	POLY3S12"	SV-2-TC	T		89	POLY 1S-COUNT	APS
			42	POLY3S12"	MAS	T				POLY-BP
⑤	1-A (10')		41	POLY3S12"	TV-1-T	T		48	POLY 1S-COUNT	SP-1
⑥	EX. MARBLITE SL W/ DUAL LUMINAIRE ARMS		63	POLY3S12"	SV-1-T	T				APS
⑦	18-2-100 WITH 25' MAST ARM		61	POLY3S12"	SV-1-T	T		68	POLY 1S-COUNT	SP-1
			64	POLY3S12"	MAS	T				POLY-BP
⑧	1-A (7')							49	POLY 1S-COUNT	TP-1

TABLE OF REVISIONS				
NO.	DATE	DESCRIPTION	BY	APP.
1	4/13/15	PED SIGNAL 80 ACTIVATED PER CHANGE ORDER TO 2246J	JH	MV
0	1/29/15	ACTIVATED THRU 2246J; CONVERTED FROM CONTRACT PLANS	JH	MV

REFERENCE INFORMATION & FILE NO. OF SURVEYS	

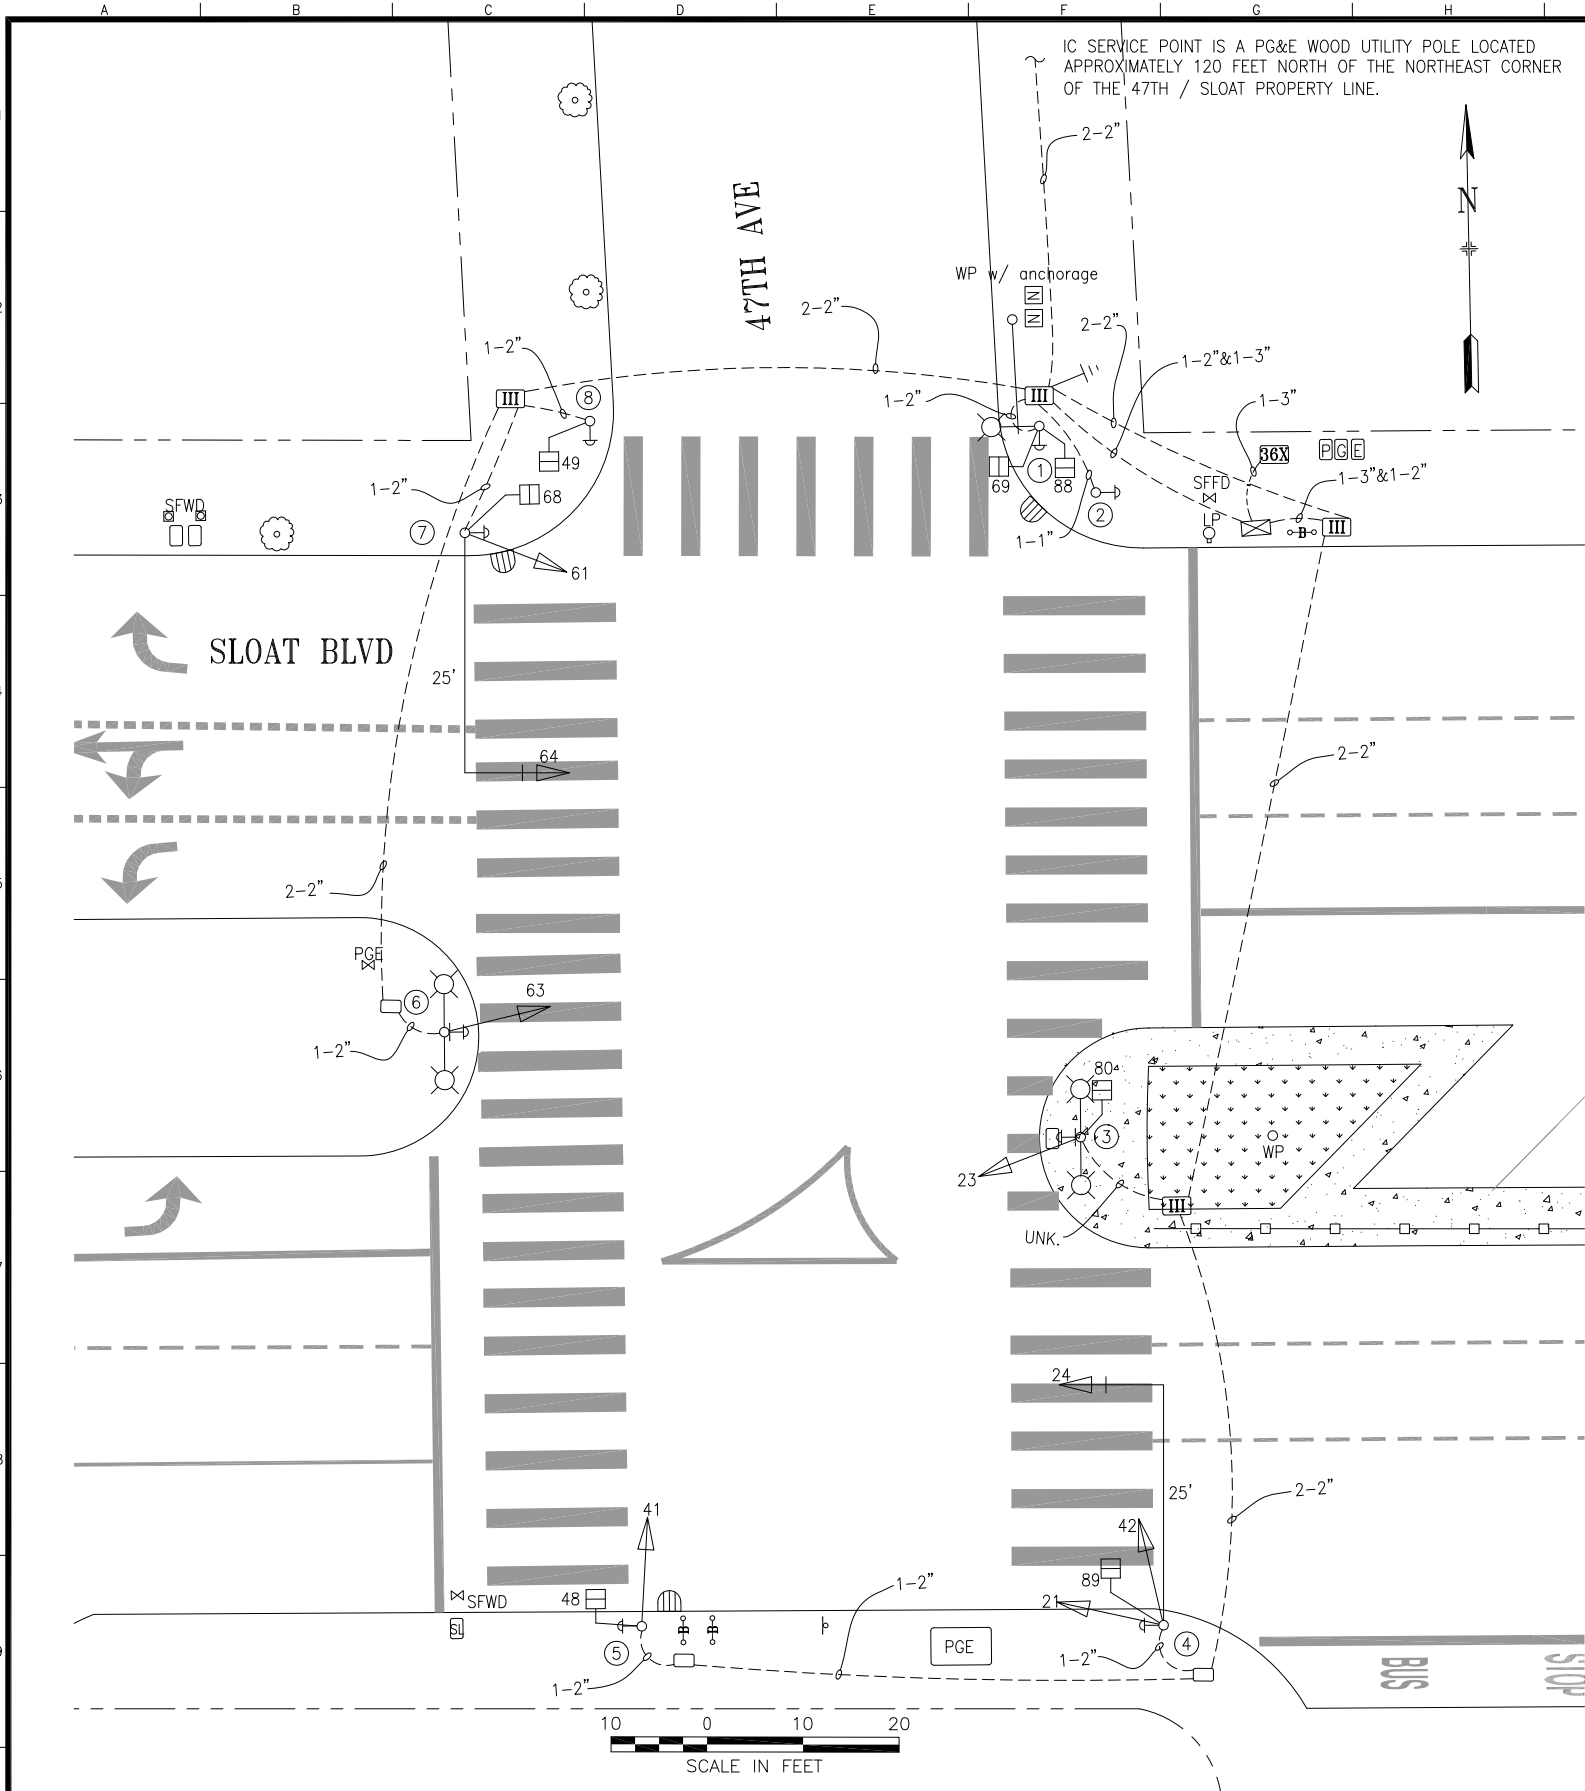

SAN FRANCISCO MUNICIPAL TRANSPORTATION AGENCY
CITY AND COUNTY OF SAN FRANCISCO

DRAWN:	DATE:
JH	08/15
CHECKED:	DATE:
MV	08/15

SCALE:
AS SHOWN
SHEET OF SHEETS
1 OF 1

TRAFFIC SIGNAL INVENTORY DIAGRAM	
47TH AVENUE AND SLOAT BOULEVARD	

CNN NO.
23493000
REV NO.
1