



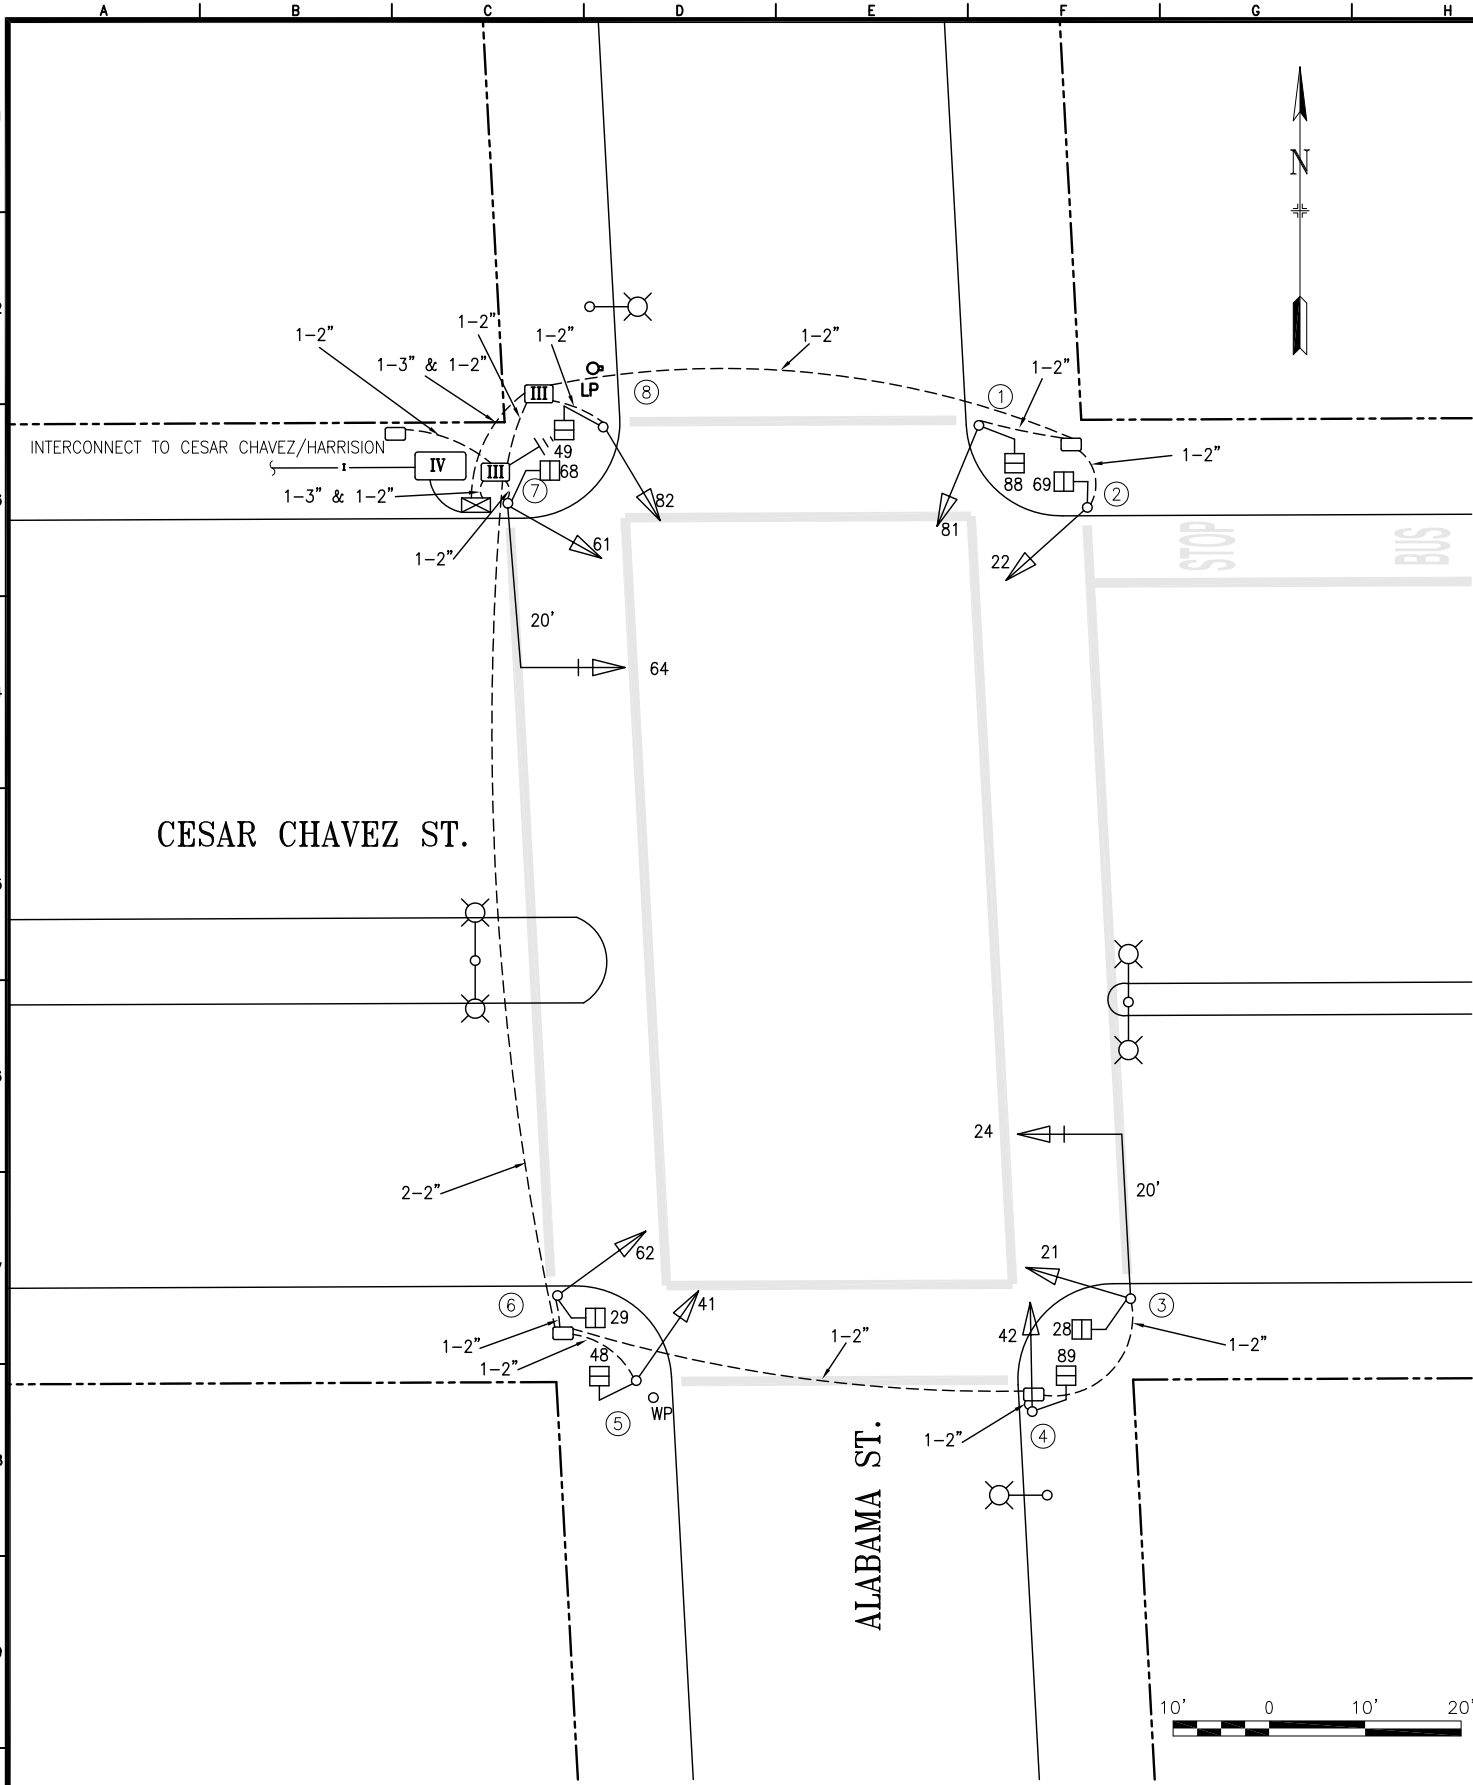

POLE AND EQUIPMENT SCHEDULE										
POLE No.	TYPE OF POLE	VEHICLE SIGNAL					PEDESTRIAN SIGNAL			REMARKS
		No.	TYPE	MOUNTING	VISORS	LOUVERS	No.	TYPE	MOUNTING	
①	1-A (10')	81	3S12"	TV-1-T	T		88	1S-COUNT	SP-1	
②	1-A (10')	22	3S12"	TV-1-T	T		69	1S-COUNT	SP-1	
③	16-1-70 W/ 20' MASTARM	24 21	3S12" 3S12"	MAS SV-1-T	FC		28	1S-COUNT	SP-1	BACKPLATE
④	1-A (10')	42	3S12"	TV-1-T	T		89	1S-COUNT	SP-1	
⑤	1-A (10')	41	3S12"	TV-1-T	T		48	1S-COUNT	SP-1	
⑥	1-A (10')	62	3S12"	TV-1-T	T		29	1S-COUNT	SP-1	
⑦	16-1-70 W/ 20' MASTARM	64 61	3S12" 3S12"	MAS SV-1-T	T		68	1S-COUNT	SP-1	BACKPLATE
⑧	1-A (10')	82	3S12"	TV-1-T	T		49	1S-COUNT	SP-1	

PHASE DIAGRAM

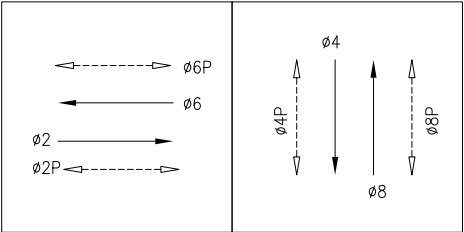

PHASE SEQUENCE

G	Y	R	CESAR CHAVEZ ST (EB & WB) - Ø2 & Ø6		
R		G	Y	R	ALABAMA ST (SB & NB) - Ø4 & Ø8
WM	FRH	RH			PEDS XING ALABAMA ST (SS & NS) - Ø2P & Ø6P
RH		WM	FRH	RH	PEDS XING CESAR CHAVEZ ST (ES & WS) - Ø4P & Ø8P

NO.		DATE	DESCRIPTION	BY	APP.
0		1/2014	SIGNAL UPGRADE ACTIVATED THRU 1068J; CONVERTED FROM 1068J AND 0494J CPs	JH	GD
TABLE OF REVISIONS CHECK WITH TRACING TO SEE IF YOU HAVE LATEST REVISION					

REFERENCE INFORMATION
& FILE NO. OF SURVEYS



SAN FRANCISCO MUNICIPAL TRANSPORTATION AGENCY
CITY AND COUNTY OF SAN FRANCISCO

DRAWN:	DATE:
JH	8/2014
CHECKED:	DATE:
GD	8/2014

SCALE:

AS SHOWN

SHEET OF SHEETS

1 OF 1

TRAFFIC SIGNAL INVENTORY DIAGRAM

ALABAMA ST AND CESAR CHAVEZ ST

CNN NO.

21142000

REV NO.

0