


BROTHERHOOD WAY

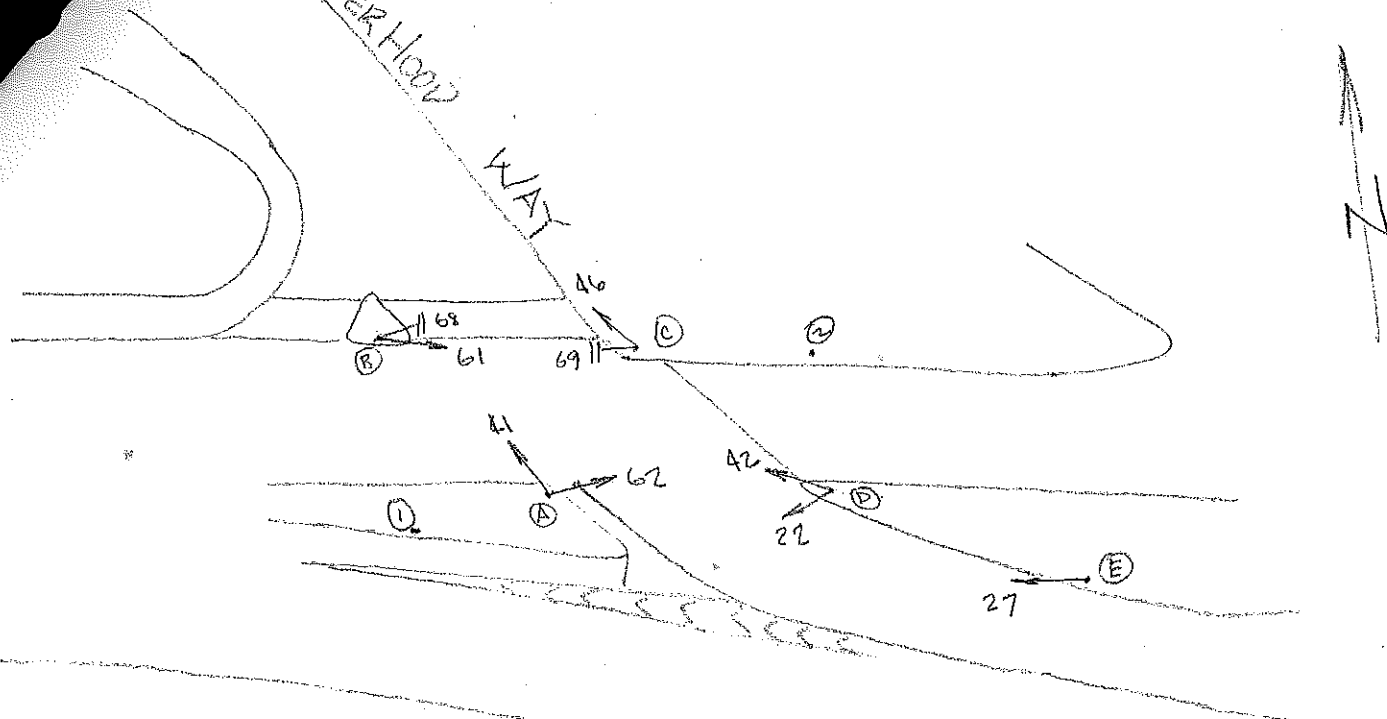

42 → GERMANY

BL

JN

10-15-09

[illegible]

COMMENTS: SRC 09-195 TO INSTALL 12 INCH SIGNAL HEADS-RO
(62, 41, 61, 46, 42)