


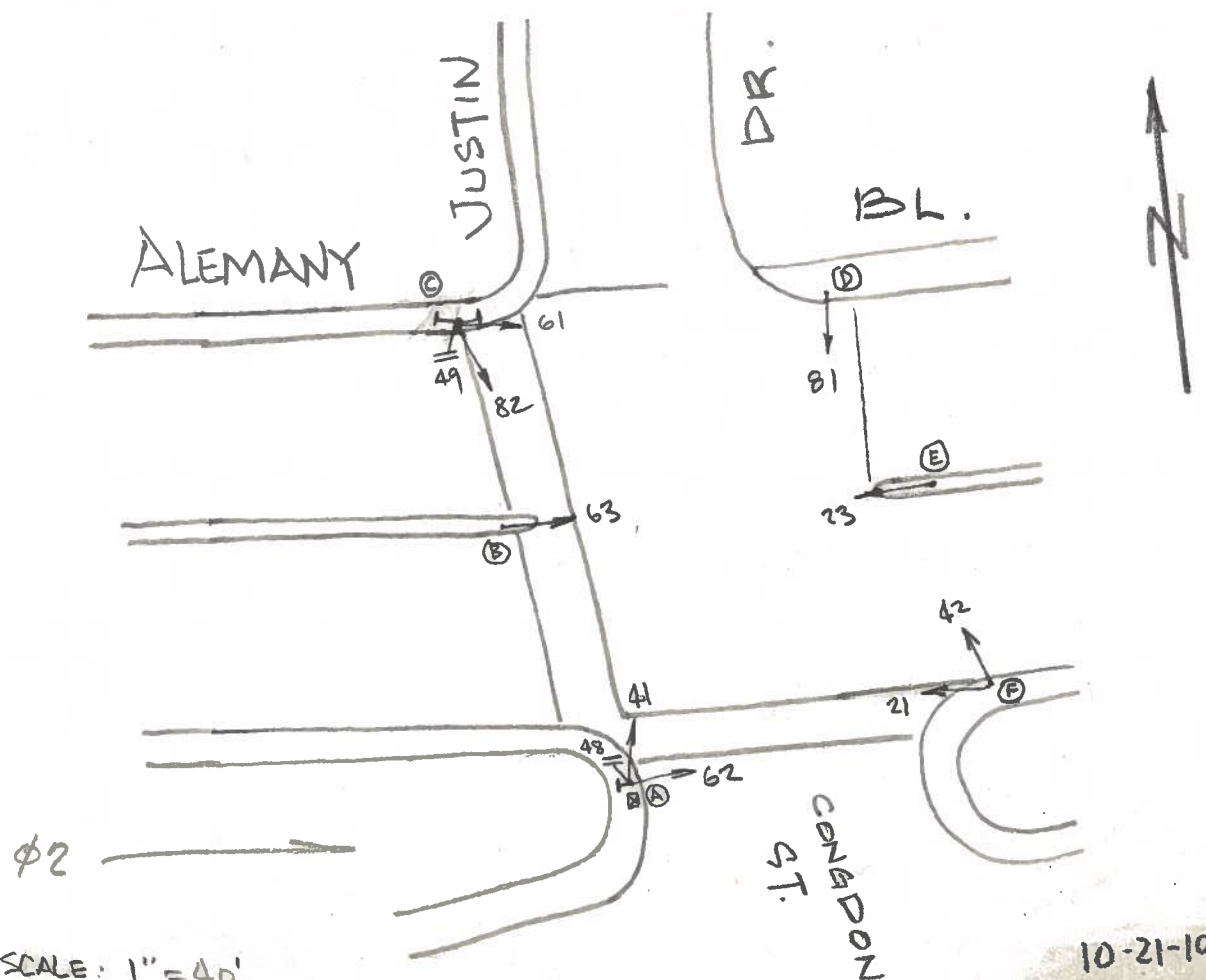

SCALE: 1" = 40'

10-21-19

[illegible]

CONTROLLER CABINET SIZE : ORDINARY BASE CABINET: YES

COMMENTS: Add additional PPB on Pole (C). Show existing PPB on Pole (A) and (B).

SRC 2019- 178. D'Yeung 10-21-19