


ALEMANY & FARRAGUT

42

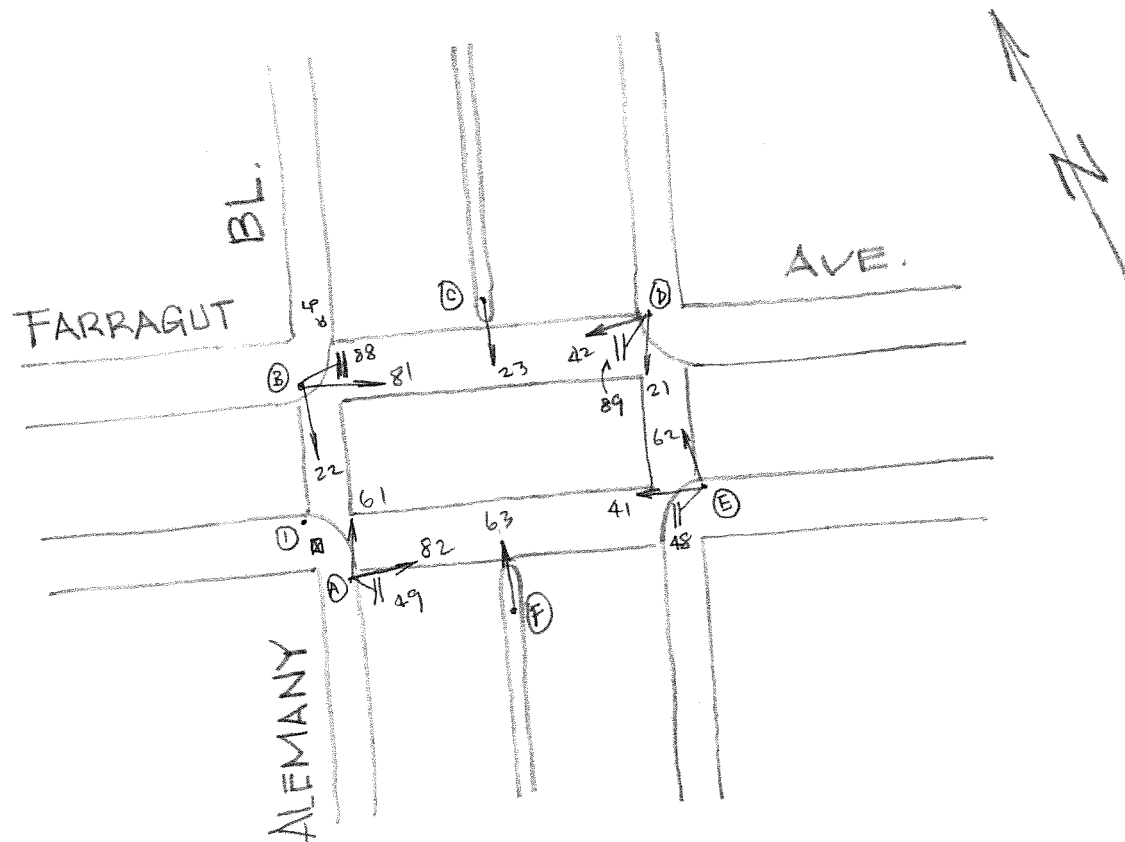

2-26-2016

POLE	FUNC.	MAT'L	SIGNAL NO.	MAKE	NO. OF SECT.	SIZE	VISOR	B.P. OR LOUVERS	MOUN'T	PED SIGNAL NO.	LEGEND	MESSAGE		MAKE	MOUN'T
												ELEMENT	COLOR		
A	S	S	82	EC	3	12"	T	NO	T	49	I	IS-1	W/OR	ICC	S
B	S	S	61	EC	3	12"	T	NO	T	88	I	IS-1	W/OR	ICC	S
C	L	C	22	EC	3	12"	T	NO	T	89	I	IS-1	W/OR	ICC	S
D	S	S	81	EC	3	12"	T	NO	T	48	DW/W	2S-I			S
E	U	W	23	EC	3	12"	T	NO	S						
F	S	S	42	EC	3	12"	T	NO	T						
			21	EC	3	12"	T	NO	T						
			62	EC	3	8"	FC 8"	NO	S						
			41	EC	3	8"	FC 8"	NO	S						
I	U	W	63	EC	3	12"	T	NO	T						

CONTROLLER CABINET SIZE : ORDINARY BASE CABINET: YES

COMMENTS :

UPGRADE ALL VEHICLE SIGNALS EXCEPT 41 & 62 TO 12-INCH

D. YEUNG