


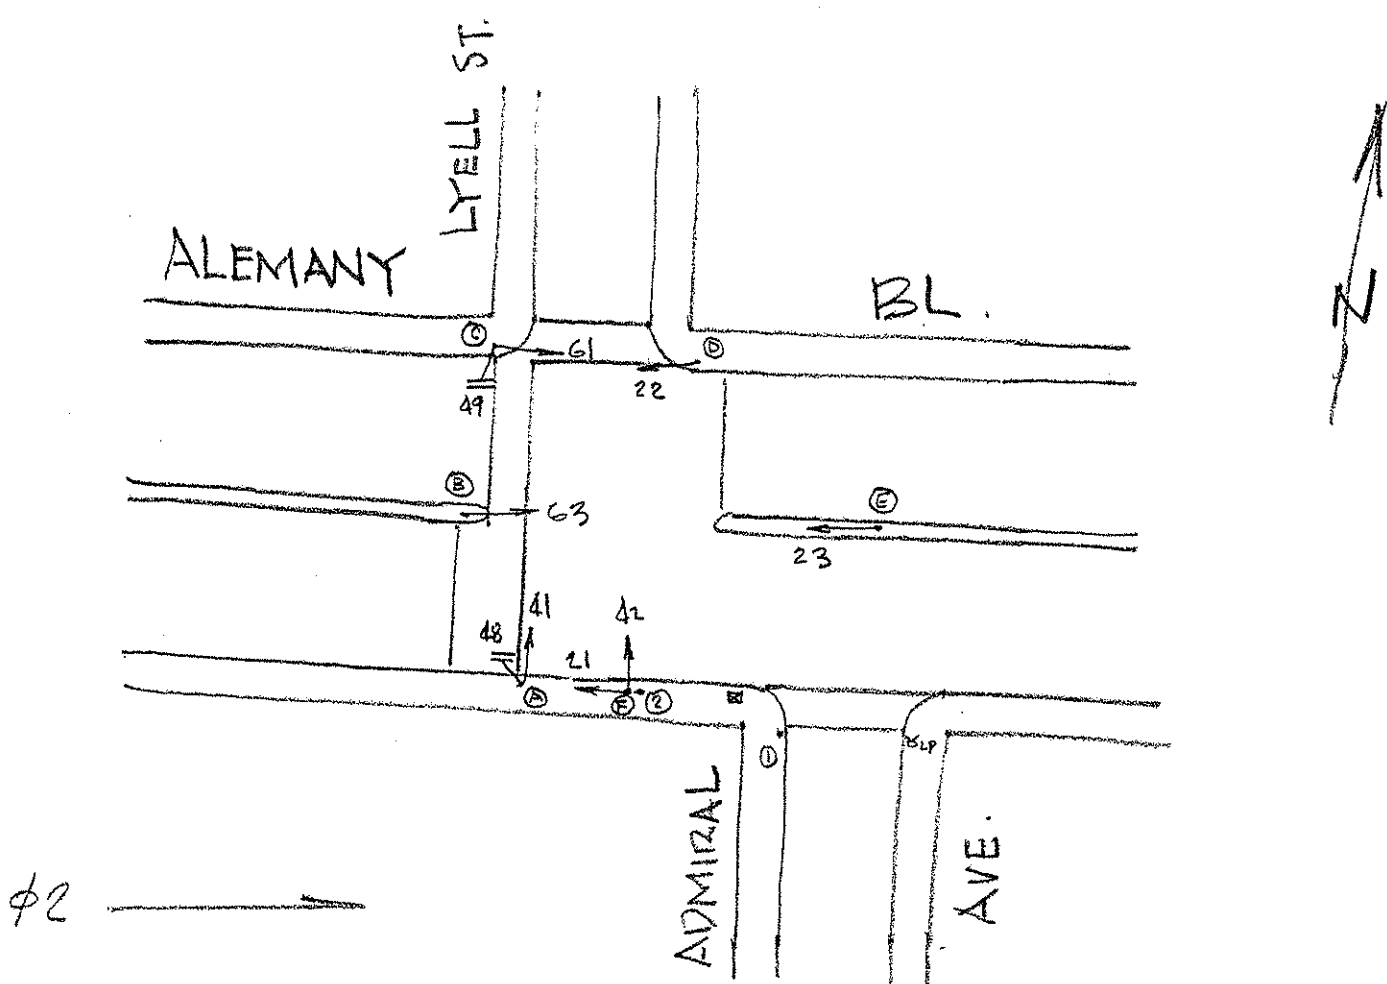

3-31-90

POLE	FUNC.	MAT'L	SIGNAL NO.	MAKE	NO. OF SECT.	SIZE	VISOR	B.P. OR LOUVERS	MOUN'T	PED SIGNAL NO.	LEGEND	MESSAGE		MAKE	MOUN'T
												ELEMENT	COLOR		
A	S	C	41	GA	3	8"	FC 8"	NO	T	48	I	15-1	W/OR	ICC	S
B	L	C	63	GA	3	8"	FC 12"	NO	S	49	I	15-1	W/OR	ICC	S
C	S	C	61	GA	3	8"	FC 8"	NO	T						
D	S	C	22	EC	3	8"	FC 8"	NO	T						
E	L	C	23	EC	3	8"	FC 12"	NO	S						
F	S	C	42	GA	3	8"	FC 8"	NO	T						
			21	GA	3	8"	FC 8"	NO	T						
1	L	S													
2	U	W													

CONTROLLER CABINET SIZE : ORDINARY BASE CABINET: NO

COMMENTS: Replaced 2 Econolite Ped Signals with ICC Ped Signals