


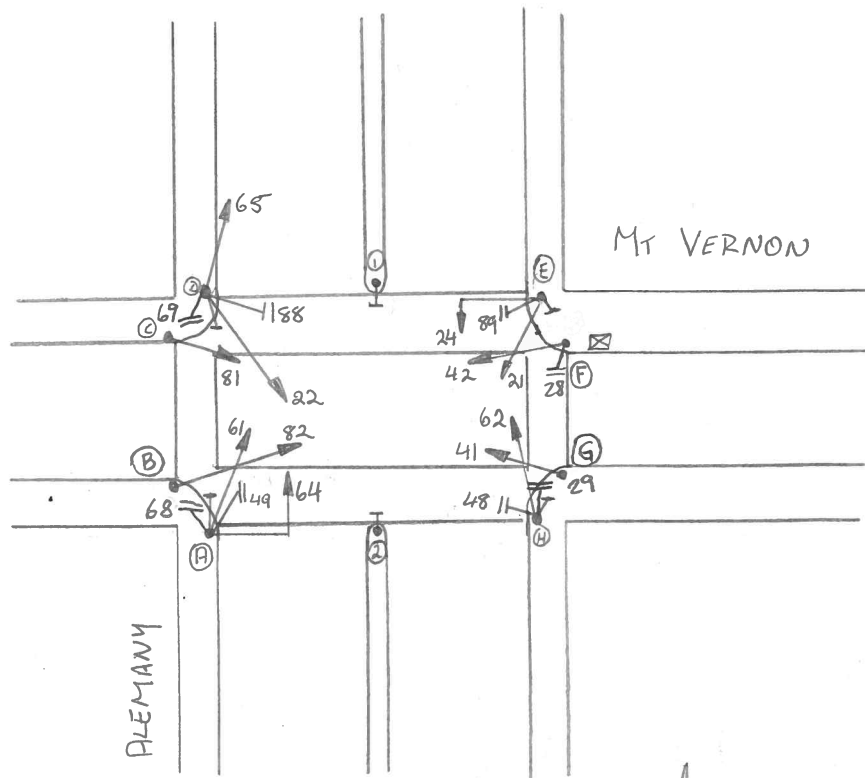

8-16-19

[illegible]