


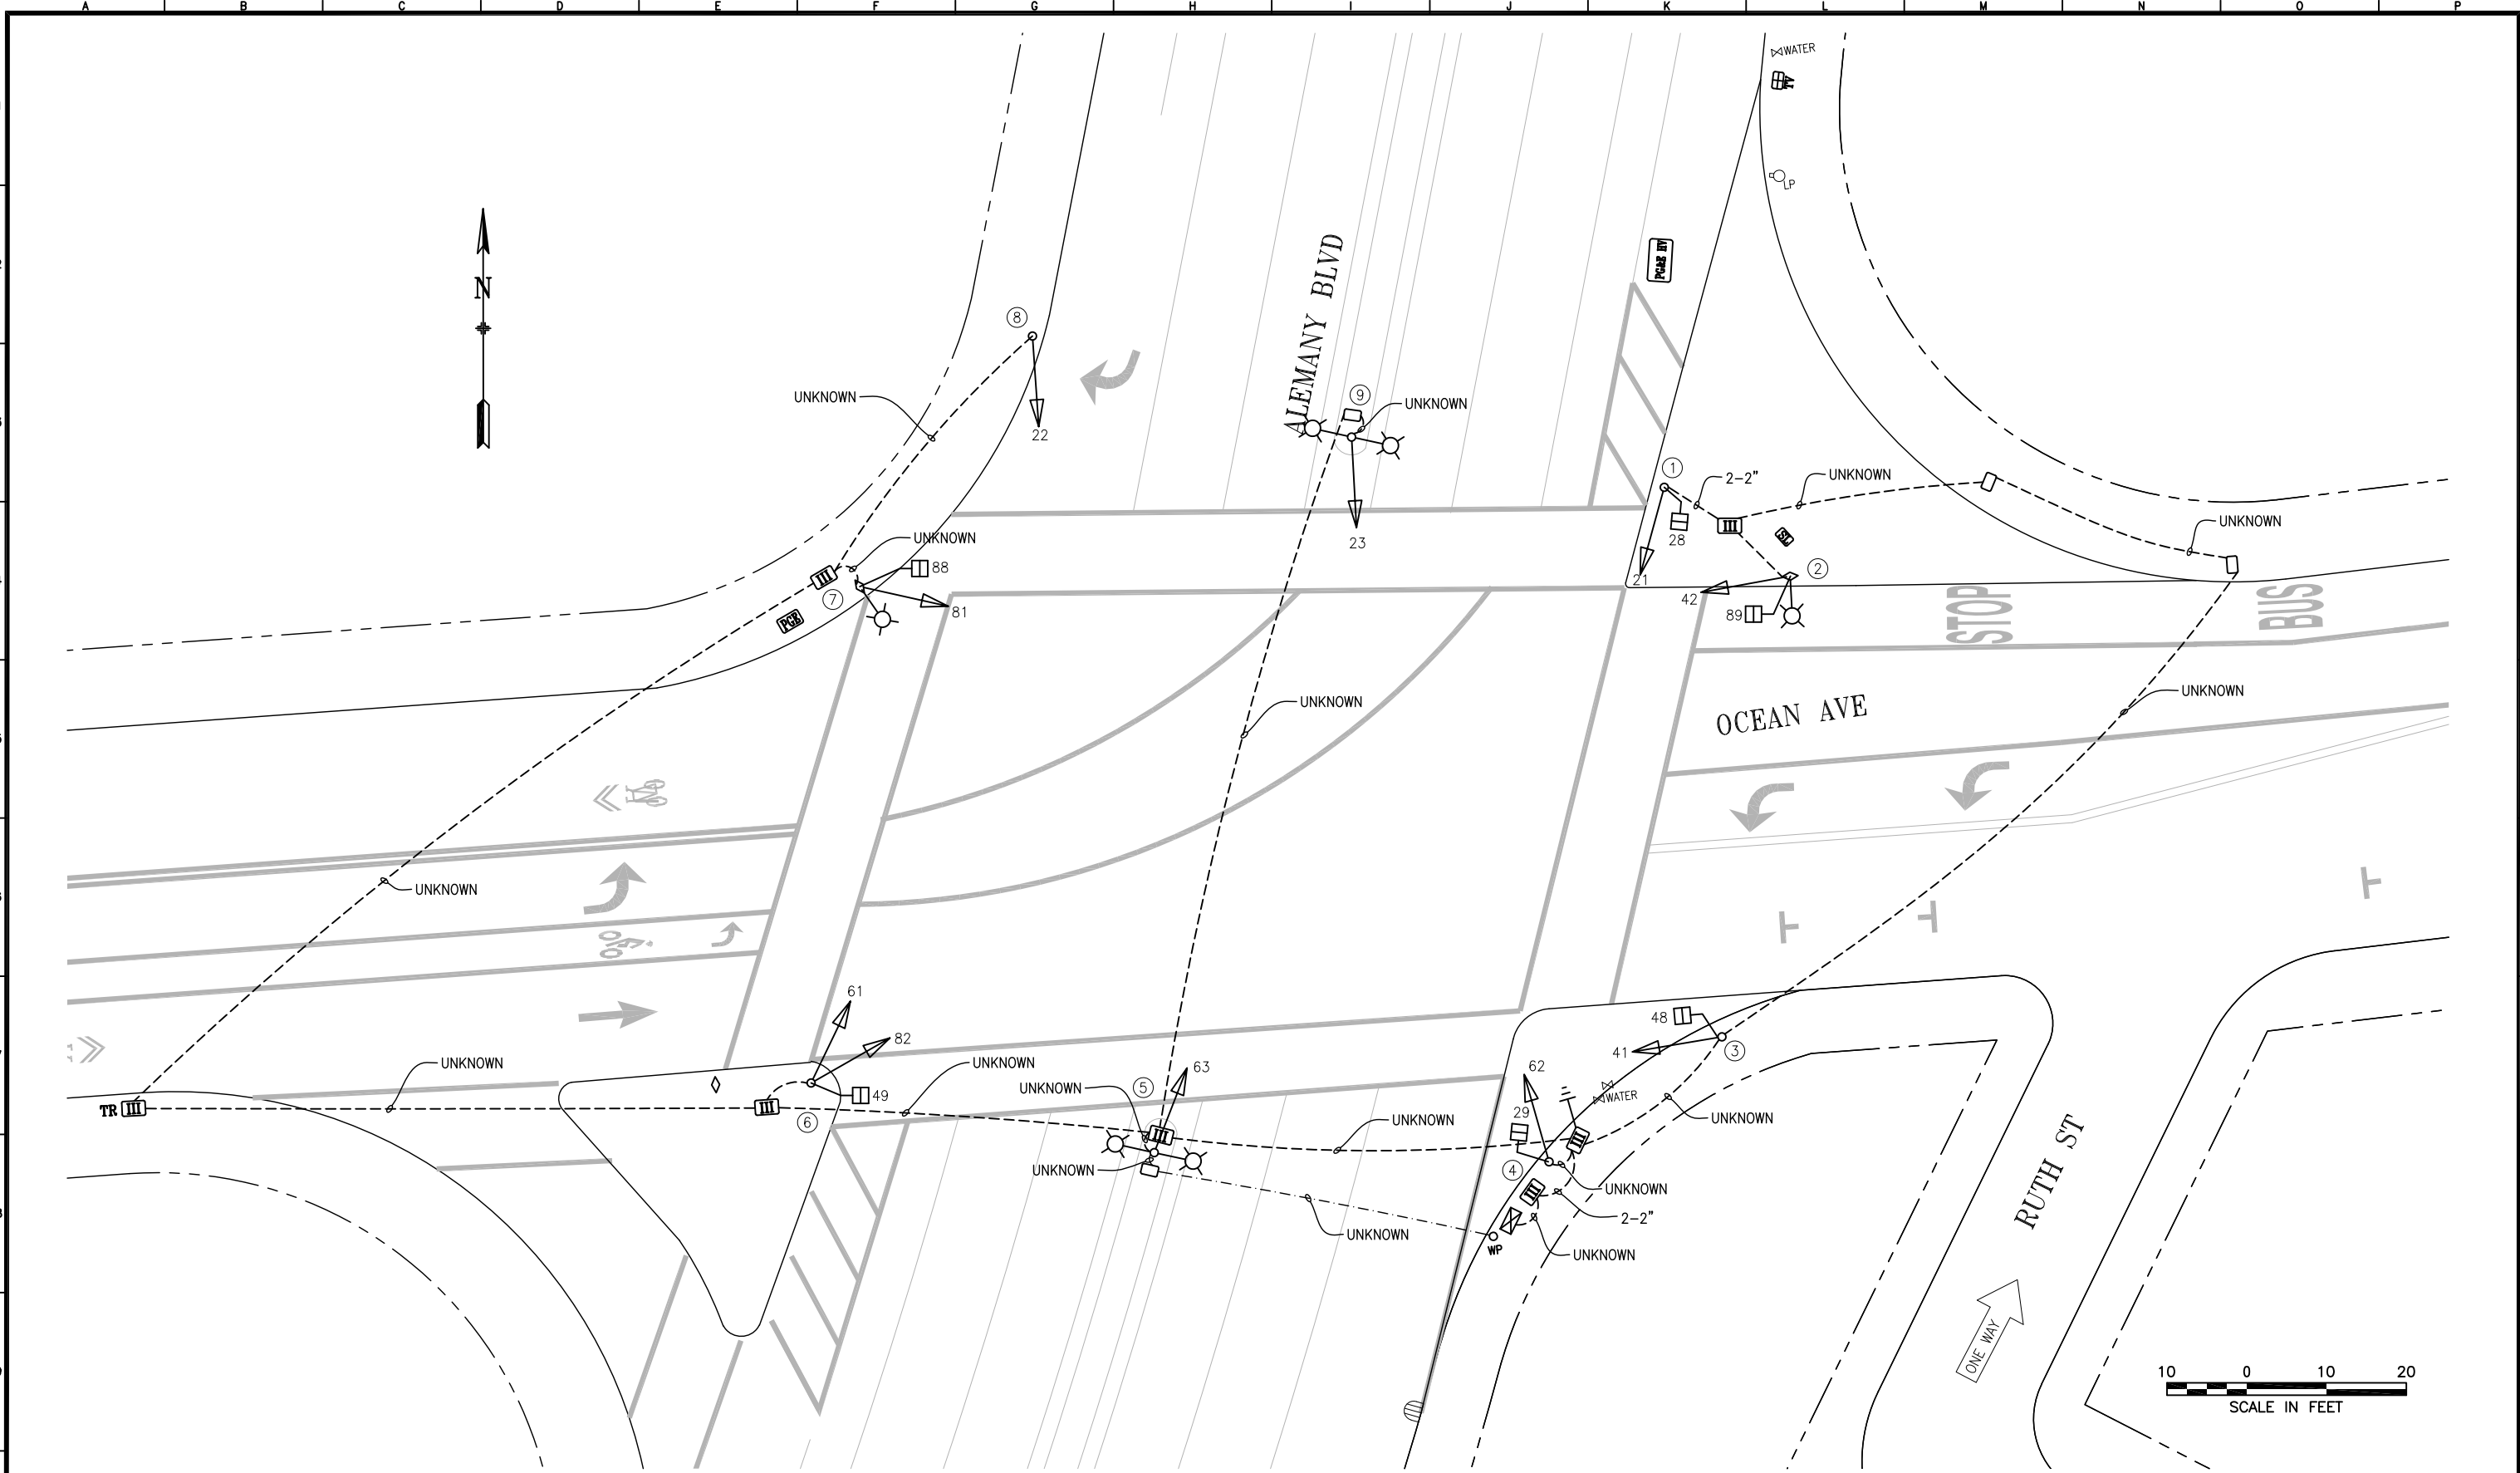

NO.	DATE	DESCRIPTION	BY	APPROVED
0	11/2/21	CONVERTED FROM MSID. RELOCATE SIGNAL 42 PER SRC 2021-163.	C. LEUNG	M. VELASCO
TABLE OF REVISIONS CHECKOUT DRAWING THROUGH THE SID CUSTODIAN FOR THE LATEST REVISION				



SFMTA

DRAWN BY: C. LEUNG	DATE: 11/2021
CHECKED BY: M. VELASCO	DATE: 11/2021

SCALE AS SHOWN	TRAFFIC SIGNAL INVENTORY DIAGRAM ALEMANY BLVD & OCEAN AVE	CNN NO: 21755000
SHEET OF SHEETS 1 OF 2		REV NO: 0

1	A	B	C	D	E	F	G	H	I	J	K	L	M	N	O	P	1
2																	2
3																	3
4																	4
5																	5
6																	6
7																	7
8																	8
9																	9