


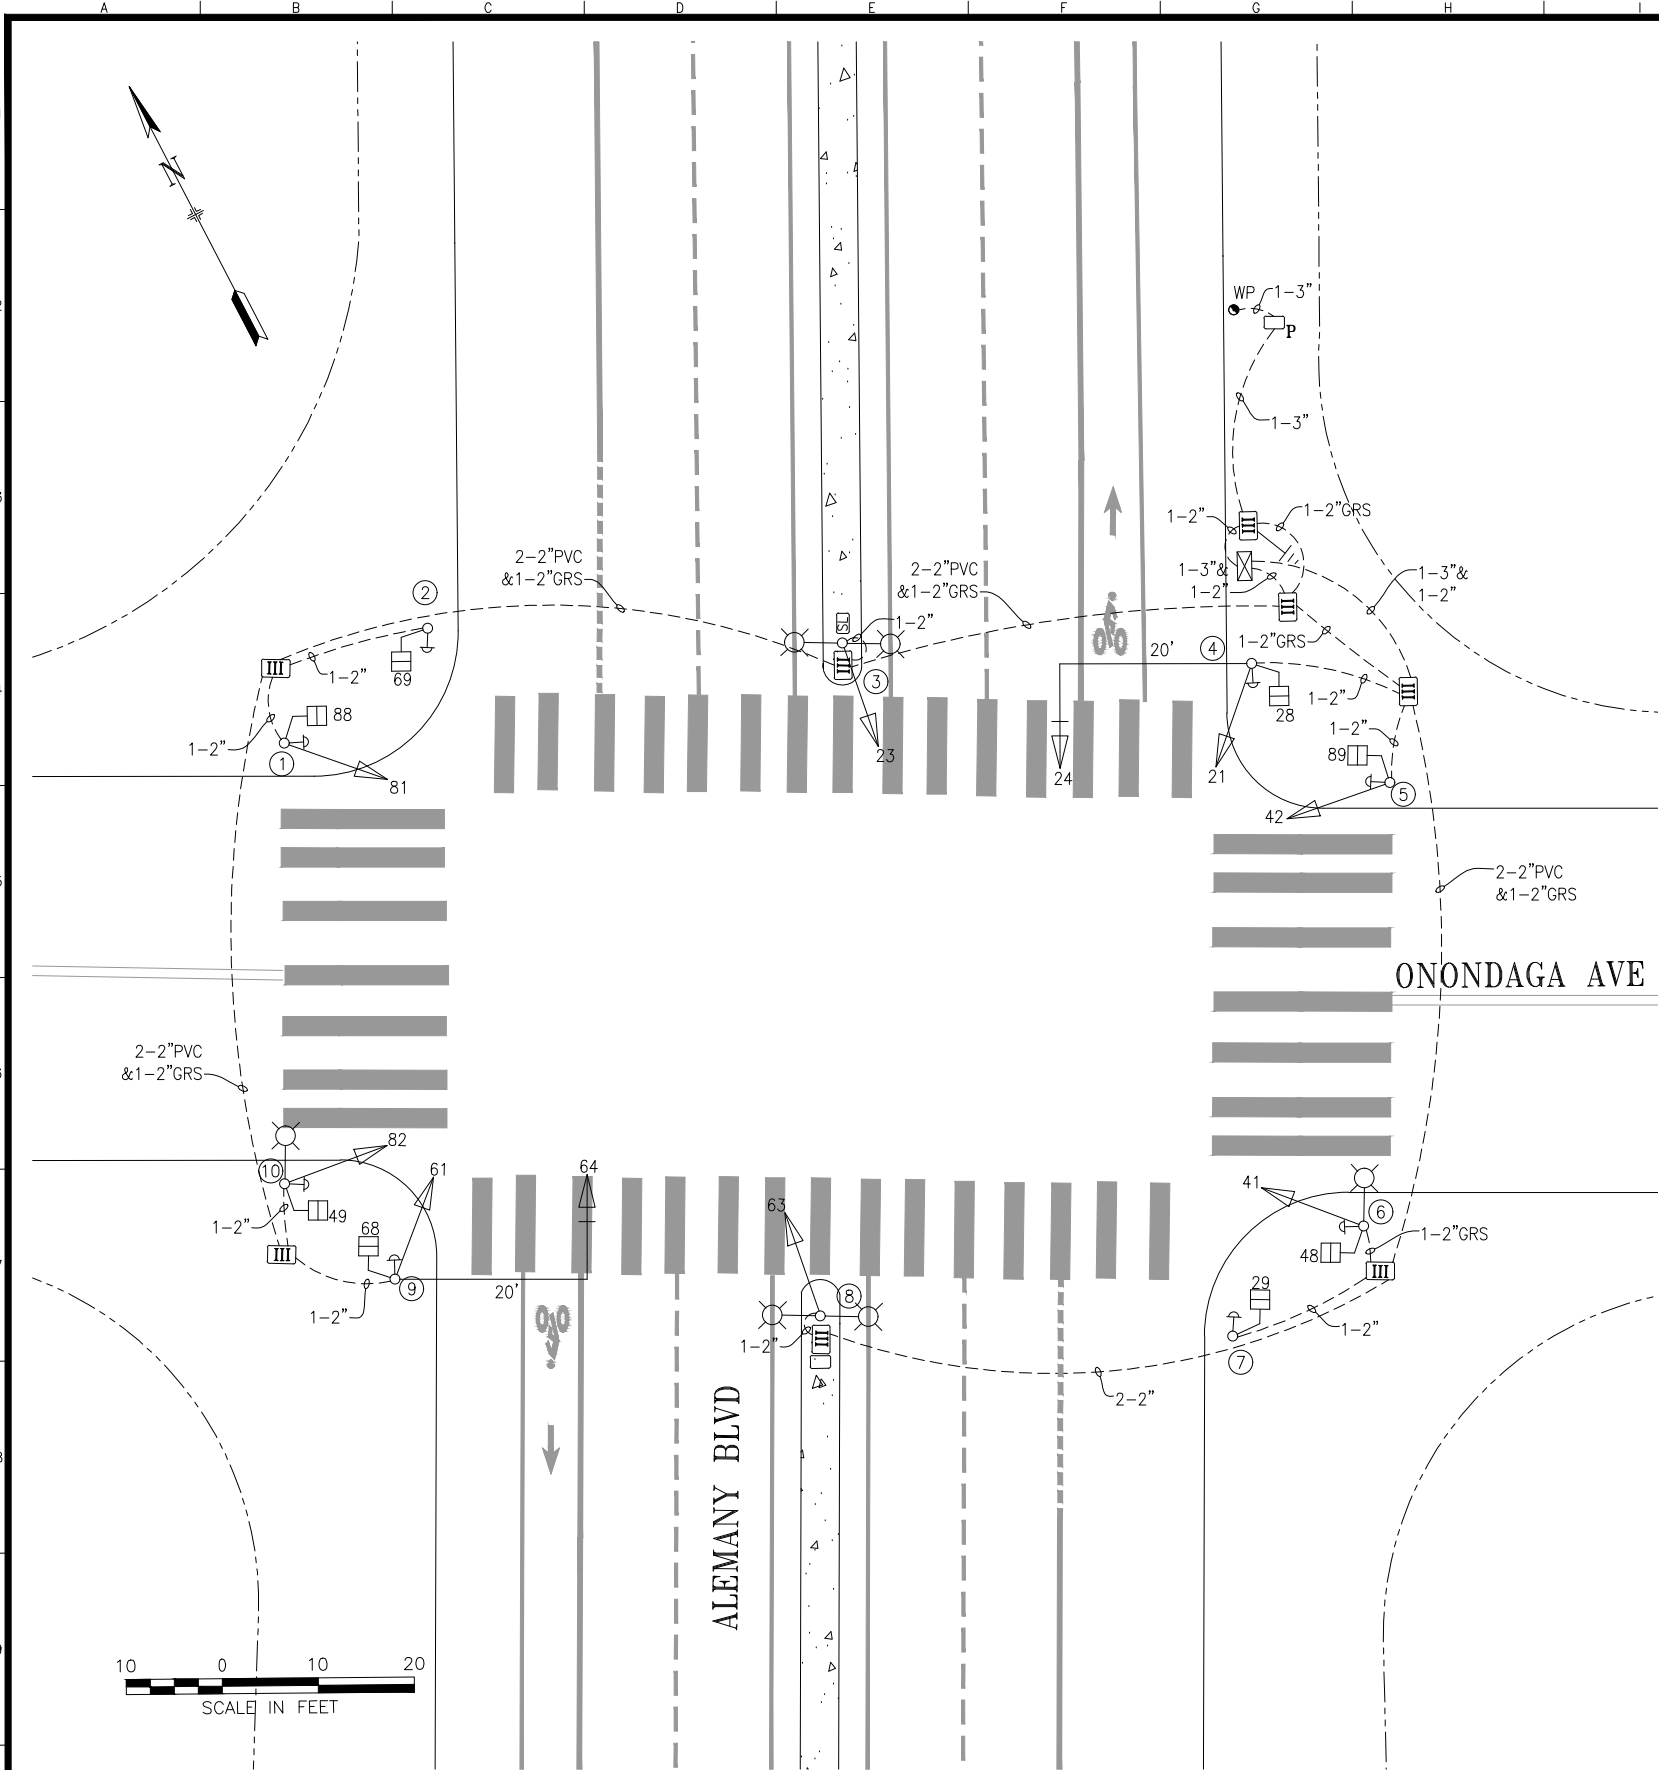

POLE AND EQUIPMENT SCHEDULE											
POLE No.	TYPE OF POLE	LUMINAIRE VOLTAGE/ WATTAGE	VEHICLE SIGNAL					PEDESTRIAN SIGNAL			REMARKS
			No.	TYPE	MOUNTING	VISORS	LOUVERS	No.	TYPE	MOUNTING	
①	1-A (10')		81	3S12"	TV-1-T	T		88	1S-COUNT	SP-1	APS-4W
②	1-A (7')							69	1S-COUNT	TP-1	APS-4W
③	EX MARBELITE SL W/ DUAL LUMINAIRE ARMS		23	3S12"	SV-1	T					
④	16-2-100 WITH 20' MAST ARM		21 24	3S12" 3S12"	SV-1-T MAS	T T		28	1S-COUNT	SP-1	APS-4W BACKPLATE
⑤	1-A (10')		42	3S12"	TV-1-T	T		89	1S-COUNT	SP-1	APS-4W
⑥	CITY STANDARD STREET LIGHT	HPS 120V/150W	41	3S12"	SV-1-T	T		48	1S-COUNT	SP-1	APS-4W
⑦	1-A (7')							29	1S-COUNT	TP-1	APS-4W
⑧	EX MARBELITE SL W/ DUAL LUMINAIRE ARMS		63	3S12"	SV-1	T					
⑨	16-2-100 WITH 20' MAST ARM		61 64	3S12" 3S12"	SV-1-T MAS	T T		68	1S-COUNT	SP-1	APS-4W BACKPLATE
⑩	CITY STANDARD STREET LIGHT	HPS 120V/150W	82	3S12"	SV-1-T	T		49	1S-COUNT	SP-1	APS-4W

NO.	DATE	DESCRIPTION	BY	APP.
1	4/16/18	INSTALL APS PER SRC 2017-229	JH	GD
0	3/8/17	UPGRADE BY 2234; CONVERTED FROM CONTRACT PLANS	JH	GD

TABLE OF REVISIONS
CHECK WITH TRACING TO SEE IF YOU HAVE LATEST REVISION

REFERENCE INFORMATION & FILE NO. OF SURVEYS
--



SAN FRANCISCO MUNICIPAL TRANSPORTATION AGENCY
CITY AND COUNTY OF SAN FRANCISCO

DRAWN:	DATE:
JH	1/2018
CHECKED:	DATE:
GD	1/2018

SCALE:
AS SHOWN
SHEET OF SHEETS
01 OF 01

TRAFFIC SIGNAL INVENTORY DIAGRAM
ALEMANY BLVD AND ONONDAGA AVE

CNN NO.
21750000
REV NO.
1