


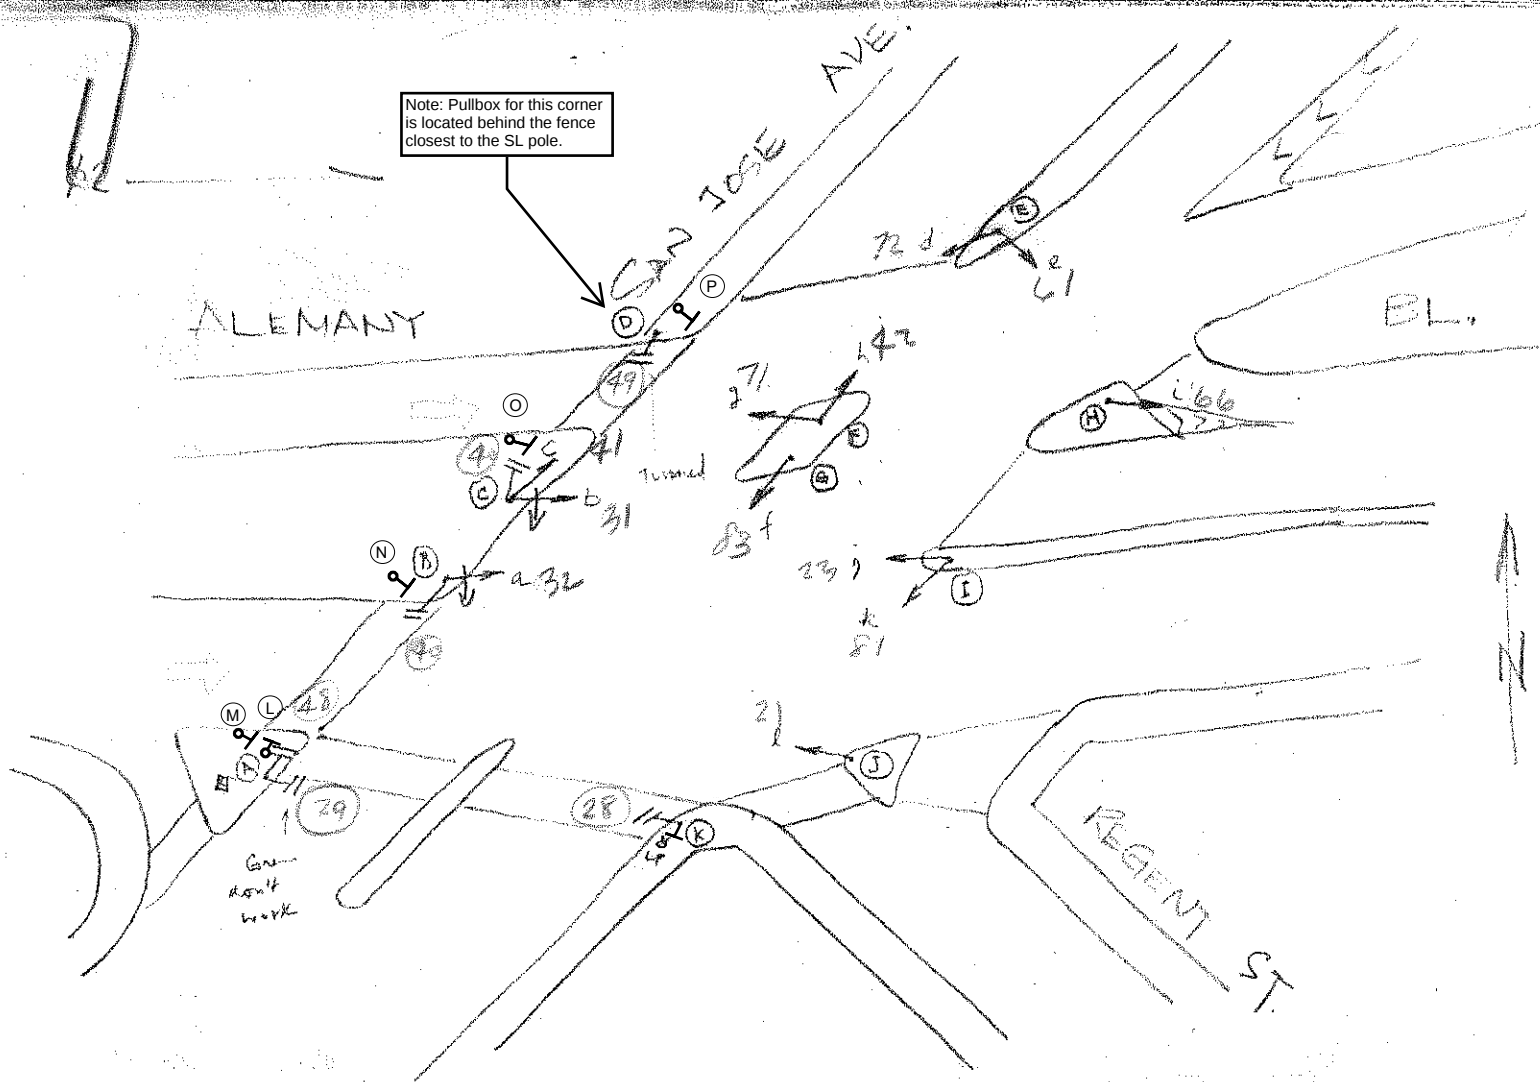

4/5/2022

POLE	FUNC.	MATH	SIGNAL NO.	MAKE	NO. OF SECT.	SIZE	VISOR	B.P. OR LOUVERS	MOUN'T	PED SIGNAL NO.	LEGEND	MESSAGE		MAKE	MOUN'T
												ELEMENT	COLOR		
A	S	C	a	EC	3	12"LA	T 12"	NO	S	28	W/PW	GRD	B/R	ED	T
B	L	C	b	EC	3	12"LA	T 12"	NO	T	29	W/PW	GRD	G/R	ED	S
C	S	C	c	EC	3	12"	T 12"	NO	T	48	W/PW	GRD	G/R	ED	S
D	L	C	d	EC	3	12"	T 12"	NO	S	40	W/PW	GRD	G/R	ED	S
E	L	C	e	EC	3	12"	T 12"	NO	S	40	W/PW	GRD	G/R	ED	S
F	S	S	f	EC	3	12"	T 12"	NO	T	49	W/PW	GRD	G/R	ED	S
G	S	S	g	EC	3	12"	T 12"	NO	T						
H	S	C	h	EC	3	12"	T 12"	NO	T						
I	L	C	i	EC	3	12"	T 12"	NO	T						
J	S	C	j	EC	3	12"	T 12"	VERTICAL LOUVERS	S						
K	S	C	k	EC	3	12"	T 12"	NO	S						
			l	GA	3	12"	T 12"	NO	T						
L,M,N,O,P: PPB Post															

CONTROLLER CABINET SIZE : DEBINARY BASE CABINET : YES

COMMENTS : Per SRC 2021-342 & Caltrans APS Project - Add 5 PPB Posts and new APS
- D. Yeung 4-5-2022