



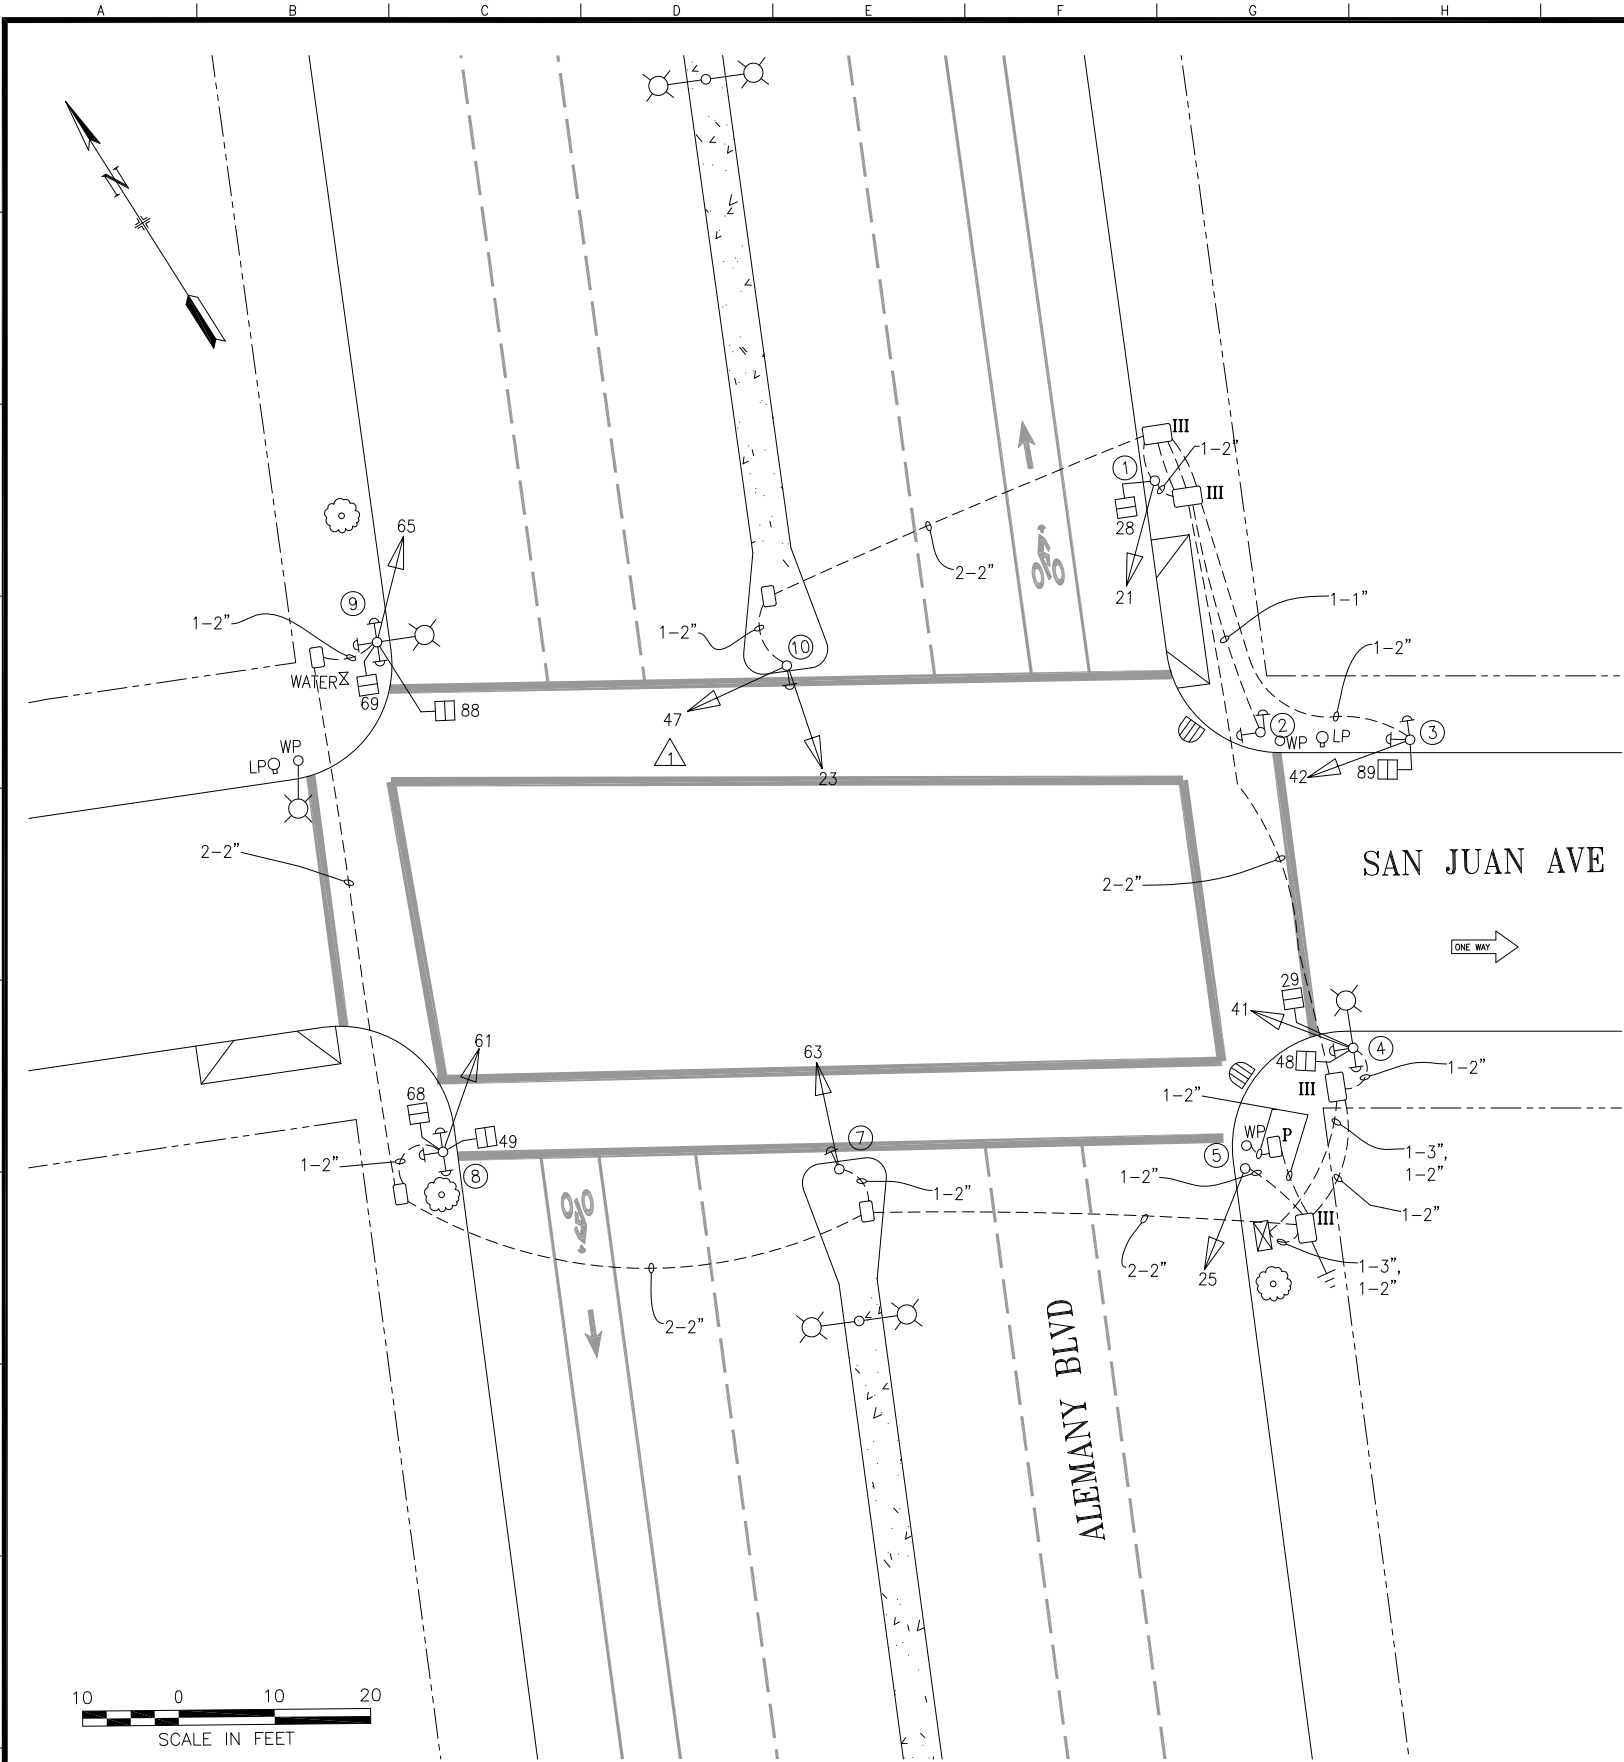

POLE AND EQUIPMENT SCHEDULE											
POLE No.	TYPE OF POLE	LUMINAIRE VOLTAGE/WATTAGE	VEHICLE SIGNAL					PEDESTRIAN SIGNAL			REMARKS
			No.	TYPE	MOUNTING	VISORS	LOUVERS	No.	TYPE	MOUNTING	
①	1-A (10')		21	3S12"	TV-1-T	T		28	1S-COUNT	SP-1	
②	PPB POLE										PPB PPB
③	1-A (13')		42	3S12"	TV-1-T	T		89	1S-COUNT	SP-1 (22")	PPB PPB
④	CITY STANDARD STREET LIGHT	120V 150W	41	3S12"	SV-1-T	T		29 48	1S-COUNT 1S-COUNT	SP-1-SF (12") SP-1 (22")	PPB PPB VEH SIGNAL MOUNTED @ 13'
⑤	1-A (10')		25	3S12"	TV-1-T	T					
⑦	1-A (10')		63	3S12"	TV-1-T	T					PPB
⑧	1-A (10')		61	3S12"	TV-1-T	T		49 68	1S-COUNT 1S-COUNT	SP-1-SF (12") SP-1 (22")	PPB PPB PPB
⑨	CITY STANDARD STREET LIGHT	120V 150W	65	3S12"	SV-1-T	T		69 88	1S-COUNT 1S-COUNT	SP-1 (22") SP-1-SF (12")	PPB PPB PPB
⑩	1-A (10')		23 47	3S12" 3S12"	TV-2-T	T T					PPB

PHASE DIAGRAM

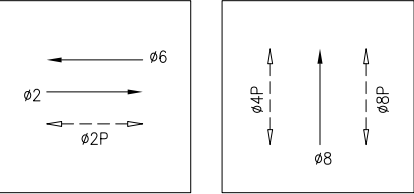

PHASE SEQUENCE
(STEADY DEMAND)

G		Y	R			ALEMANY BLVD (NB & SB) – 02 & 06	
R			G		Y	R	SAN JUAN AVE (EB) – 04
WM		FRH	RH			PED XING SAN JUAN AVE (ES & WS) – 02P & 06P	
RH			WM		FRH	RH	PED XING ALEMANY BLVD (SS & NS) – 04P & 08P

TABLE OF REVISIONS		CHECK WITH TRACING TO SEE IF YOU HAVE LATEST REVISION	
NO.	DATE	DESCRIPTION	BY APP.
Δ	02/04/14	INSTALL 3S12" SIGNAL 47 ON POLE 10 THROUGH SRC 2013-129	GH GD
0	04/20/12	NEW SIGNAL ACTIVATED THROUGH CT 60	GH GD

REFERENCE INFORMATION
& FILE NO. OF SURVEYS



SAN FRANCISCO MUNICIPAL TRANSPORTATION AGENCY
CITY AND COUNTY OF SAN FRANCISCO

DESIGNED:	DATE:
GD	12/2013
DRAWN:	DATE:
GD	12/2013
CHECKED:	DATE:
MV	12/2013

SCALE:

AS SHOWN

SHEET OF SHEETS

1 OF 1

TRAFFIC SIGNAL INVENTORY DIAGRAM

ALEMANY BLVD AND SAN JUAN AVE

CNN NO.

21740000

REV NO.