


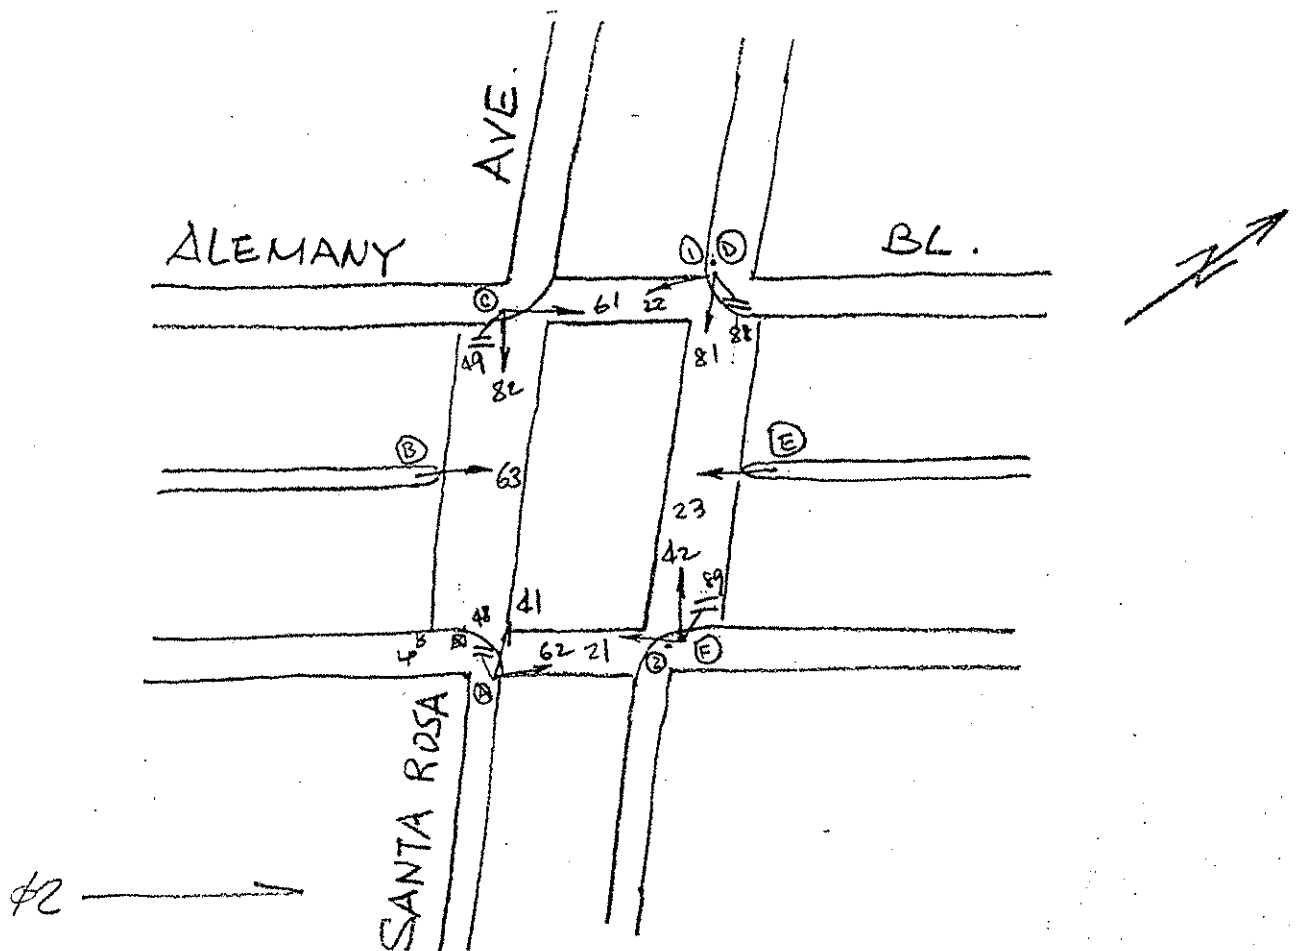

5-12-90

POLE	FUNC.	MAT'L	SIGNAL NO.	MAKE	NO. OF SECT.	SIZE	VISOR	B.P. OR LOUVERS	MOUNT	PED SIGNAL NO.	LEGEND	MESSAGE		MAKE	MOUNT
												ELEMENT	COLOR		
A	S	C	62	GA	3	8"	FL 12"	NO	T	48	I	15-1	W/OR	ICC	S
B	L	C	41	GA	3	8"	FL 12"	NO	T	49	I	15-1	W/OR	ICC	S
C	S	C	63	EL	3	8"	FL 8"	NO	S	88	I	15-1	W/OR	ICC	S
D	S	C	82	GA	3	8"	FL 12"	NO	T	89	I	15-1	W/OR	ICC	S
E	L	C	61	GA	3	8"	FL 12"	NO	T						
F	S	C	22	GA	3	8"	FL 12"	NO	T						
			81	GA	3	8"	FL 12"	NO	T						
1	U	W	23	EL	3	8"	FL 8"	NO	S						
2	U	W	42	GA	3	8"	FL 12"	NO	T						
			21	GA	3	8"	FL 12"	NO	T						

CONTROLLER CABINET SIZE : ORDINARY BASE CABINET : NO

COMMENTS : Replaced Ped Signals with ICC