


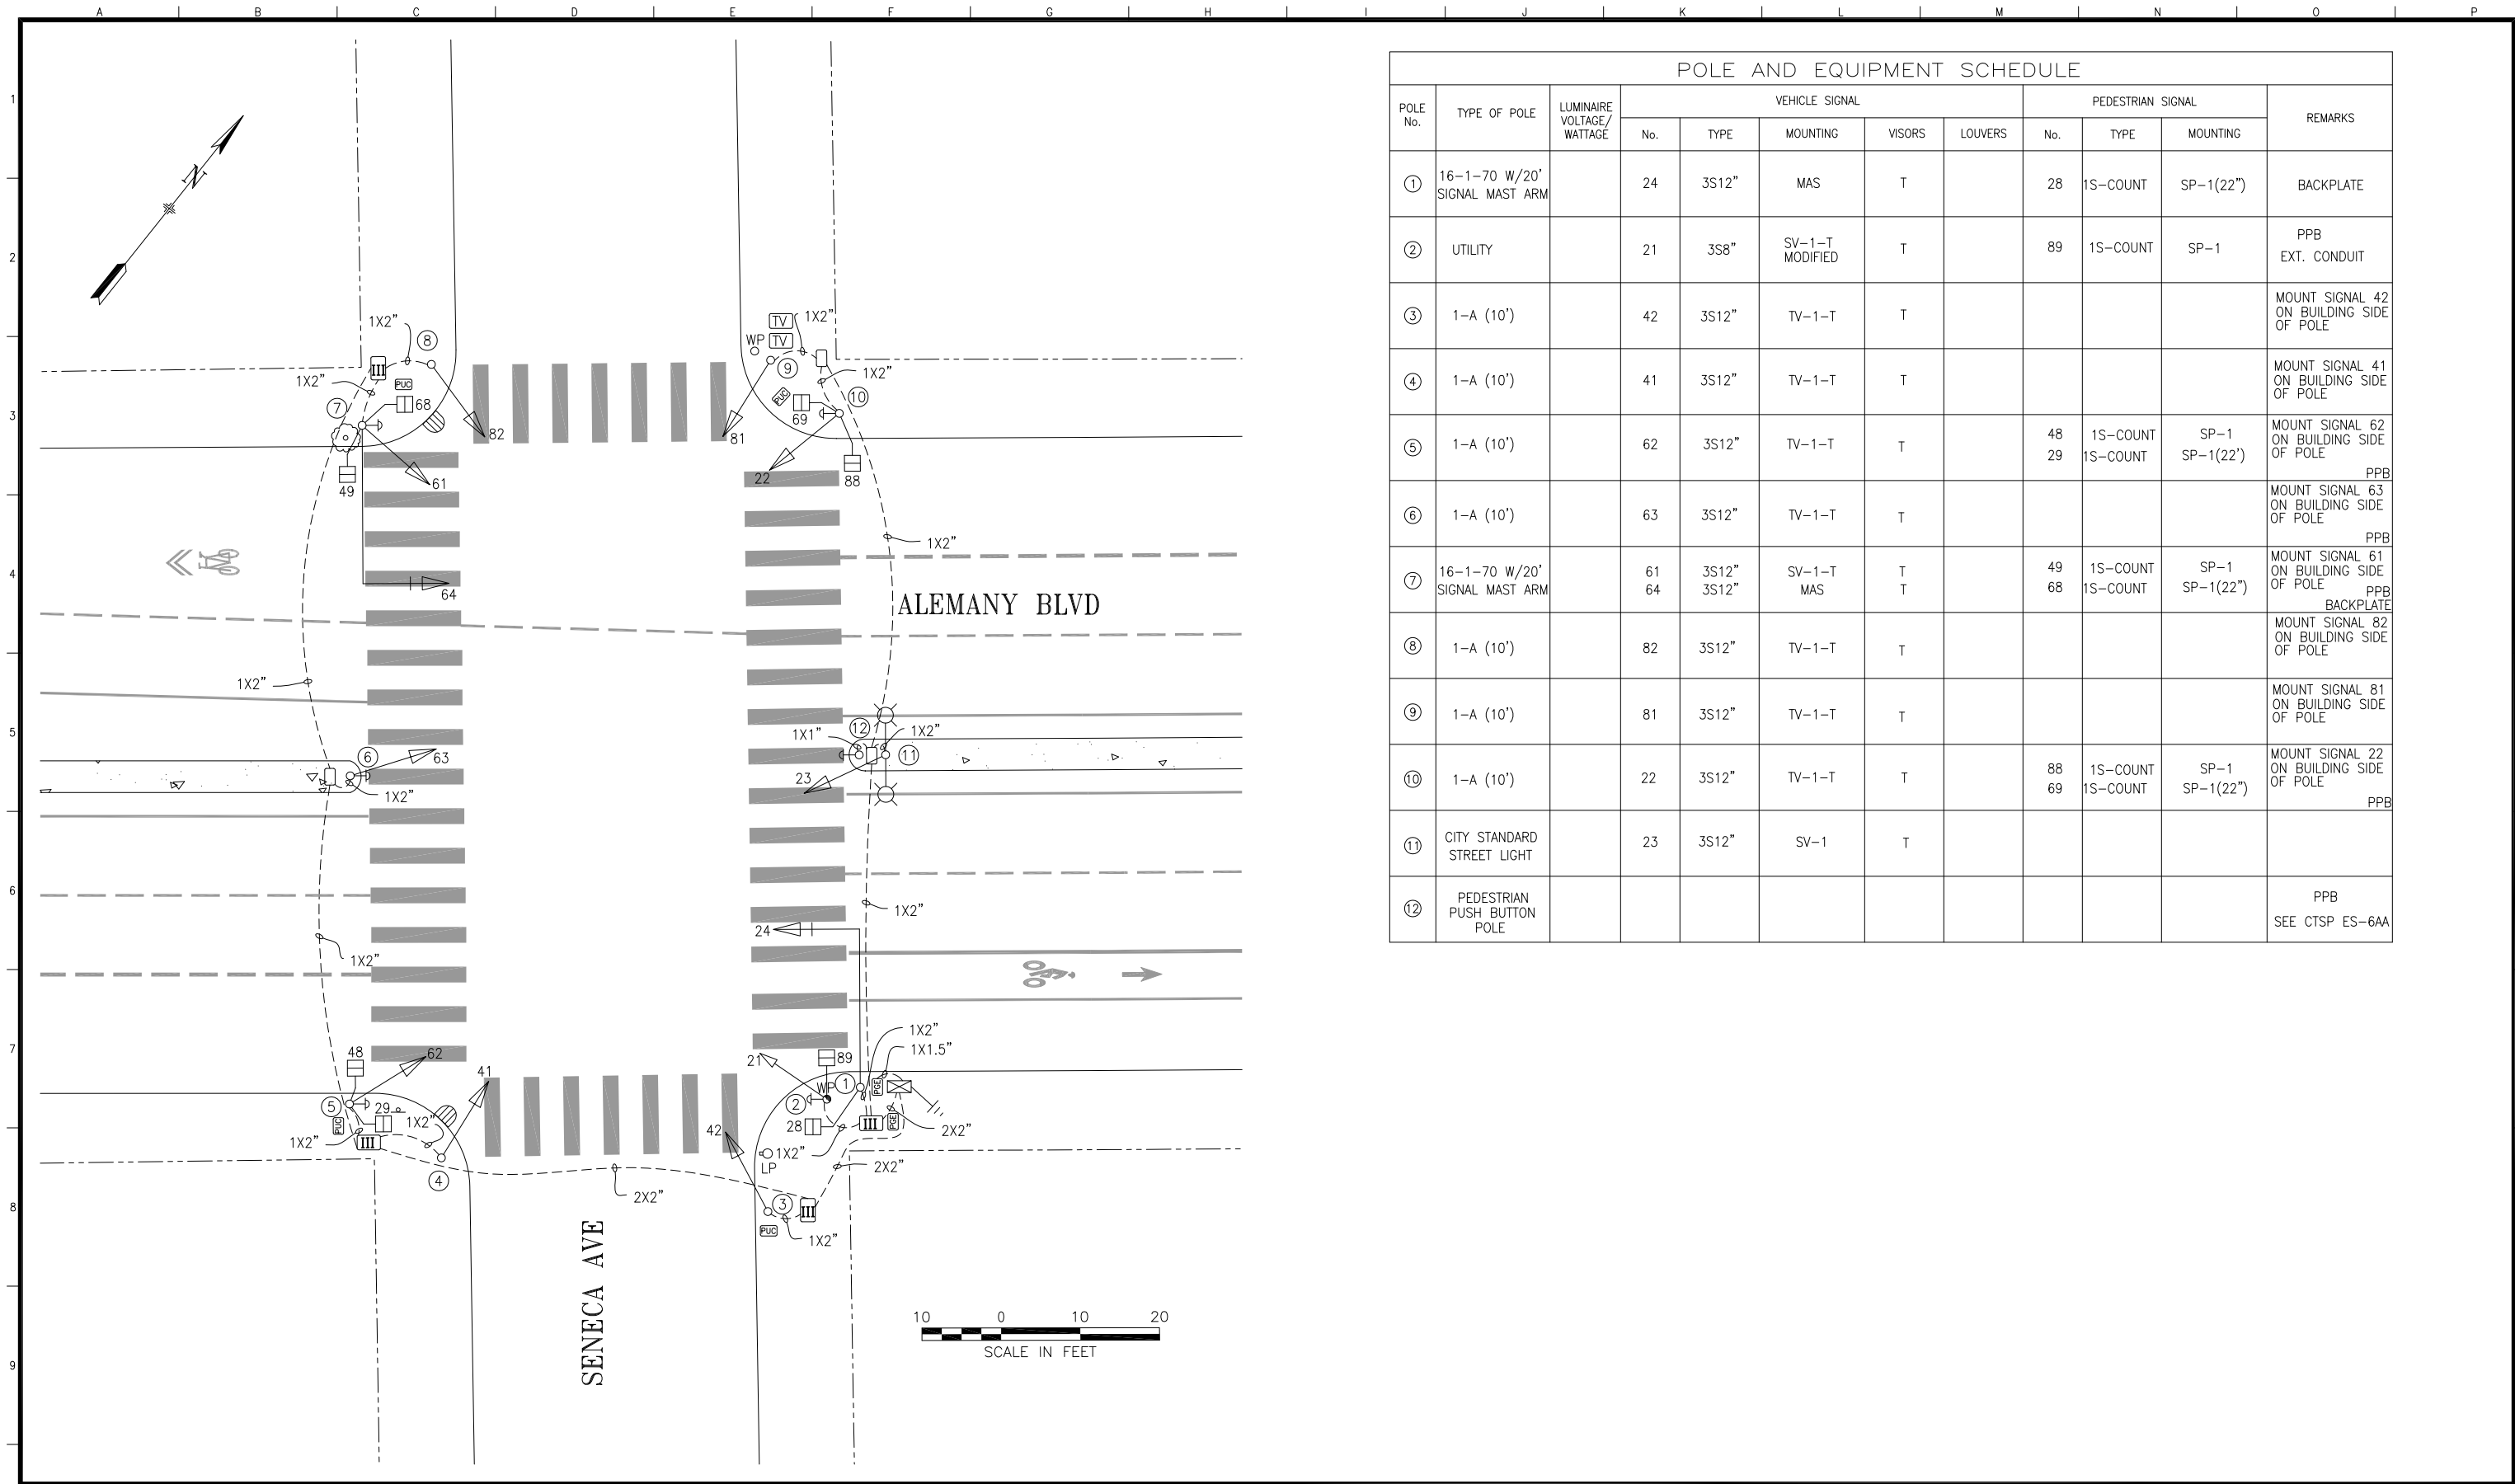

POLE AND EQUIPMENT SCHEDULE											
POLE No.	TYPE OF POLE	LUMINAIRE VOLTAGE/ WATTAGE	VEHICLE SIGNAL					PEDESTRIAN SIGNAL			REMARKS
			No.	TYPE	MOUNTING	VISORS	LOUVERS	No.	TYPE	MOUNTING	
①	16-1-70 W/20' SIGNAL MAST ARM		24	3S12"	MAS	T		28	1S-COUNT	SP-1(22")	BACKPLATE
②	UTILITY		21	3S8"	SV-1-T MODIFIED	T		89	1S-COUNT	SP-1	PPB EXT. CONDUIT
③	1-A (10')		42	3S12"	TV-1-T	T					MOUNT SIGNAL 42 ON BUILDING SIDE OF POLE
④	1-A (10')		41	3S12"	TV-1-T	T					MOUNT SIGNAL 41 ON BUILDING SIDE OF POLE
⑤	1-A (10')		62	3S12"	TV-1-T	T		48 29	1S-COUNT 1S-COUNT	SP-1 SP-1(22')	MOUNT SIGNAL 62 ON BUILDING SIDE OF POLE PPB
⑥	1-A (10')		63	3S12"	TV-1-T	T					MOUNT SIGNAL 63 ON BUILDING SIDE OF POLE PPB
⑦	16-1-70 W/20' SIGNAL MAST ARM		61 64	3S12" 3S12"	SV-1-T MAS	T T		49 68	1S-COUNT 1S-COUNT	SP-1 SP-1(22")	MOUNT SIGNAL 61 ON BUILDING SIDE OF POLE PPB BACKPLATE
⑧	1-A (10')		82	3S12"	TV-1-T	T					MOUNT SIGNAL 82 ON BUILDING SIDE OF POLE
⑨	1-A (10')		81	3S12"	TV-1-T	T					MOUNT SIGNAL 81 ON BUILDING SIDE OF POLE
⑩	1-A (10')		22	3S12"	TV-1-T	T		88 69	1S-COUNT 1S-COUNT	SP-1 SP-1(22")	MOUNT SIGNAL 22 ON BUILDING SIDE OF POLE PPB
⑪	CITY STANDARD STREET LIGHT		23	3S12"	SV-1	T					
⑫	PEDESTRIAN PUSH BUTTON POLE										PPB SEE CTSP ES-6AA

TABLE OF REVISIONS				
NO.	DATE	DESCRIPTION	BY	APP.
2	8/4/15	2543J PUNCHLIST WALKTHROUGH; ADD PCS AND UPGRADE TO 12"	DYeung	Melasco
1	03/1996	NEW TRAFFIC SIGNALS CT 47	CXL	DVS

CHECK WITH TRACING TO SEE IF YOU HAVE LATEST REVISION

REFERENCE INFORMATION & FILE NO. OF SURVEYS



SAN FRANCISCO MUNICIPAL TRANSPORTATION AGENCY

CITY AND COUNTY OF SAN FRANCISCO

DRAWN:	DATE:
AScales	11/2015
CHECKED:	DATE:
MYelasco	11/2015

SCALE:
AS SHOWN
SHEET OF SHEETS
1 OF 1

TRAFFIC SIGNAL INVENTORY DIAGRAM
ALEMANY BOULEVARD AND SENECA AVENUE

CNN NO.
22053000
REV NO.
2