


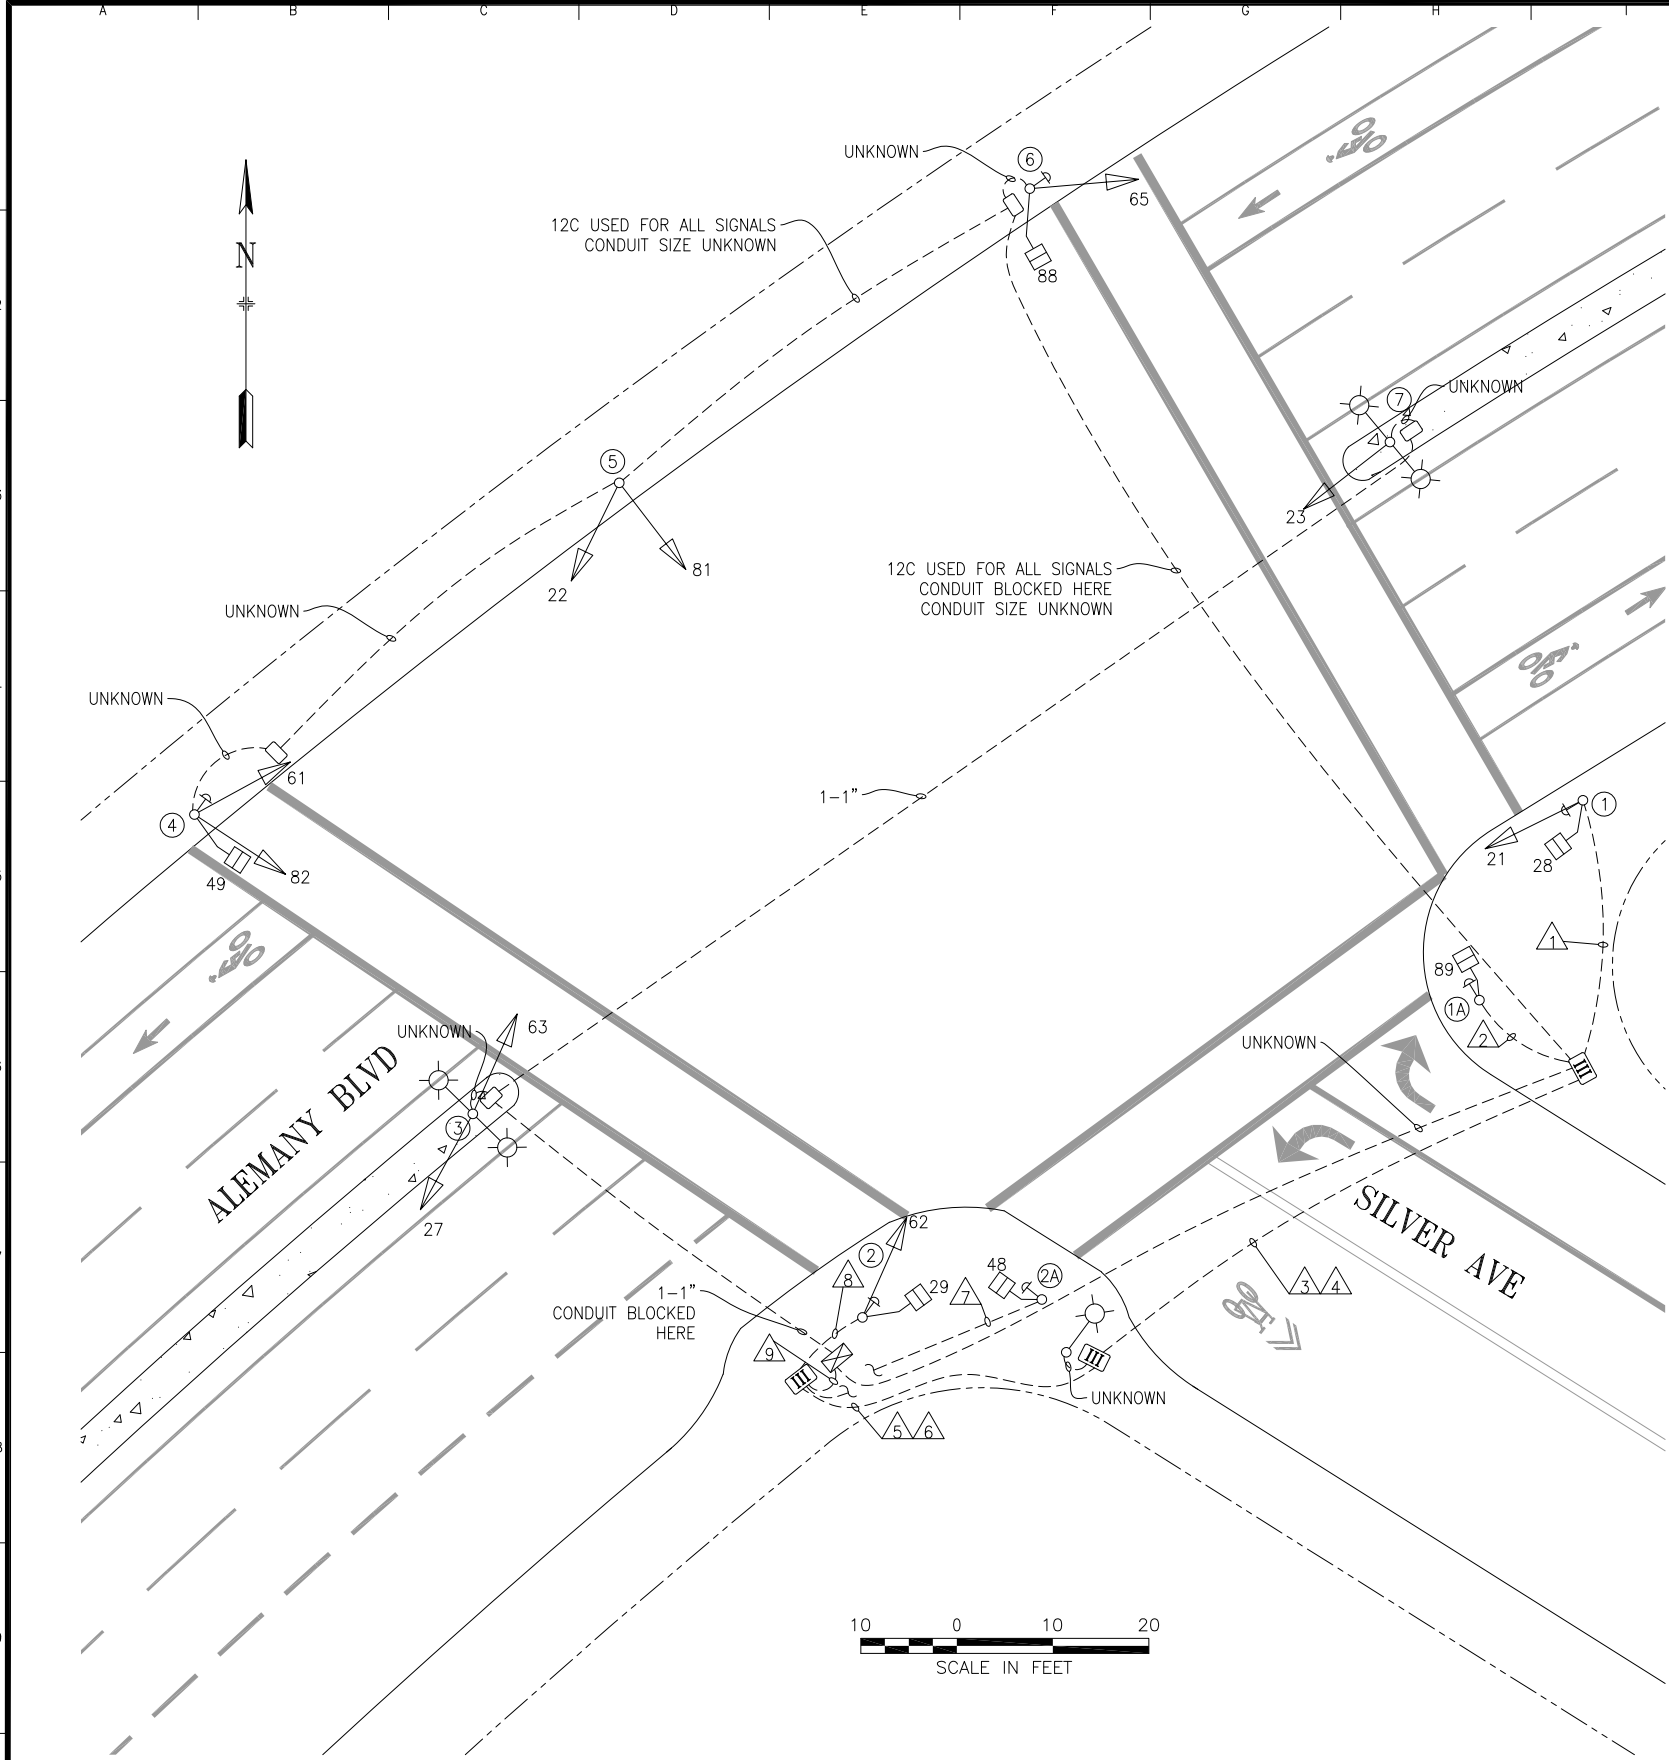

| POLE AND EQUIPMENT SCHEDULE |                           |                            |                |                |              |        |                                |                   |          |          |         |
|-----------------------------|---------------------------|----------------------------|----------------|----------------|--------------|--------|--------------------------------|-------------------|----------|----------|---------|
| POLE No.                    | TYPE OF POLE              | LUMINAIRE VOLTAGE/ WATTAGE | VEHICLE SIGNAL |                |              |        |                                | PEDESTRIAN SIGNAL |          |          | REMARKS |
|                             |                           |                            | No.            | TYPE           | MOUNTING     | VISORS | LOUVERS                        | No.               | TYPE     | MOUNTING |         |
| ①                           | 1-A (10')                 |                            | 21             | 3S12"          | TV-1-T       | T      |                                | 28                | 1S-COUNT | SP-1     | APS-4W  |
| ①A                          | 1-A (7')                  |                            |                |                |              |        |                                | 89                | 1S-COUNT | TP-1     | APS-4W  |
| ②                           | 1-A (10')                 |                            | 62             | 3S12"          | TV-1-T       | T      |                                | 29                | 1S-COUNT | SP-1     | APS-4W  |
| ②A                          | 1-A (7')                  |                            |                |                |              |        |                                | 48                | 1S-COUNT | TP-1     | APS-4W  |
| ③                           | MARBELITE STREET LIGHT    |                            | 27<br>63       | 3S12"<br>3S12" | SV-1<br>SV-1 | T<br>T | VERT LOUVER 27 GREEN BALL ONLY |                   |          |          |         |
| ④                           | MARBELITE(10')            |                            | 61<br>82       | 3S12"<br>3S12" | TV-2-T       | T<br>T |                                | 49                | 1S-COUNT | SP-1     | APS-4W  |
| ⑤                           | PEDESTAL BASE POLE (10')  |                            | 22<br>81       | 3S12"<br>3S12" | TV-2-T       | T<br>T |                                |                   |          |          |         |
| ⑥                           | 1-A(10') ON ADAPTER PLATE |                            | 65             | 3S12"          | TV-1-T       | T      |                                | 88                | 1S-COUNT | SP-1     | APS-4W  |
| ⑦                           | MARBELITE STREET LIGHT    |                            | 23             | 3S12"          | SV-1         | T      |                                |                   |          |          |         |

| CONDUIT AND WIRING SCHEDULE |                            |   |   |    |    |    |    |   |   |     |
|-----------------------------|----------------------------|---|---|----|----|----|----|---|---|-----|
| CONDUIT RUN NUMBER          |                            | 1 | 2 | 3  | 4  | 5  | 6  | 7 | 8 | 9   |
| CONDUIT SIZE (INCH)         |                            | 2 | 2 | 2  | 2  | 2  | 2  | 2 | 2 | UNK |
|                             |                            |   |   |    | SP |    | SP |   |   |     |
| NOTES                       |                            |   |   |    |    |    |    |   |   |     |
|                             | VEHICLE SIGNAL 21          | 3 |   | 3  |    | 3  |    |   |   | 3   |
|                             | PED SIGNAL 28              | 2 |   | 2  |    | 2  |    |   |   | 2   |
|                             | PED SIGNAL 89              |   | 2 | 2  |    | 2  |    |   |   | 2   |
|                             | PED SIGNAL 48              |   |   |    |    |    |    | 2 |   | 2   |
|                             | VEHICLE SIGNAL 62          |   |   |    |    |    |    |   | 3 | 3   |
|                             | PED SIGNAL 29              |   |   |    |    |    |    |   | 2 | 2   |
|                             |                            |   |   |    |    |    |    |   |   |     |
|                             | #14 NEUTRAL                | 2 | 1 |    |    |    |    | 1 | 2 |     |
|                             | #14 SPARE                  |   |   | 3  |    | 3  |    |   |   | 3   |
|                             | TOTAL #14 WIRES            | 7 | 3 | 10 |    | 10 |    | 3 | 7 | 17  |
|                             | #10 WIRES NEUTRAL          |   |   | 1  |    | 1  |    |   |   | 2   |
|                             | #10 WIRES STREET LIGHT     |   |   |    |    |    |    |   |   |     |
|                             | #8 WIRES STREET LIGHT      |   |   |    |    |    |    |   |   |     |
|                             | #8 WIRES (120 V SERVICE)   |   |   |    |    |    |    |   |   |     |
|                             | #6 BSCW (SEE SHEET NOTE 1) |   |   |    |    |    |    |   |   |     |
|                             | INTERCONNECT 12C CABLE     |   |   |    |    |    |    |   |   |     |

| NO.                                                                                      | DATE     | DESCRIPTION                                              | BY     | APPROVED |
|------------------------------------------------------------------------------------------|----------|----------------------------------------------------------|--------|----------|
| 4                                                                                        | 8/25/20  | SPLIT SIGNALS ON POLES 1 & 2 ONTO NEW POLES PER 10032496 | DYeung | GDeLeon  |
| 3                                                                                        | 11/16/19 | ADD VERT LOUVER TO 27 G BALL. SRC 2019-179               | DYeung | GDeLeon  |
| 2                                                                                        | 8/1/17   | ADD 27 AND 65. UPGRADE ALL TO 12-INCH. SRC2017-181       | DY     | GD       |
| 1                                                                                        | 1/21/16  | ADDED PCS CROSSING SILVER (#2P)                          | JH     | MV       |
| 0                                                                                        | 10/22/15 | NEW SID PER 2067J PUNCH LIST INSPECTION                  | JH     | MV       |
| NO.                                                                                      | DATE     | DESCRIPTION                                              | BY     | APPROVED |
| TABLE OF REVISIONS<br>CHECKOUT DRAWING THROUGH THE SID CUSTODIAN FOR THE LATEST REVISION |          |                                                          |        |          |



**SFMTA**

DRAWN BY:  
JH

DATE:  
10/2015

CHECKED BY:  
MV

DATE:  
10/2015

SCALE  
AS SHOWN

SHEET OF SHEETS  
01 OF 01

TRAFFIC SIGNAL INVENTORY DIAGRAM

ALEMANY BLVD AND SILVER AVE

CNN NO:  
21781000

REV NO:  
4